
RASTER\_

PARENT PARCEL: 04-00-011-108-020 & -021


CHILD PARCEL: XX-XX-XXX-XXX

TING POINT: INT. OF CL OF STONEY RIDGE & NORTH LINE OF KEMPH

11-02183-C

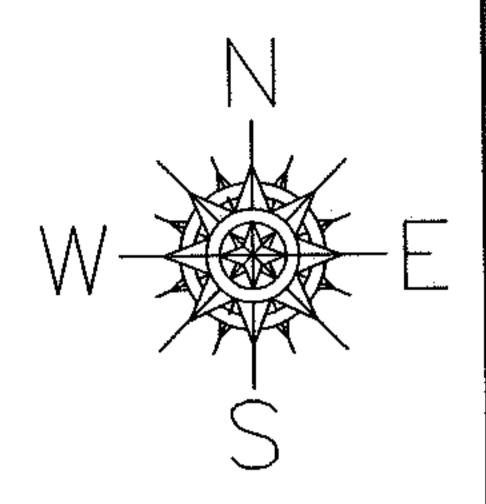

## MAP CORRECTION ONLY

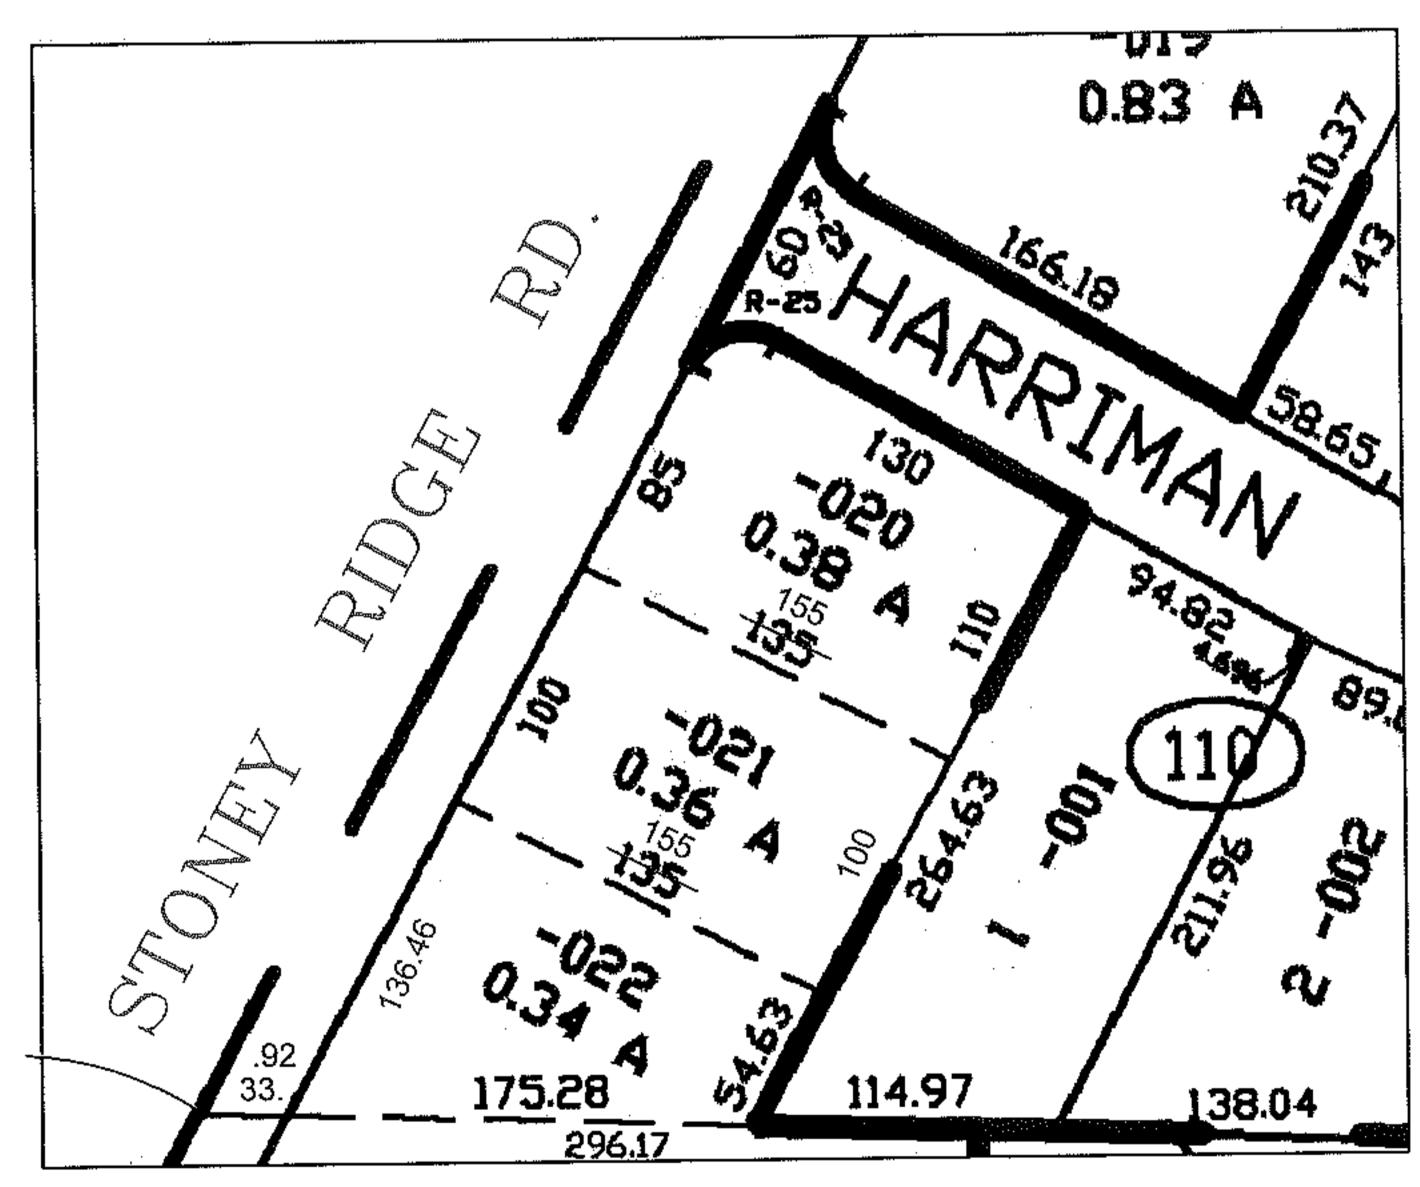

BEGINNING

## SPLITS/DEEDS PROCESSED

LORAIN COUNTY TAX MAP DEPARTMENT 226 MIDDLE AVE. ELYRIA, OHIO

SURVEYED BY: RAY HOLLIS

CLOSURE: 1: 6,000

MAP PAGE(S): 4-00-011-H

APPROVED BY: TJS DATE: 1/6/11

SCALE: 1"= 100 PRIOR INST.: OR 1205/802