

RASTER



PARENT PARCEL: 03-00-113-106-036

CHILD PARCEL: 03-00-113-106-057, -058


STARTING POINT: SIDELINE OF CLIFTON AVE & S/L 75

06-02183

HILL'S ALLOTMENT
VOL 9 PG 22

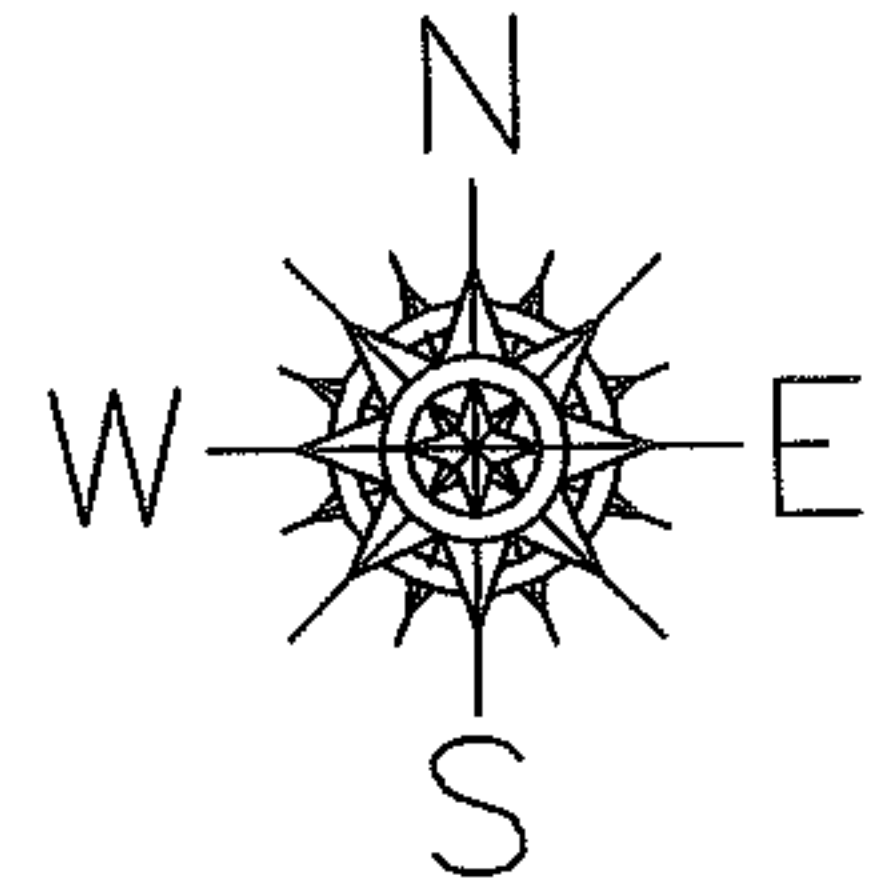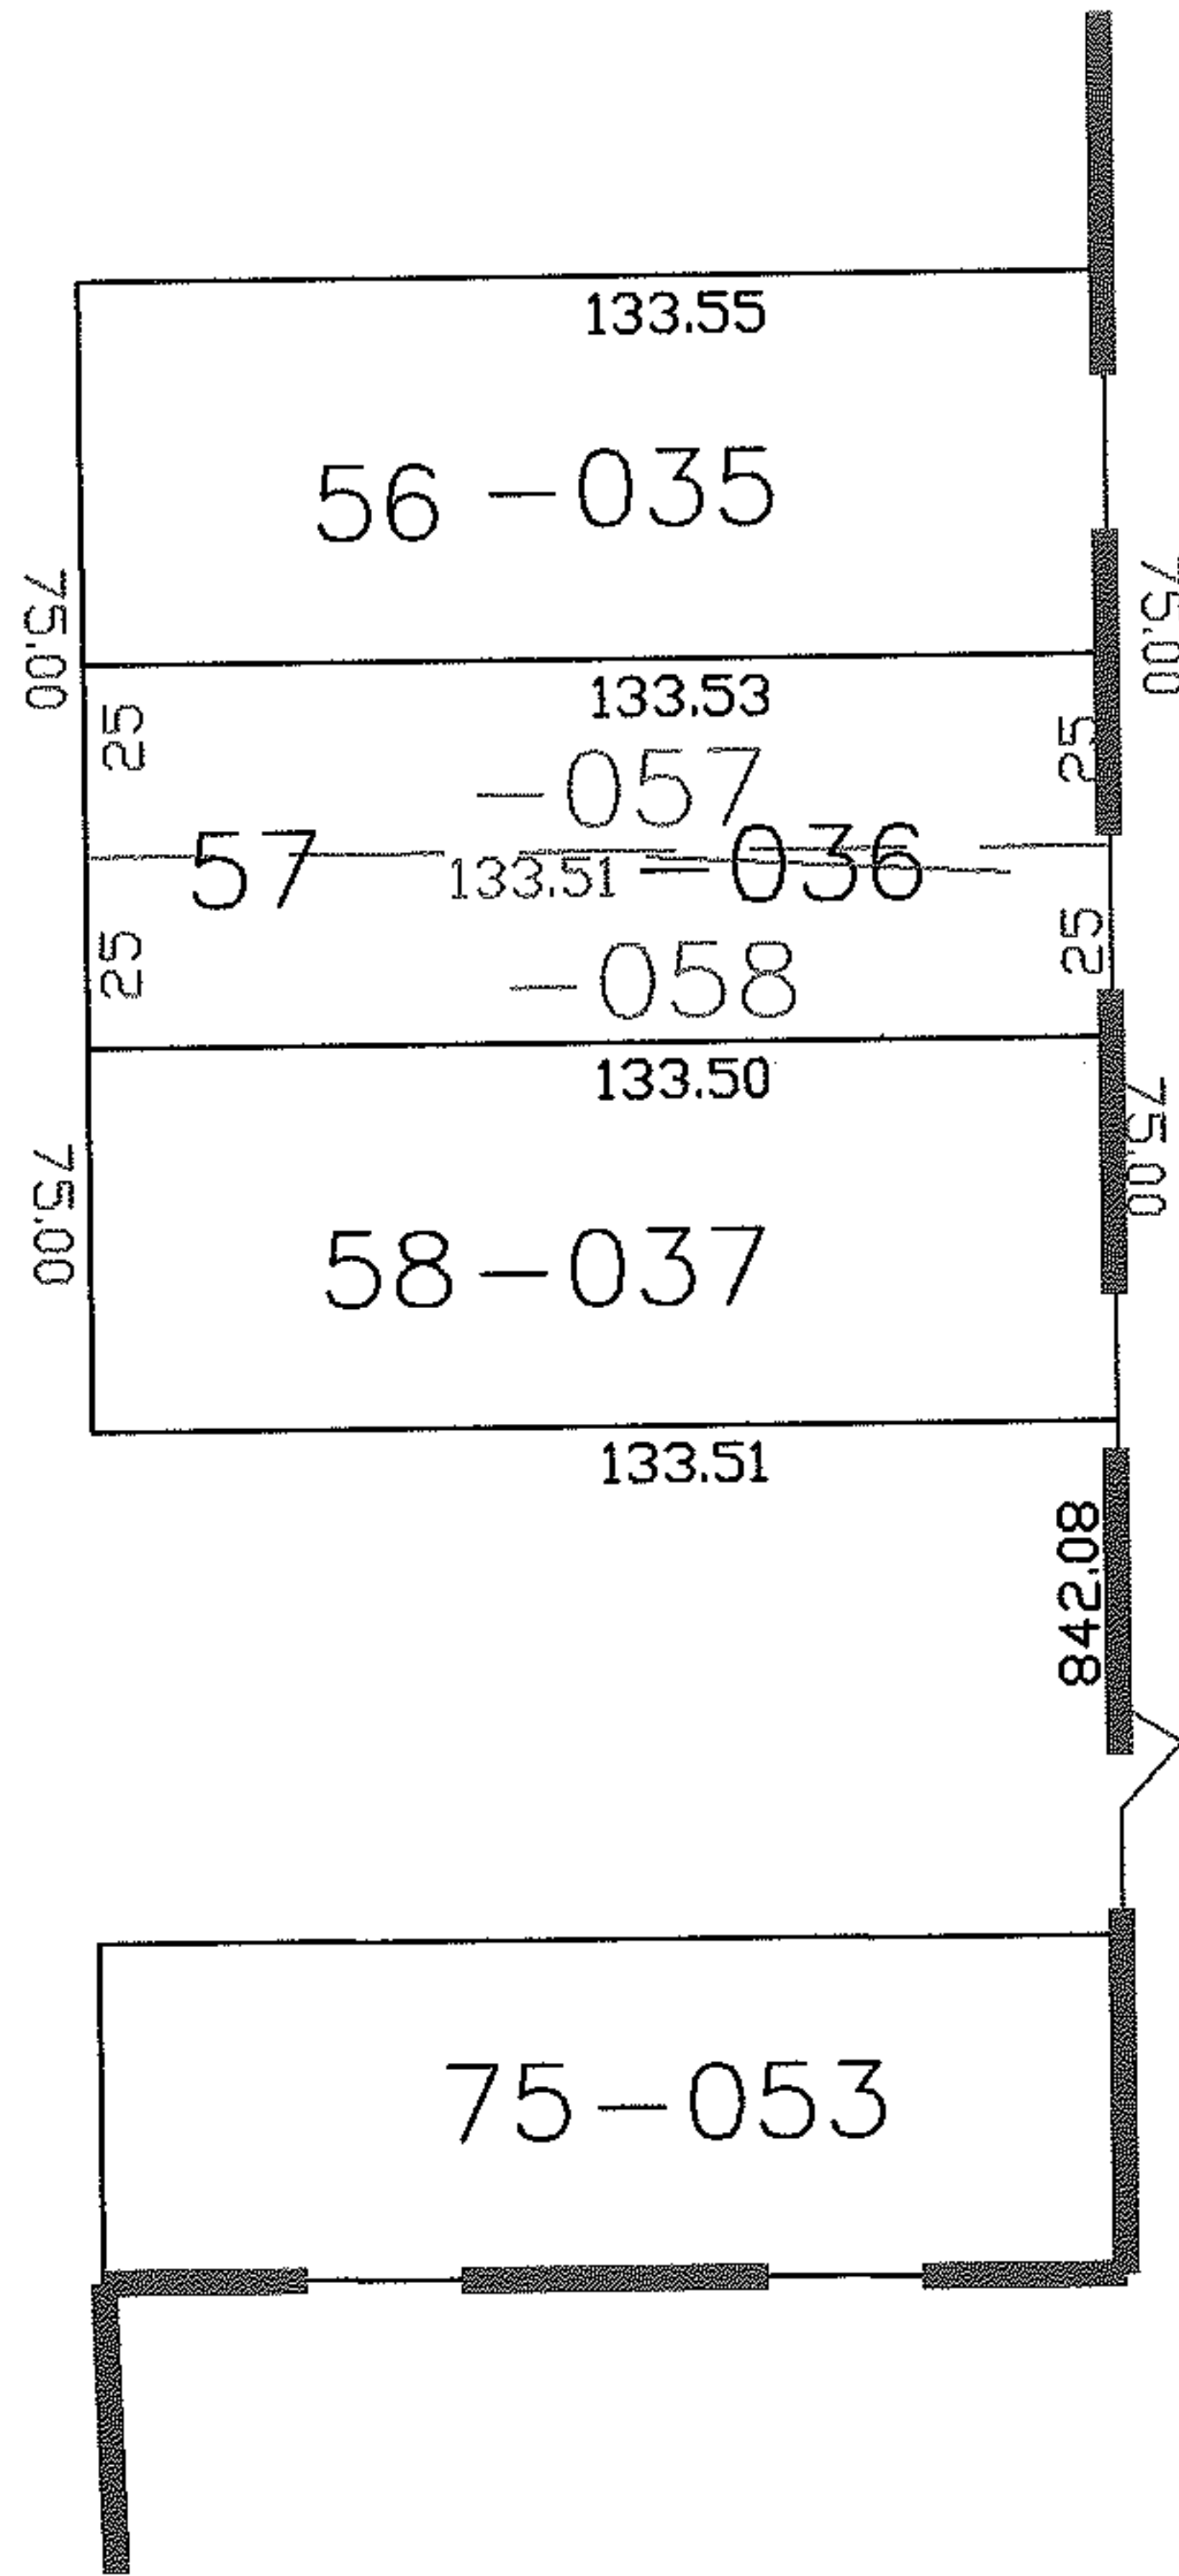

CLIFTON AVE

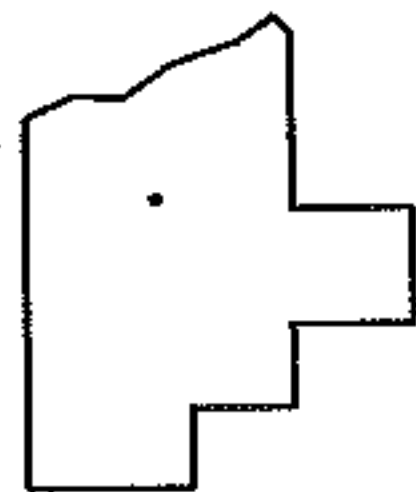

SPLITS/DEEDS PROCESSED
 LORAIN COUNTY TAX MAP DEPARTMENT
 226 MIDDLE AVE. ELYRIA, OHIO

SURVEYED BY: DALE HAYWOOD
 CLOSURE: 0.00 : 10.000
 MAP PAGE(S): 03-00-113
 APPROVED BY: JAH DATE: 9-14-06
 SCALE: 1" = 100 PRIOR INSTRUMENT: PL VL 9/22