

RASTER

PARENT PARCEL: 04-00-014-106-029
CHILD PARCEL: XX-XX-XXX-XXX-XXX
STARTING POINT: MON. BOX, CL OF SADDLE CREEK & CL OF EMORY DR.

11-02188-C


FRONTAGE & DEPTH CORR.

04-00-014-106-029


~~100.00 X 162.28~~

100.00 X 162.20

CORR. PER SURV.
EDWARD B. DUDLEY III

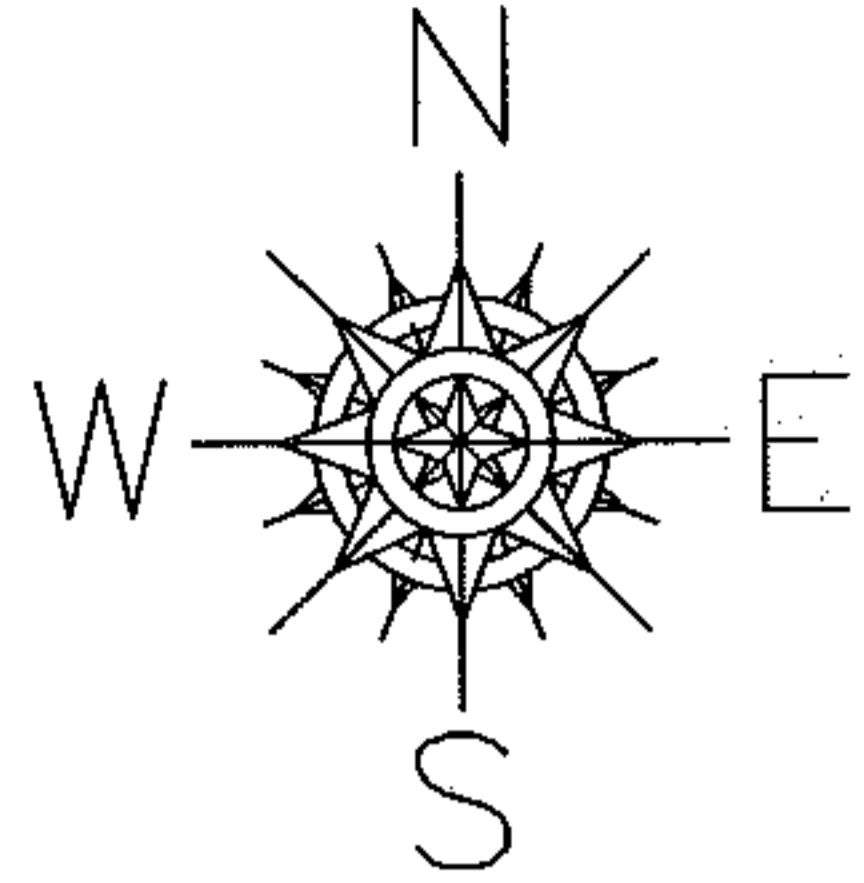

EMORY DR. 60'

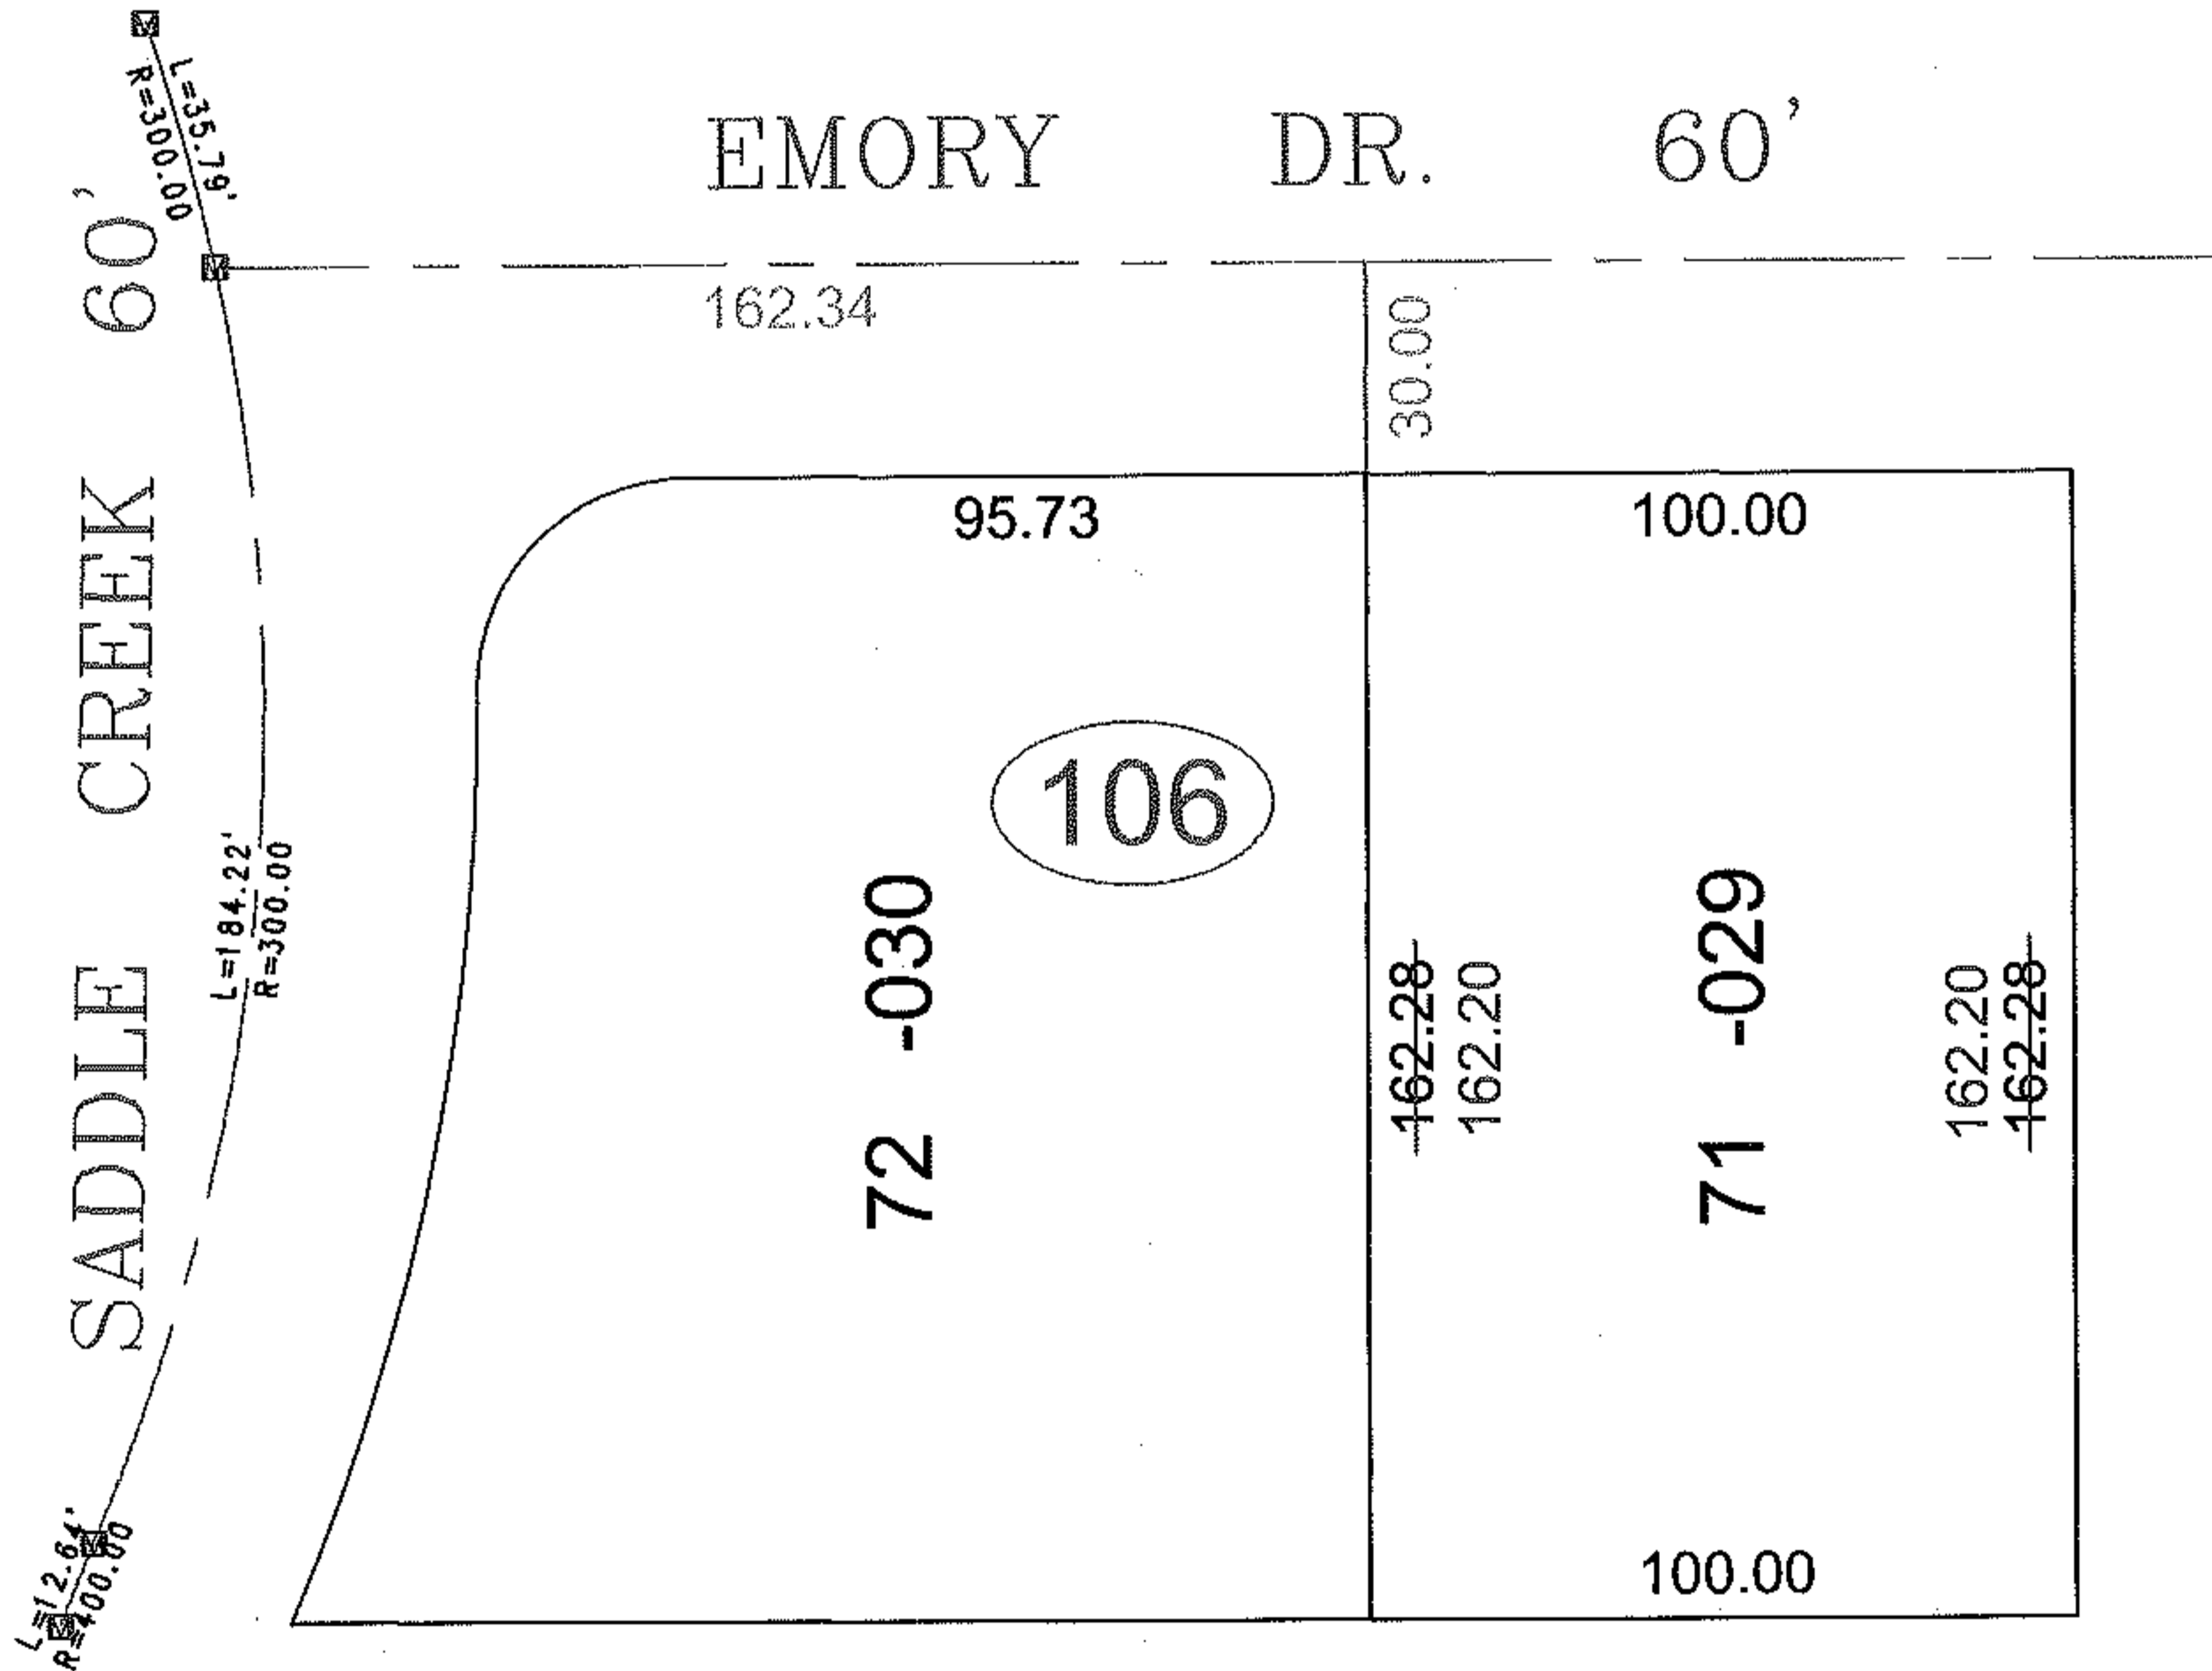

SADDLE CREEK 60'

L=12.84'
R=100.00'

L=184.22'
R=300.00'

162.34

30.00

95.73

100.00

106


72 -030

~~162.28~~
162.20

71 -029

162.20
~~162.28~~

100.00

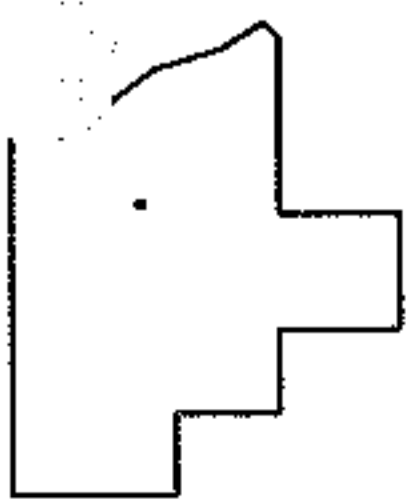

SPLITS/DEEDS PROCESSED

LORAIN COUNTY TAX MAP DEPARTMENT
226 MIDDLE AVE. ELYRIA, OHIO

SURVEYED BY: EDWARD B. DUDLEY III
CLOSURE: 0.00: 10.000
MAP PAGE(S): 4-00-014-D
APPROVED BY: TJS DATE: 1/7/11
SCALE: 1"= 50' PRIOR INST.: 20100354129