



RASTER

PARENT PARCEL: 06-24-109-000-011

11-02189-D


CHILD PARCEL: _____

STARTING POINT: NORTHEAST R.O.W. LINE OF WEST RIVER RD., 36.64 FT SOUTHEAST FROM
SOUTHWEST CORNER OF S/L 6 IN JOSHUA BOYNTON'S SUB.(VOL.2 PG.9)

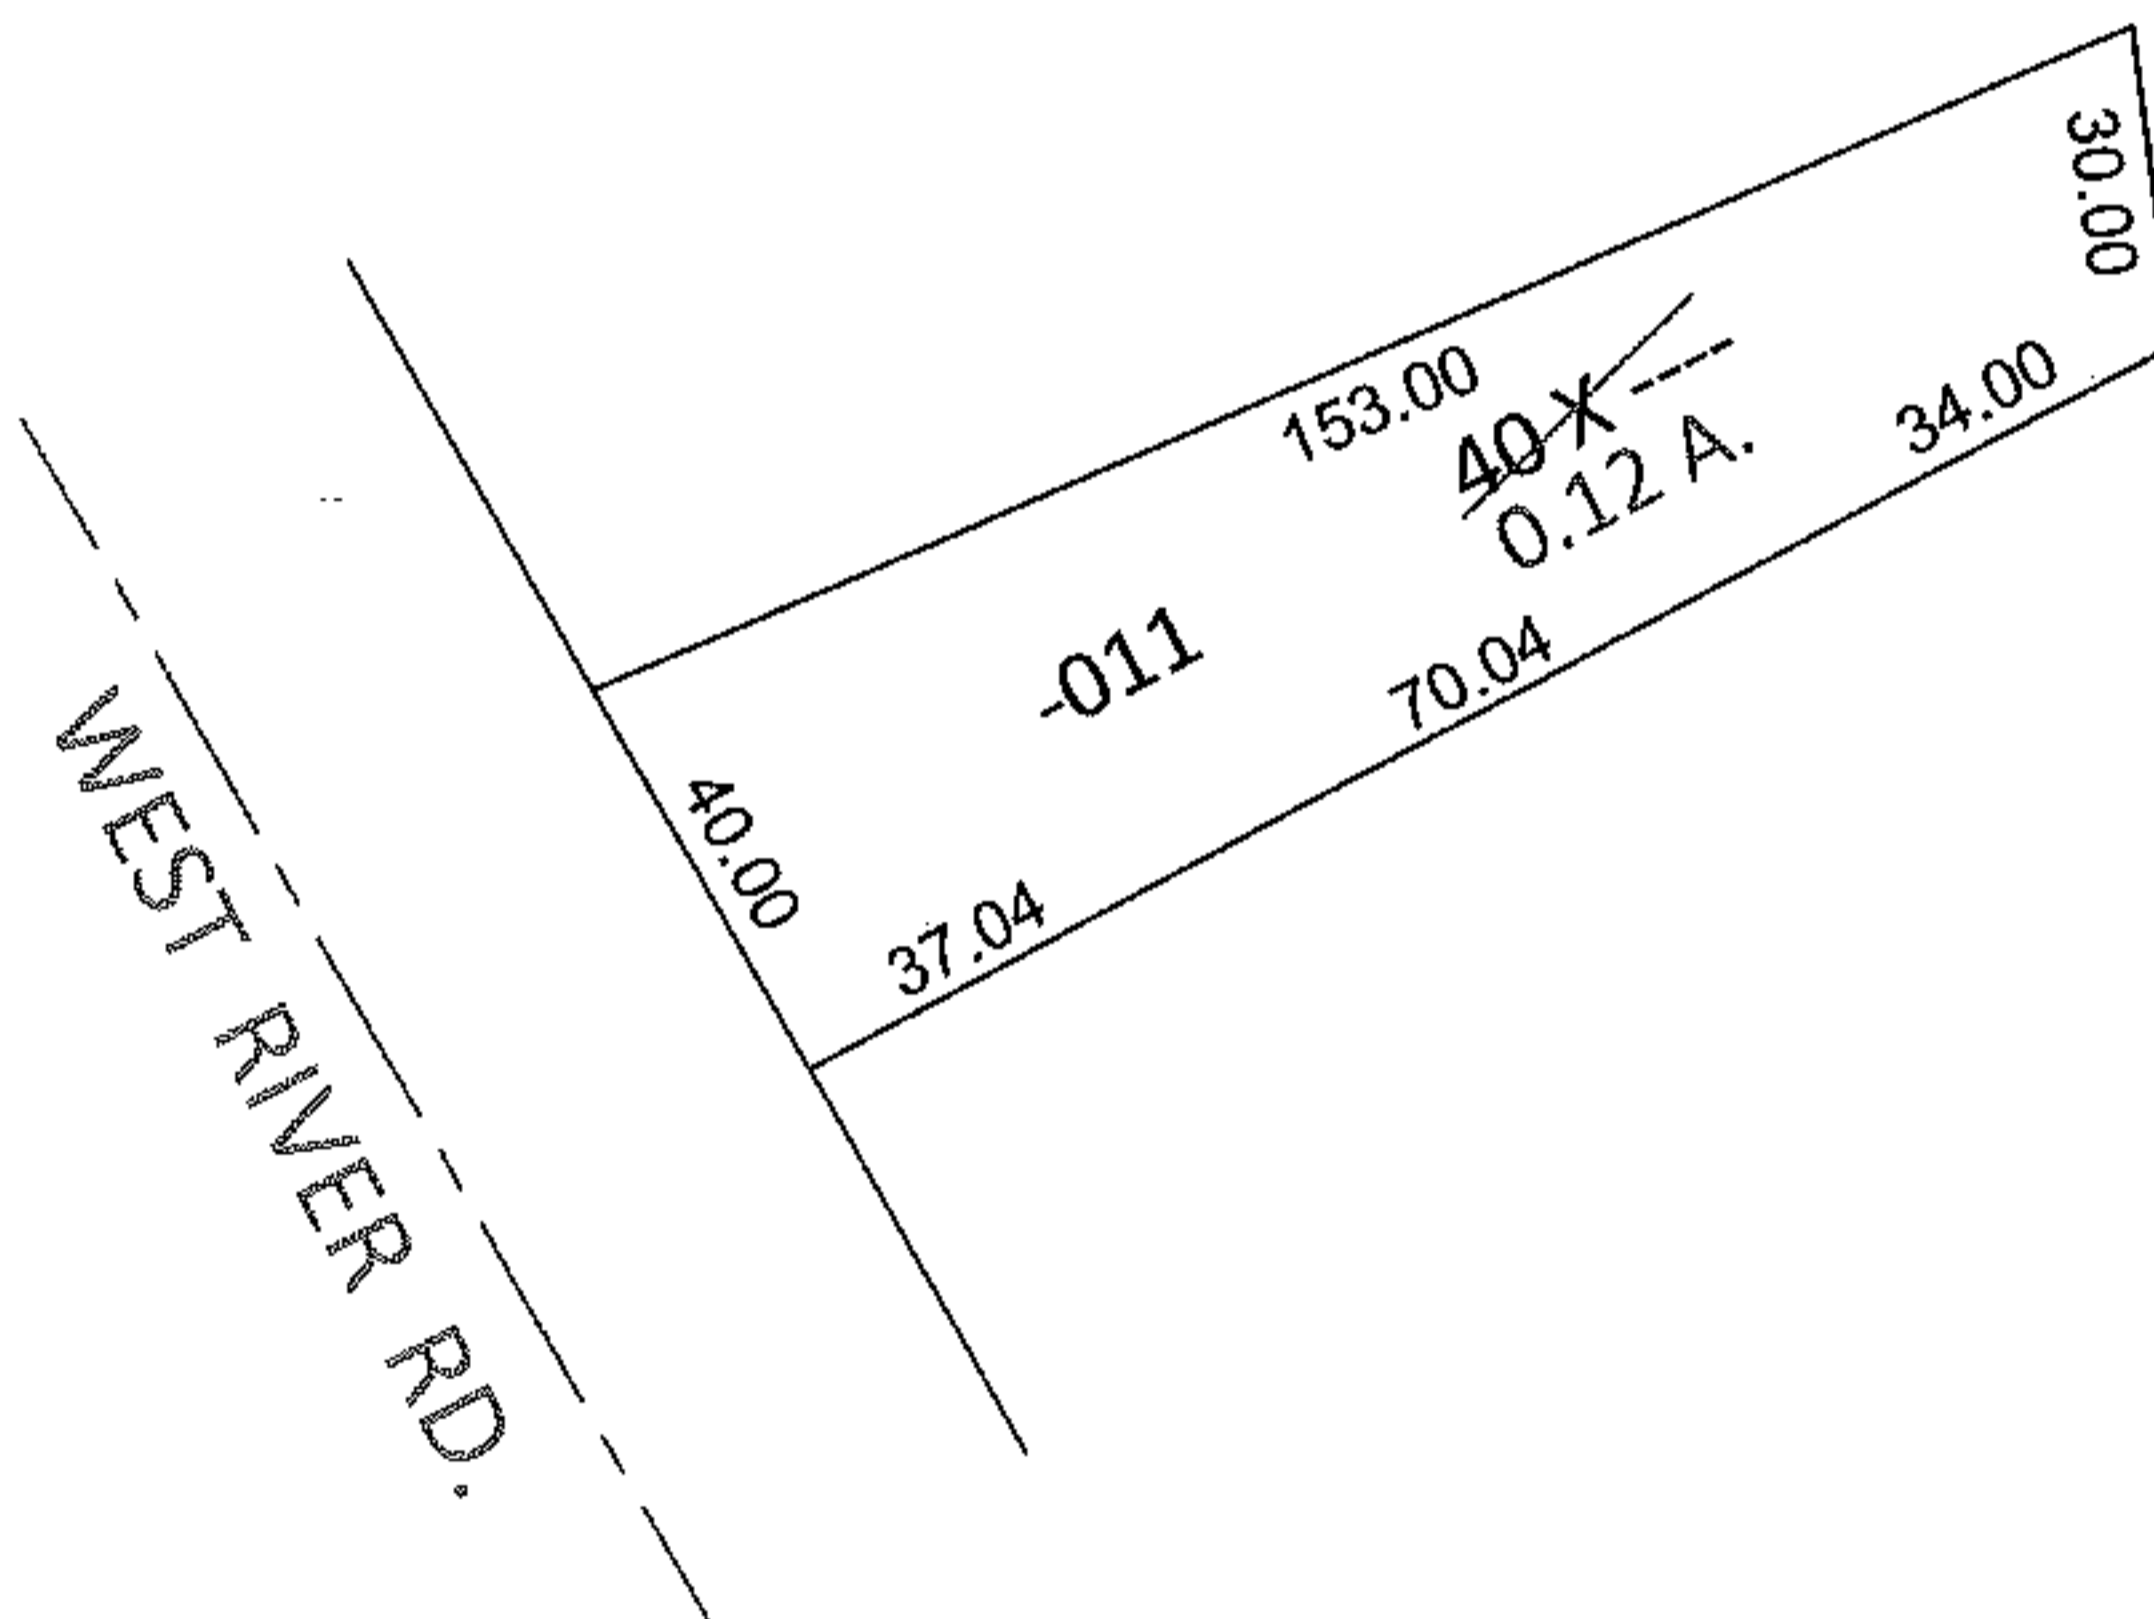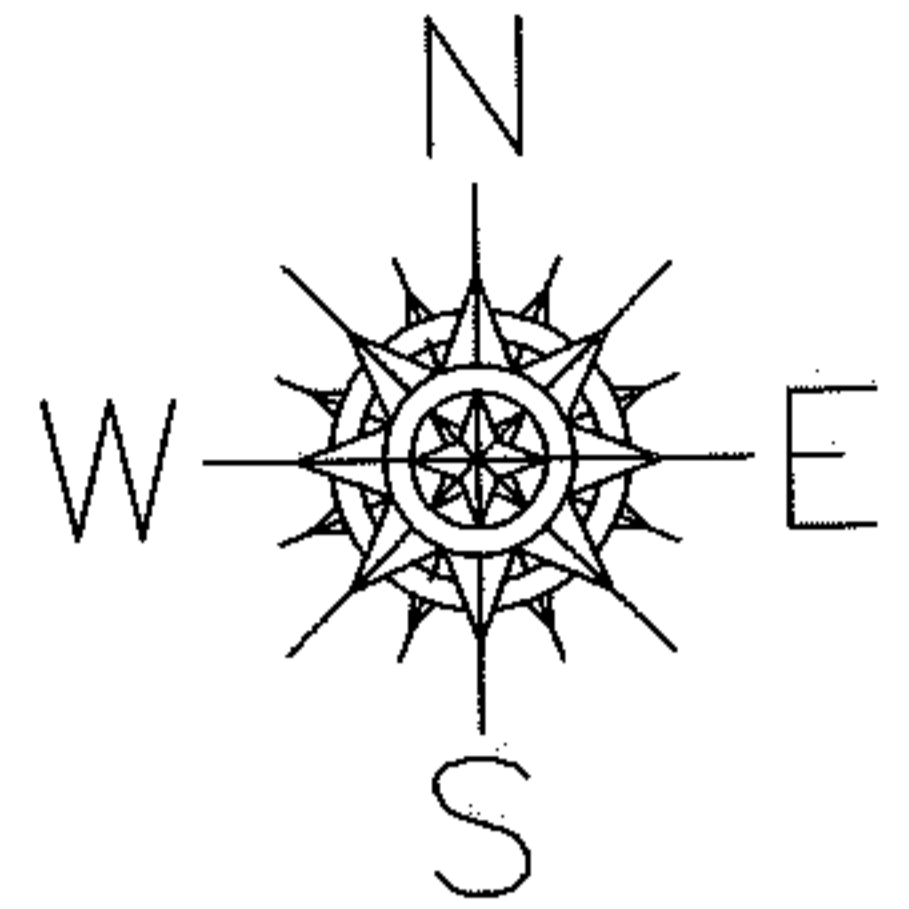

FRONTAGE AND DEPTH CORRECTED TO ACERAGE

PER PRIOR DEEDS
DV 1227/977
OR 348/90
20030916407

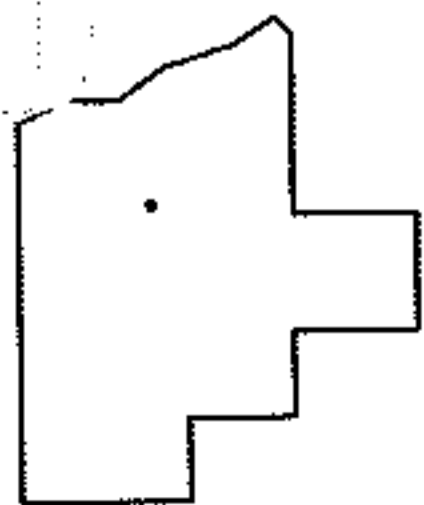

SPLITS/DEEDS PROCESSED

LORAIN COUNTY TAX MAP DEPARTMENT
226 MIDDLE AVE. ELYRIA, OHIO

SURVEYED BY: N/A
CLOSURE: N/A
MAP PAGE(S): 6-118
APPROVED BY: RRM DATE: 1-7-11
SCALE: 1"=50' PRIOR INST.: SEE ABOVE