




RASTER

PARENT PARCEL: 04-00-005-700-001

CHILD PARCEL: 04-00-005-700-002, -003

STARTING POINT: CENTERLINE OF MILLER RD & WALKER RD

06-02190

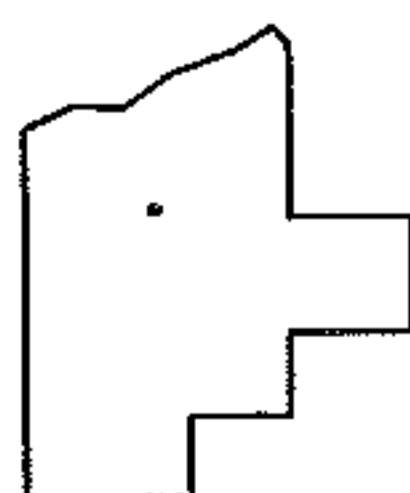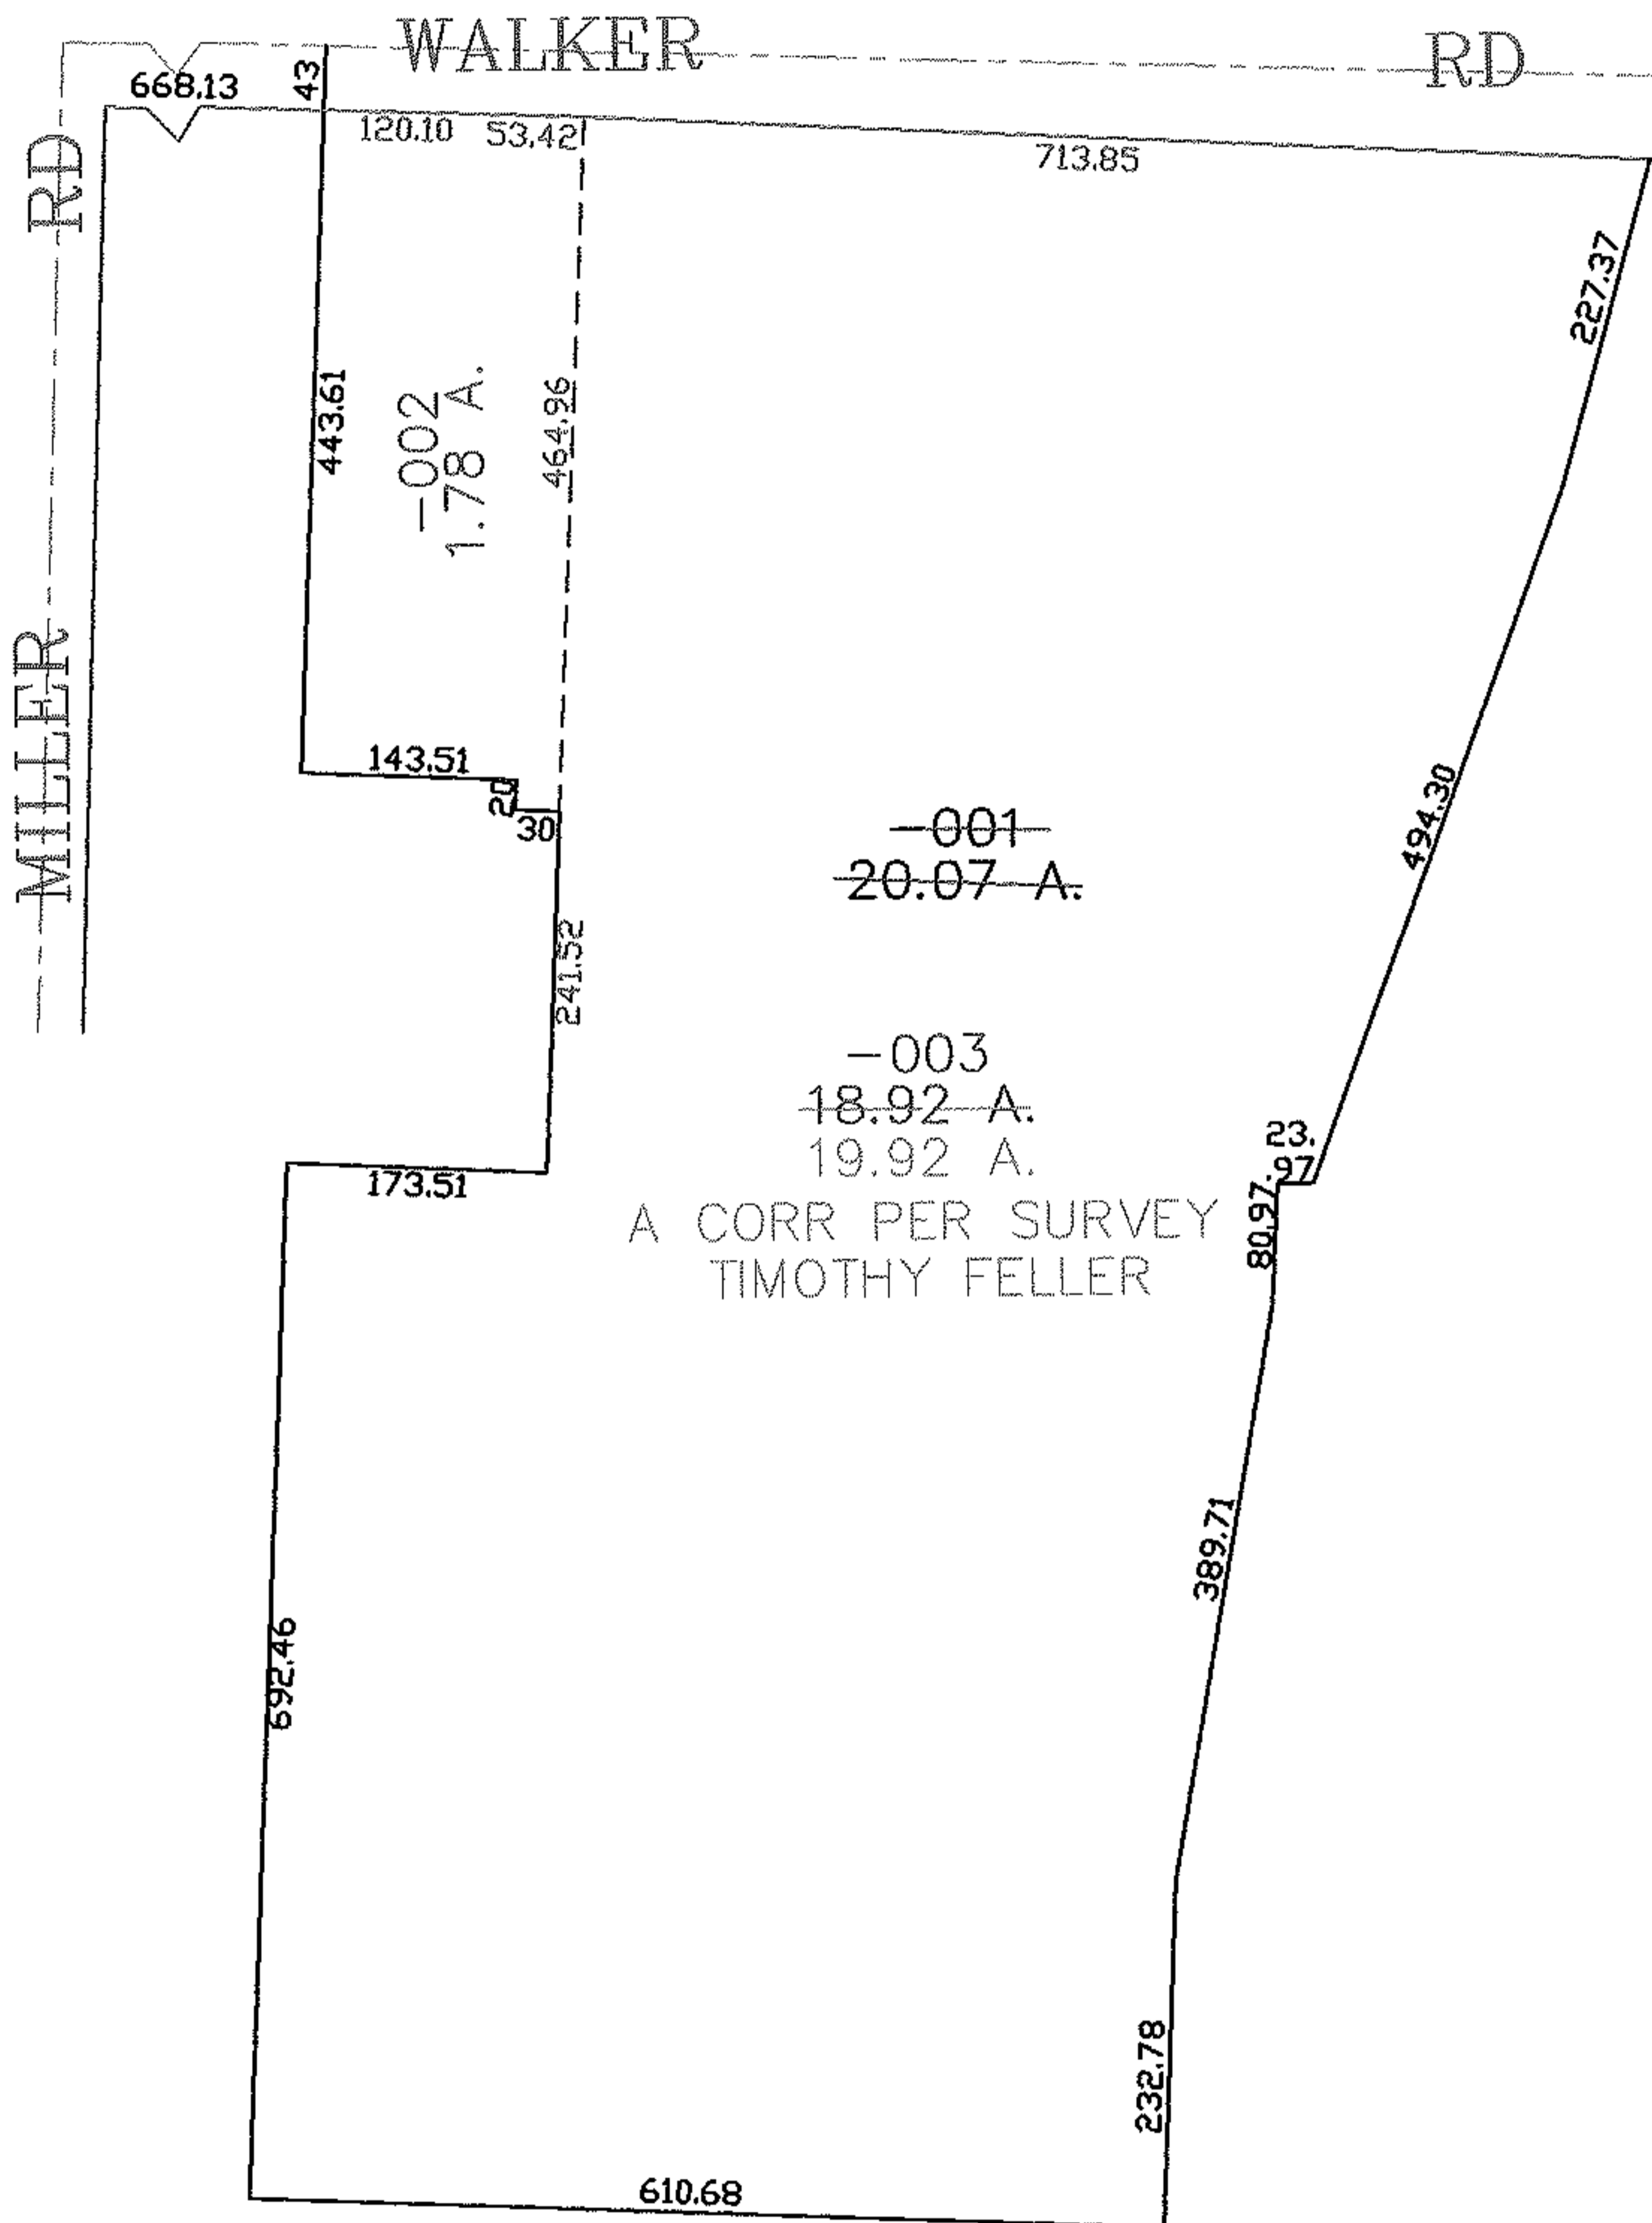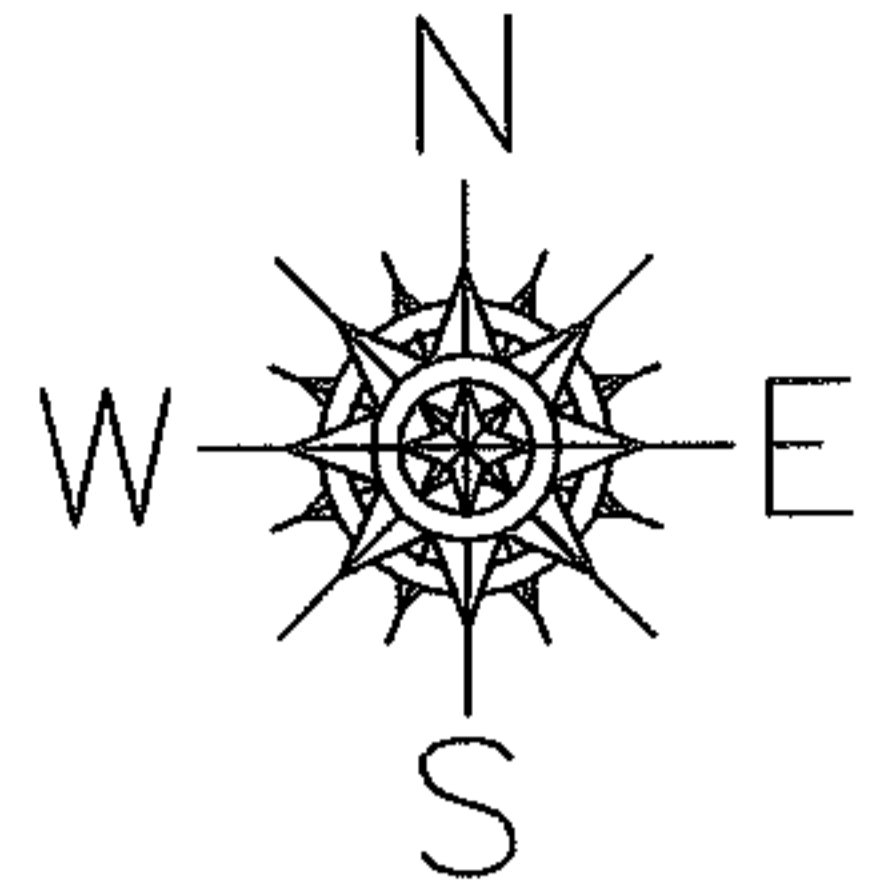

SPLITS/DEEDS PROCESSED
 LORAIN COUNTY TAX MAP DEPARTMENT
 226 MIDDLE AVE. ELYRIA, OHIO

SURVEYED BY: TIMOTHY FELLER
 CLOSURE: 0.00 : 10.000
 MAP PAGE(S): 04-00-005-B
 APPROVED BY: JAH DATE: 7-25-06
 SCALE: 1" = 200 PRIOR INSTRUMENT: 20050110160