




RASTER

PARENT PARCEL: 04-00-021-000-180

CHILD PARCEL: 04-00-021-000-234, -235

STARTING POINT: CENTERLINE OF NAGEL RD & LEAR INDUSTRIAL PKWY

06-02191

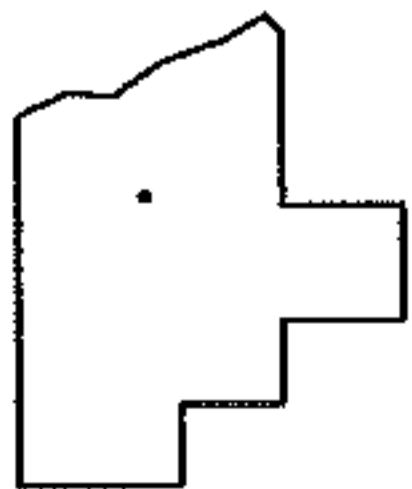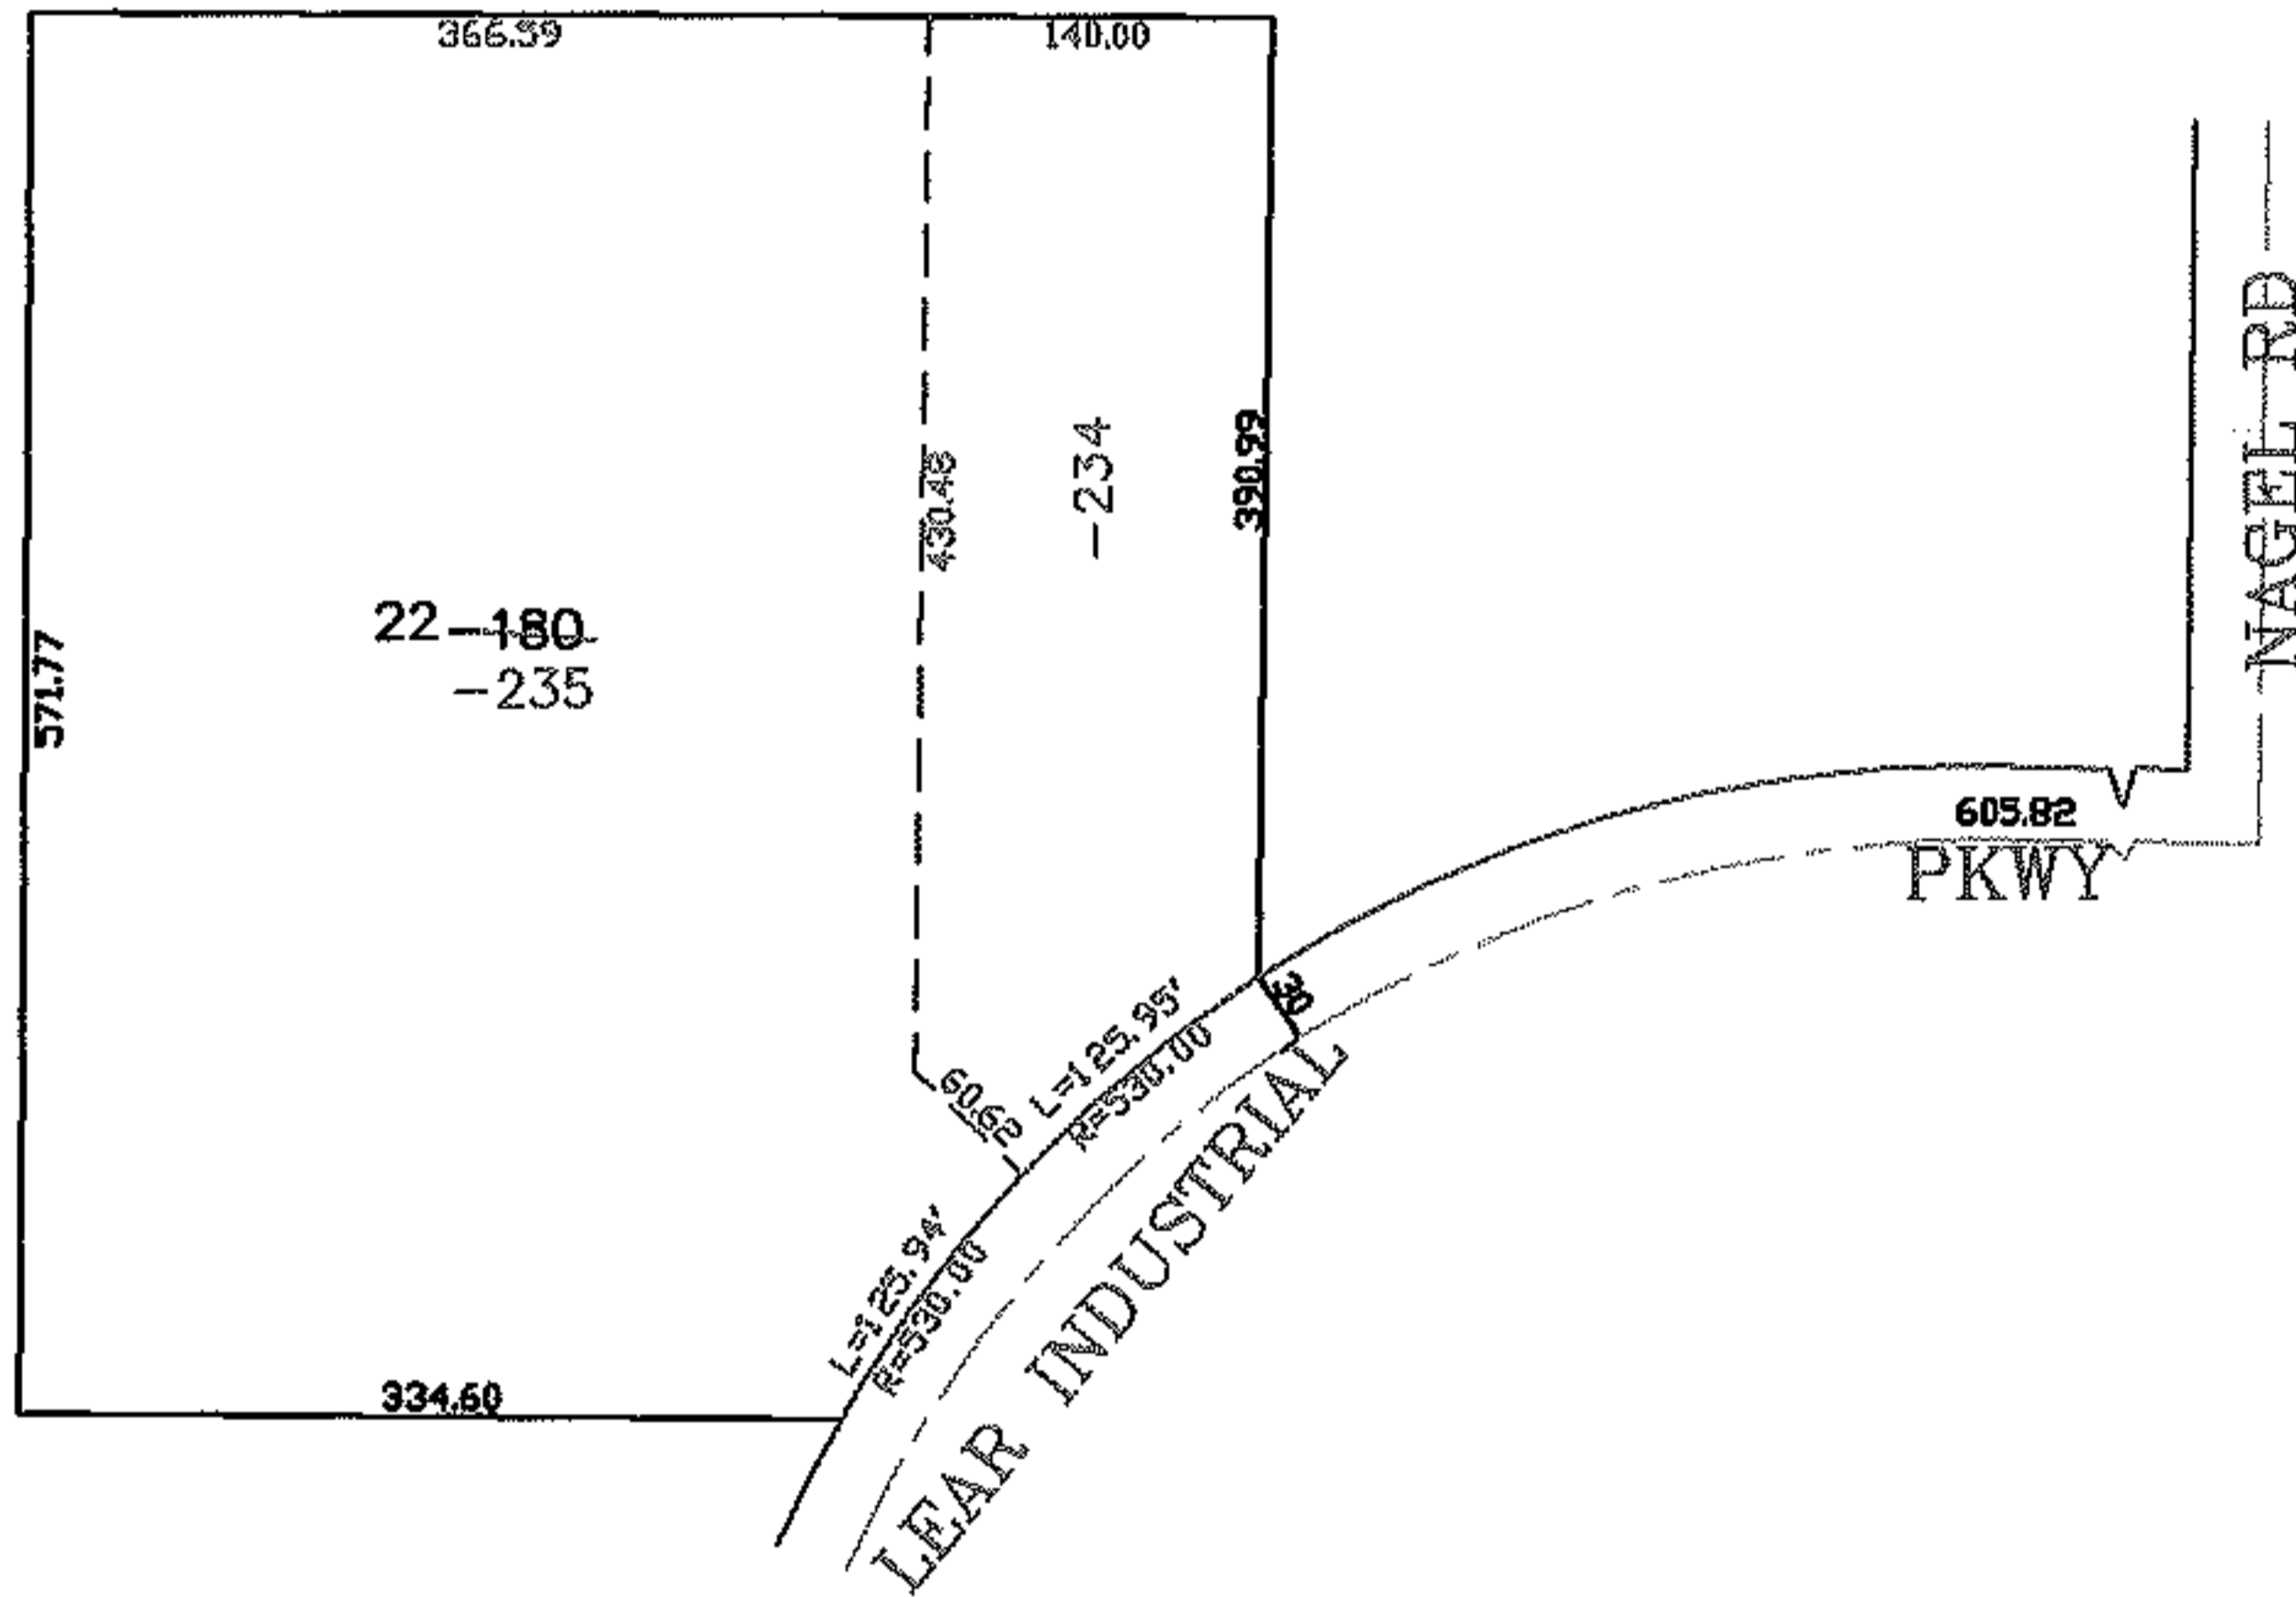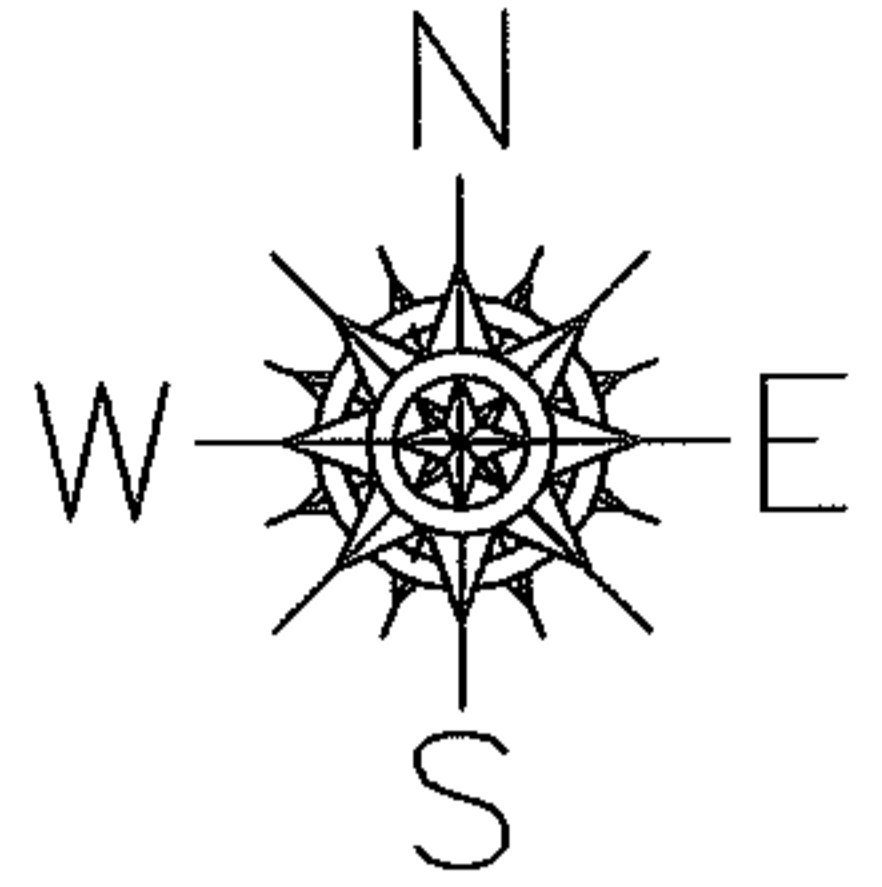

SPLITS/DEEDS PROCESSED

LORAIN COUNTY TAX MAP DEPARTMENT
226 MIDDLE AVE. ELYRIA, OHIO

SURVEYED BY: DANIEL LAUX
CLOSURE: 0.00 : 10,000
MAP PAGE(S): 04-00-021-D
APPROVED BY: JAH DATE: 7-26-06
SCALE: 1" = 200' PRIOR INSTRUMENT: PL VOL 47/63