
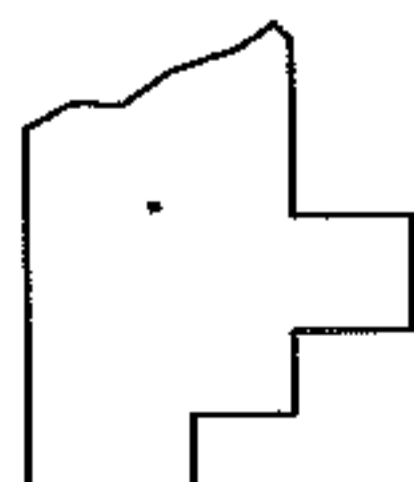
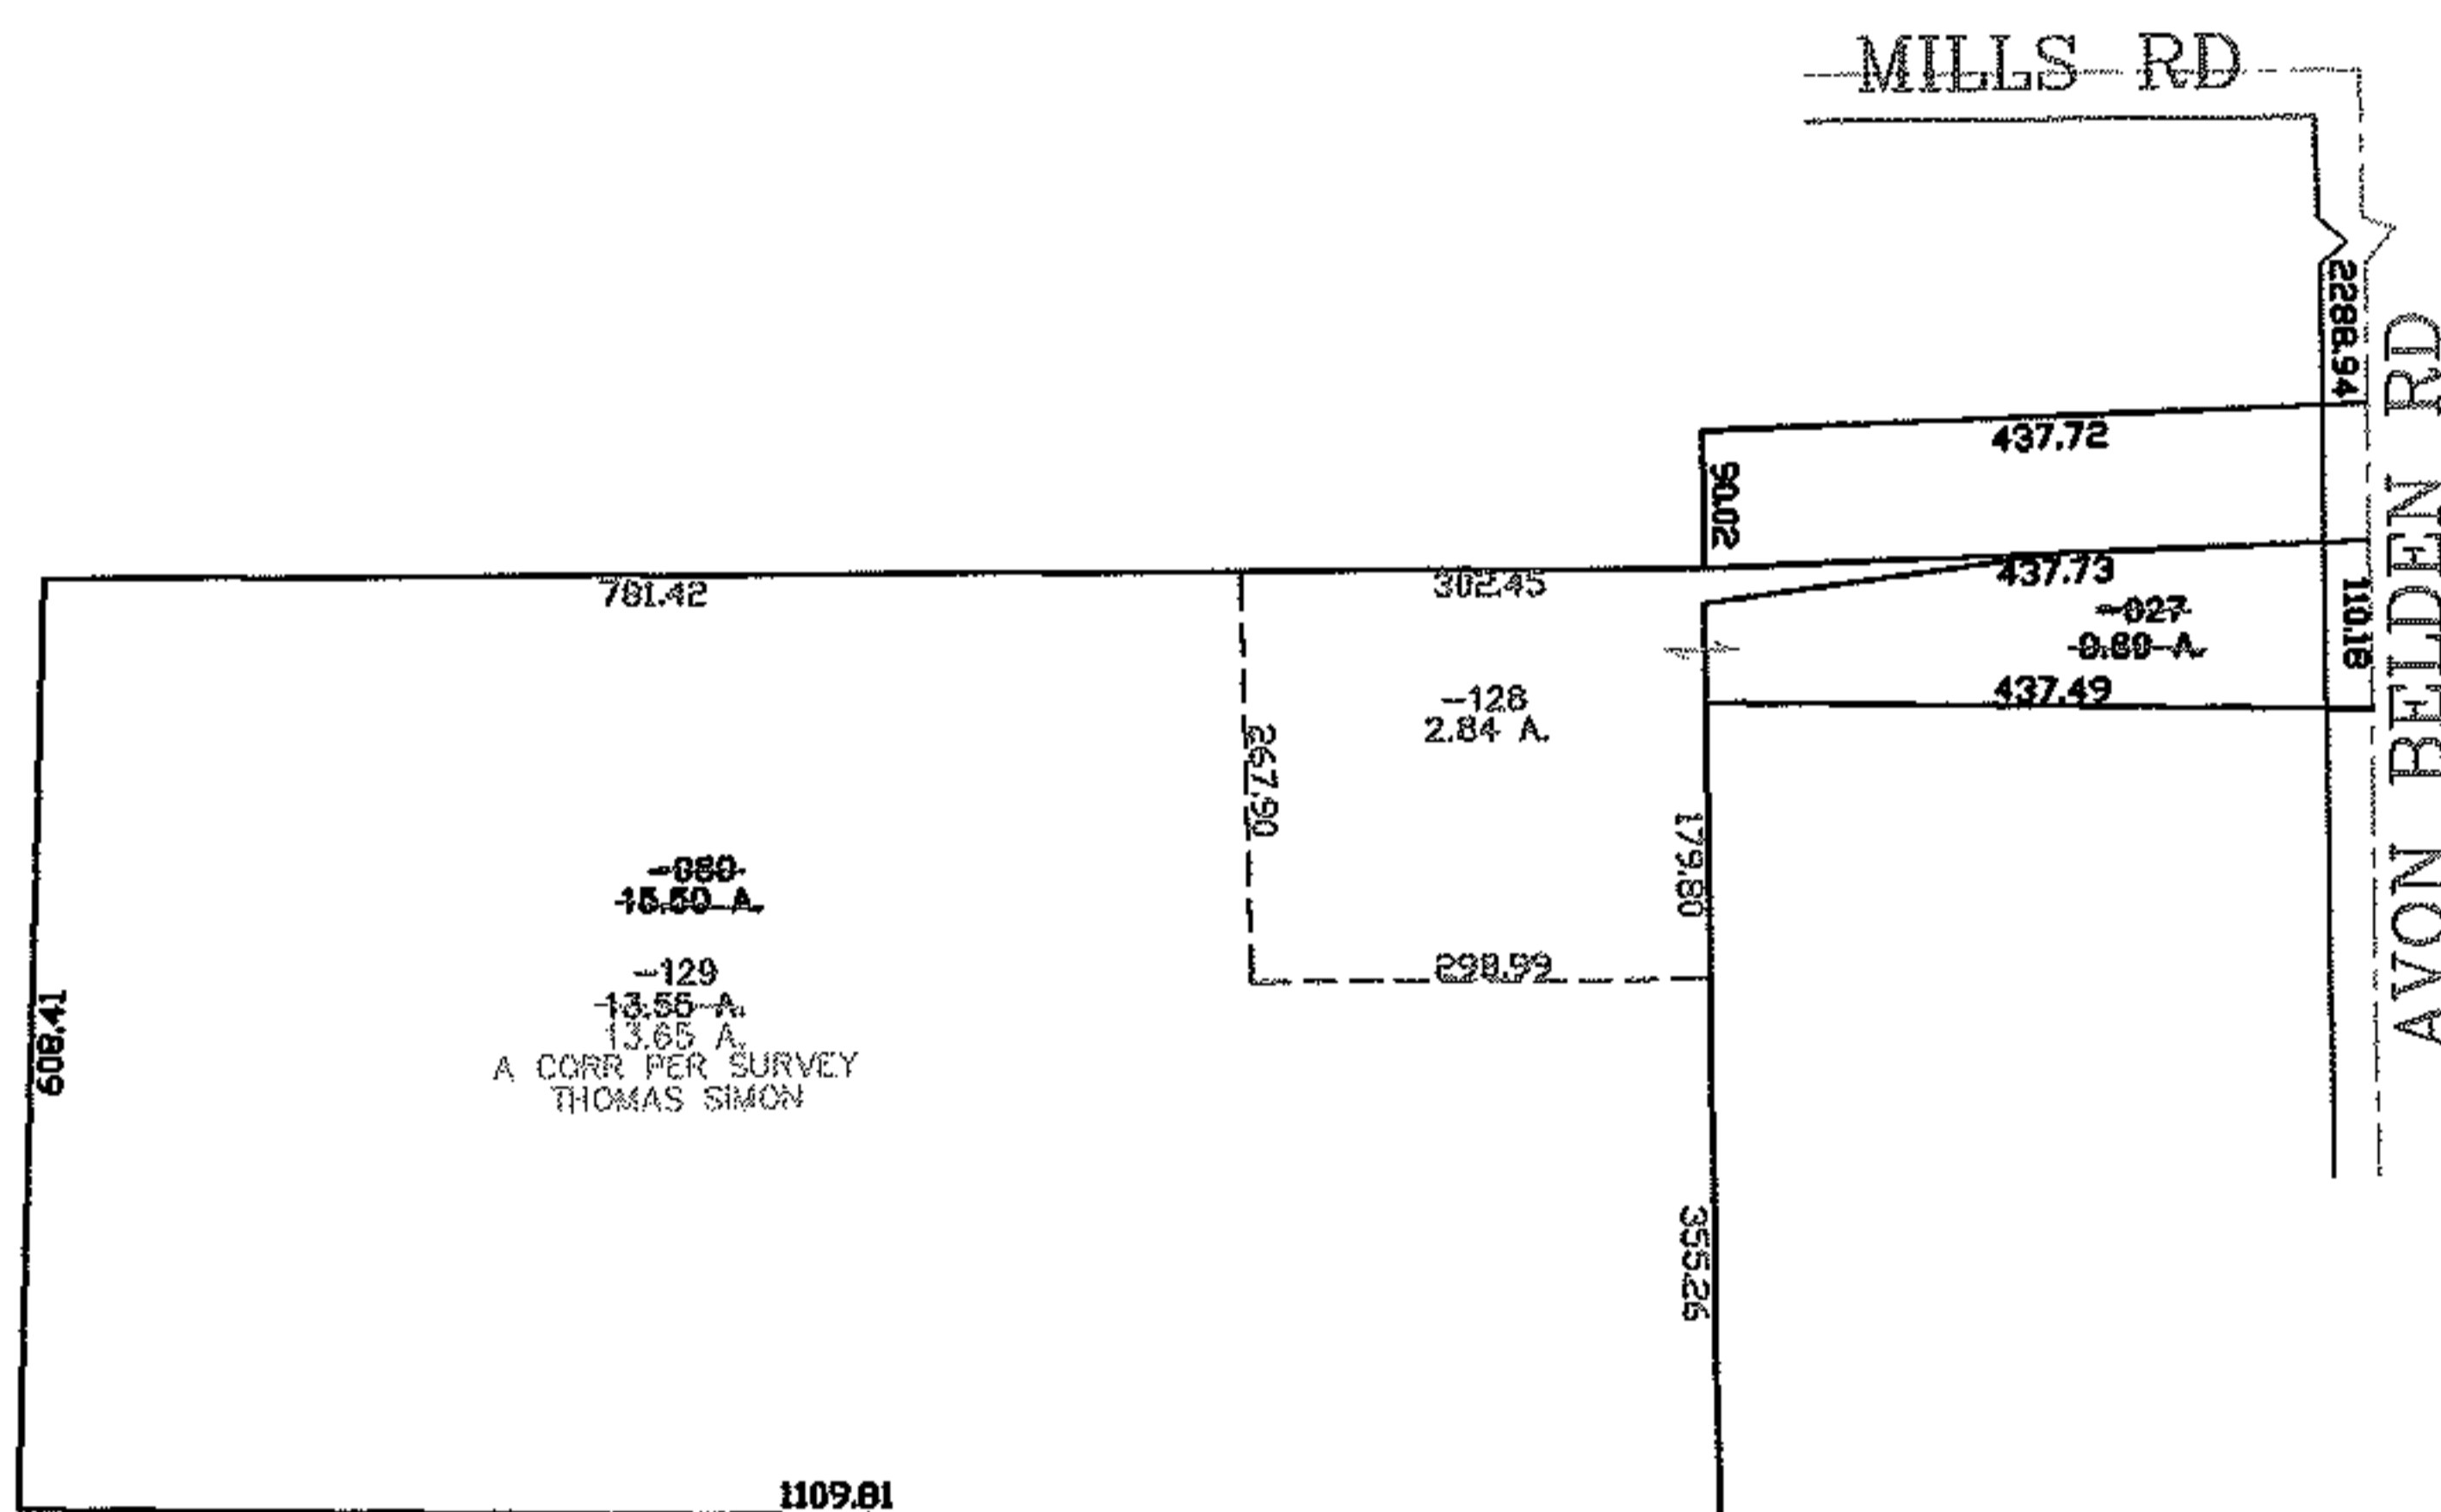


PARENT PARCEL: 07-00-030-000-080, -027

CHILD PARCEL: 07-00-030-000-128, -129

STARTING POINT: CENTERLINE OF AVON BELDEN RD & MILLS RD

06-02193

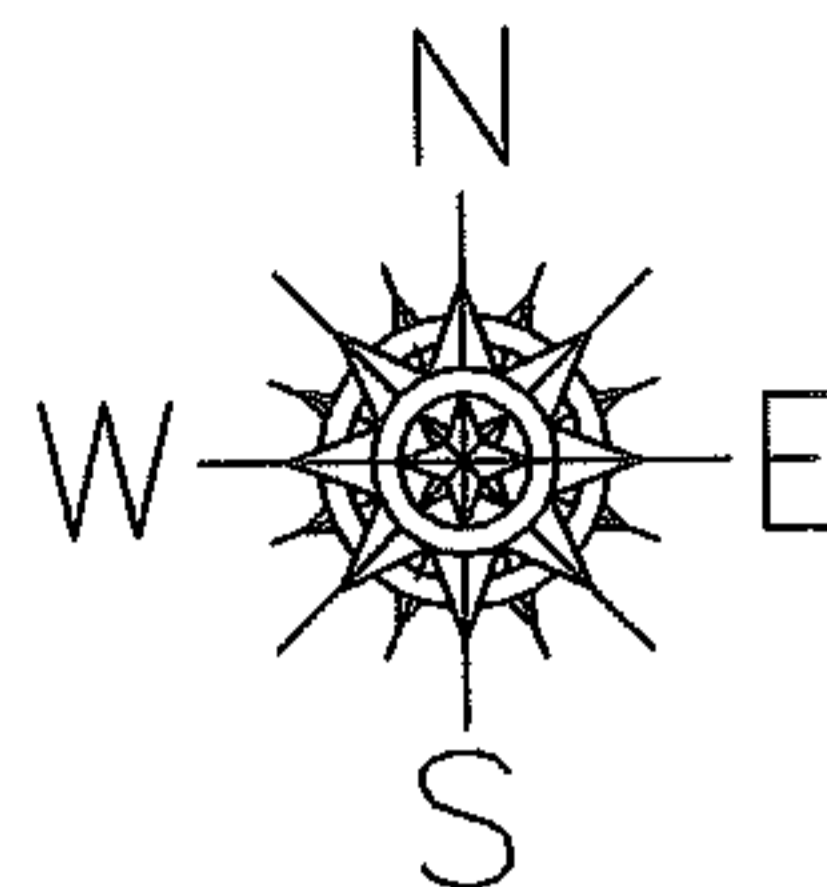

SPLITS/DEEDS PROCESSED
 LORAIN COUNTY TAX MAP DEPARTMENT
 226 MIDDLE AVE. ELYRIA, OHIO

SURVEYED BY: THOMAS SIMON
 CLOSURE: 0.00 : 10.000
 MAP PAGE(S): 07-00-030-D
 APPROVED BY: JAH DATE: 7-26-06
 SCALE: 1" = 300 PRIOR INSTRUMENT: 20020867909