
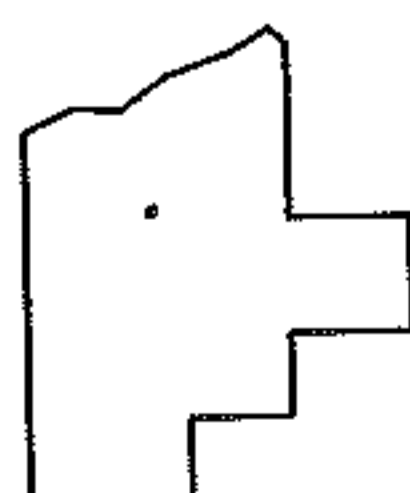
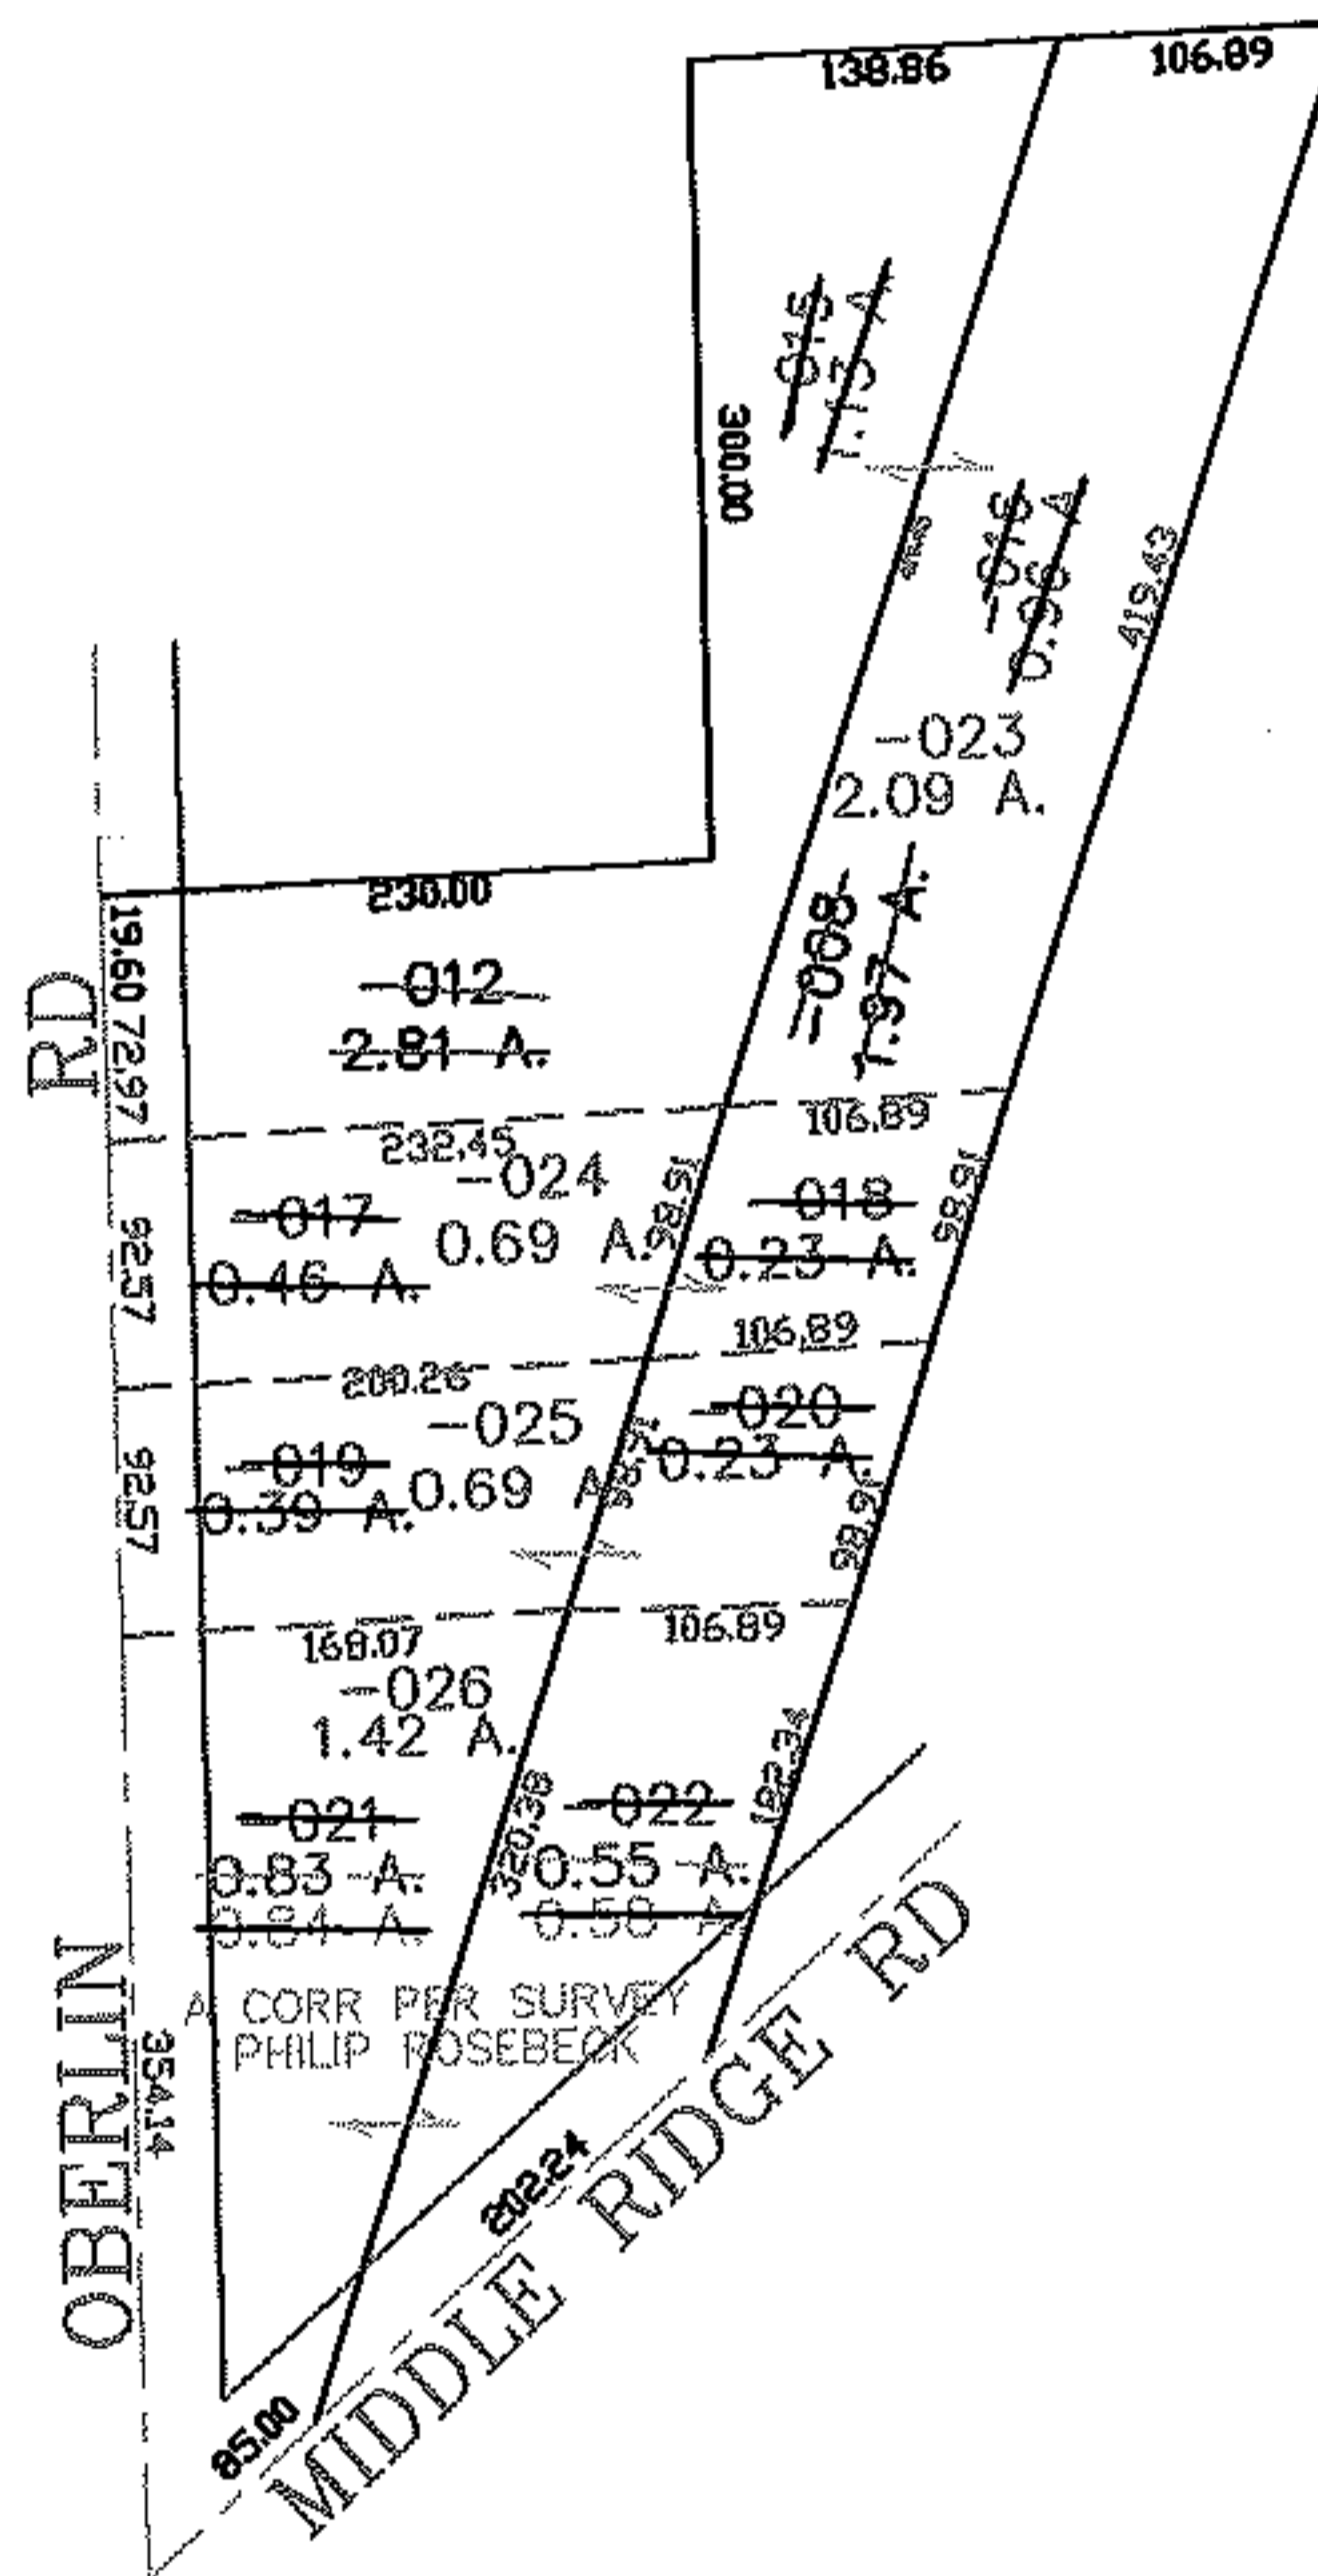


PARENT PARCEL: 05-00-063-103-008, -012

06-02197

CHILD PARCEL: 05-00-063-103-015 THRU -026

STARTING POINT: CENTERLINE OF OBERLIN RD & MURRAY RIDGE RD

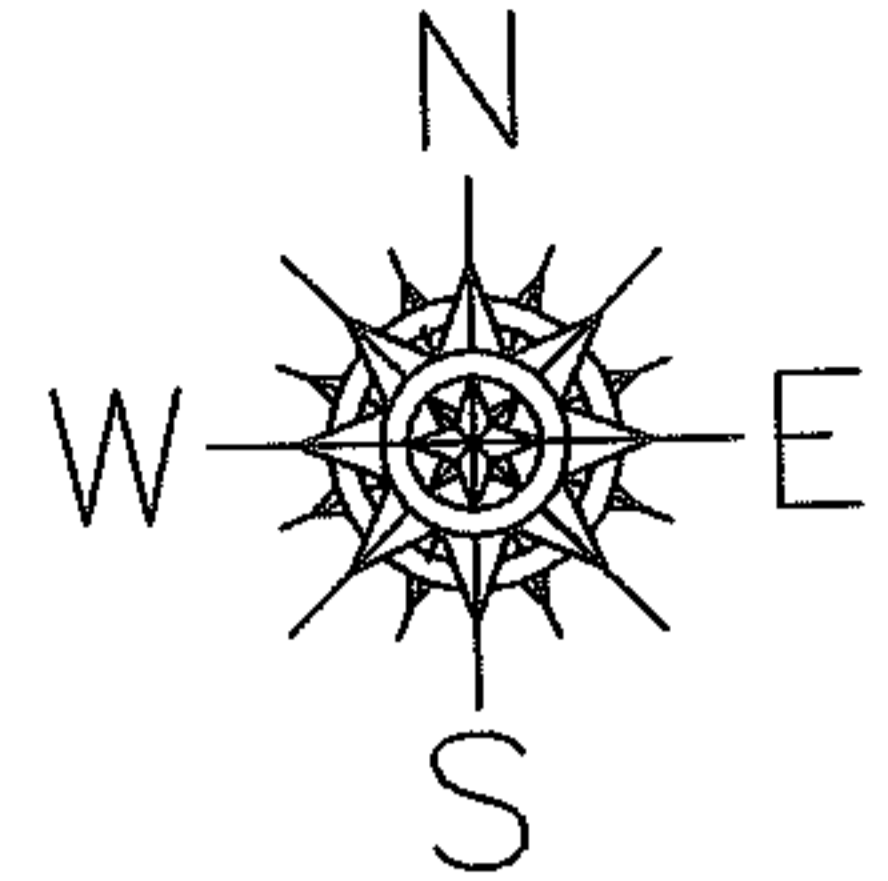

SPLITS/DEEDS PROCESSED
LORAIN COUNTY TAX MAP DEPARTMENT
226 MIDDLE AVE. ELYRIA, OHIO

SURVEYED BY: PHILIP ROSEBECK
CLOSURE: 0.00 : 10.000
MAP PAGE(S): 05-00-063-B
APPROVED BY: JAH DATE: 8-3-06
SCALE: 1" = 200' PRIOR INSTRUMENT: 20040024212