




RASTER

PARENT PARCEL: 07-00-035-102-099

CHILD PARCEL: 07-00-035-102-101, -102

STARTING POINT: CENTERLINE OF SUGAR RIDGE RD & RACE RD

06-02198

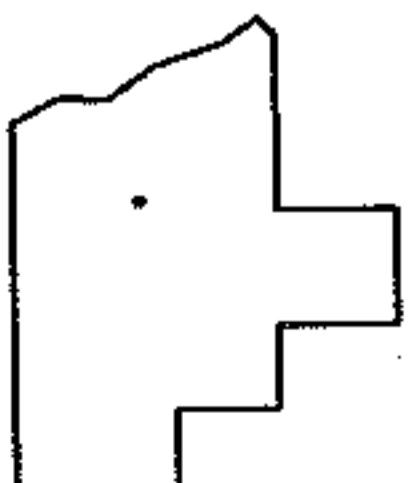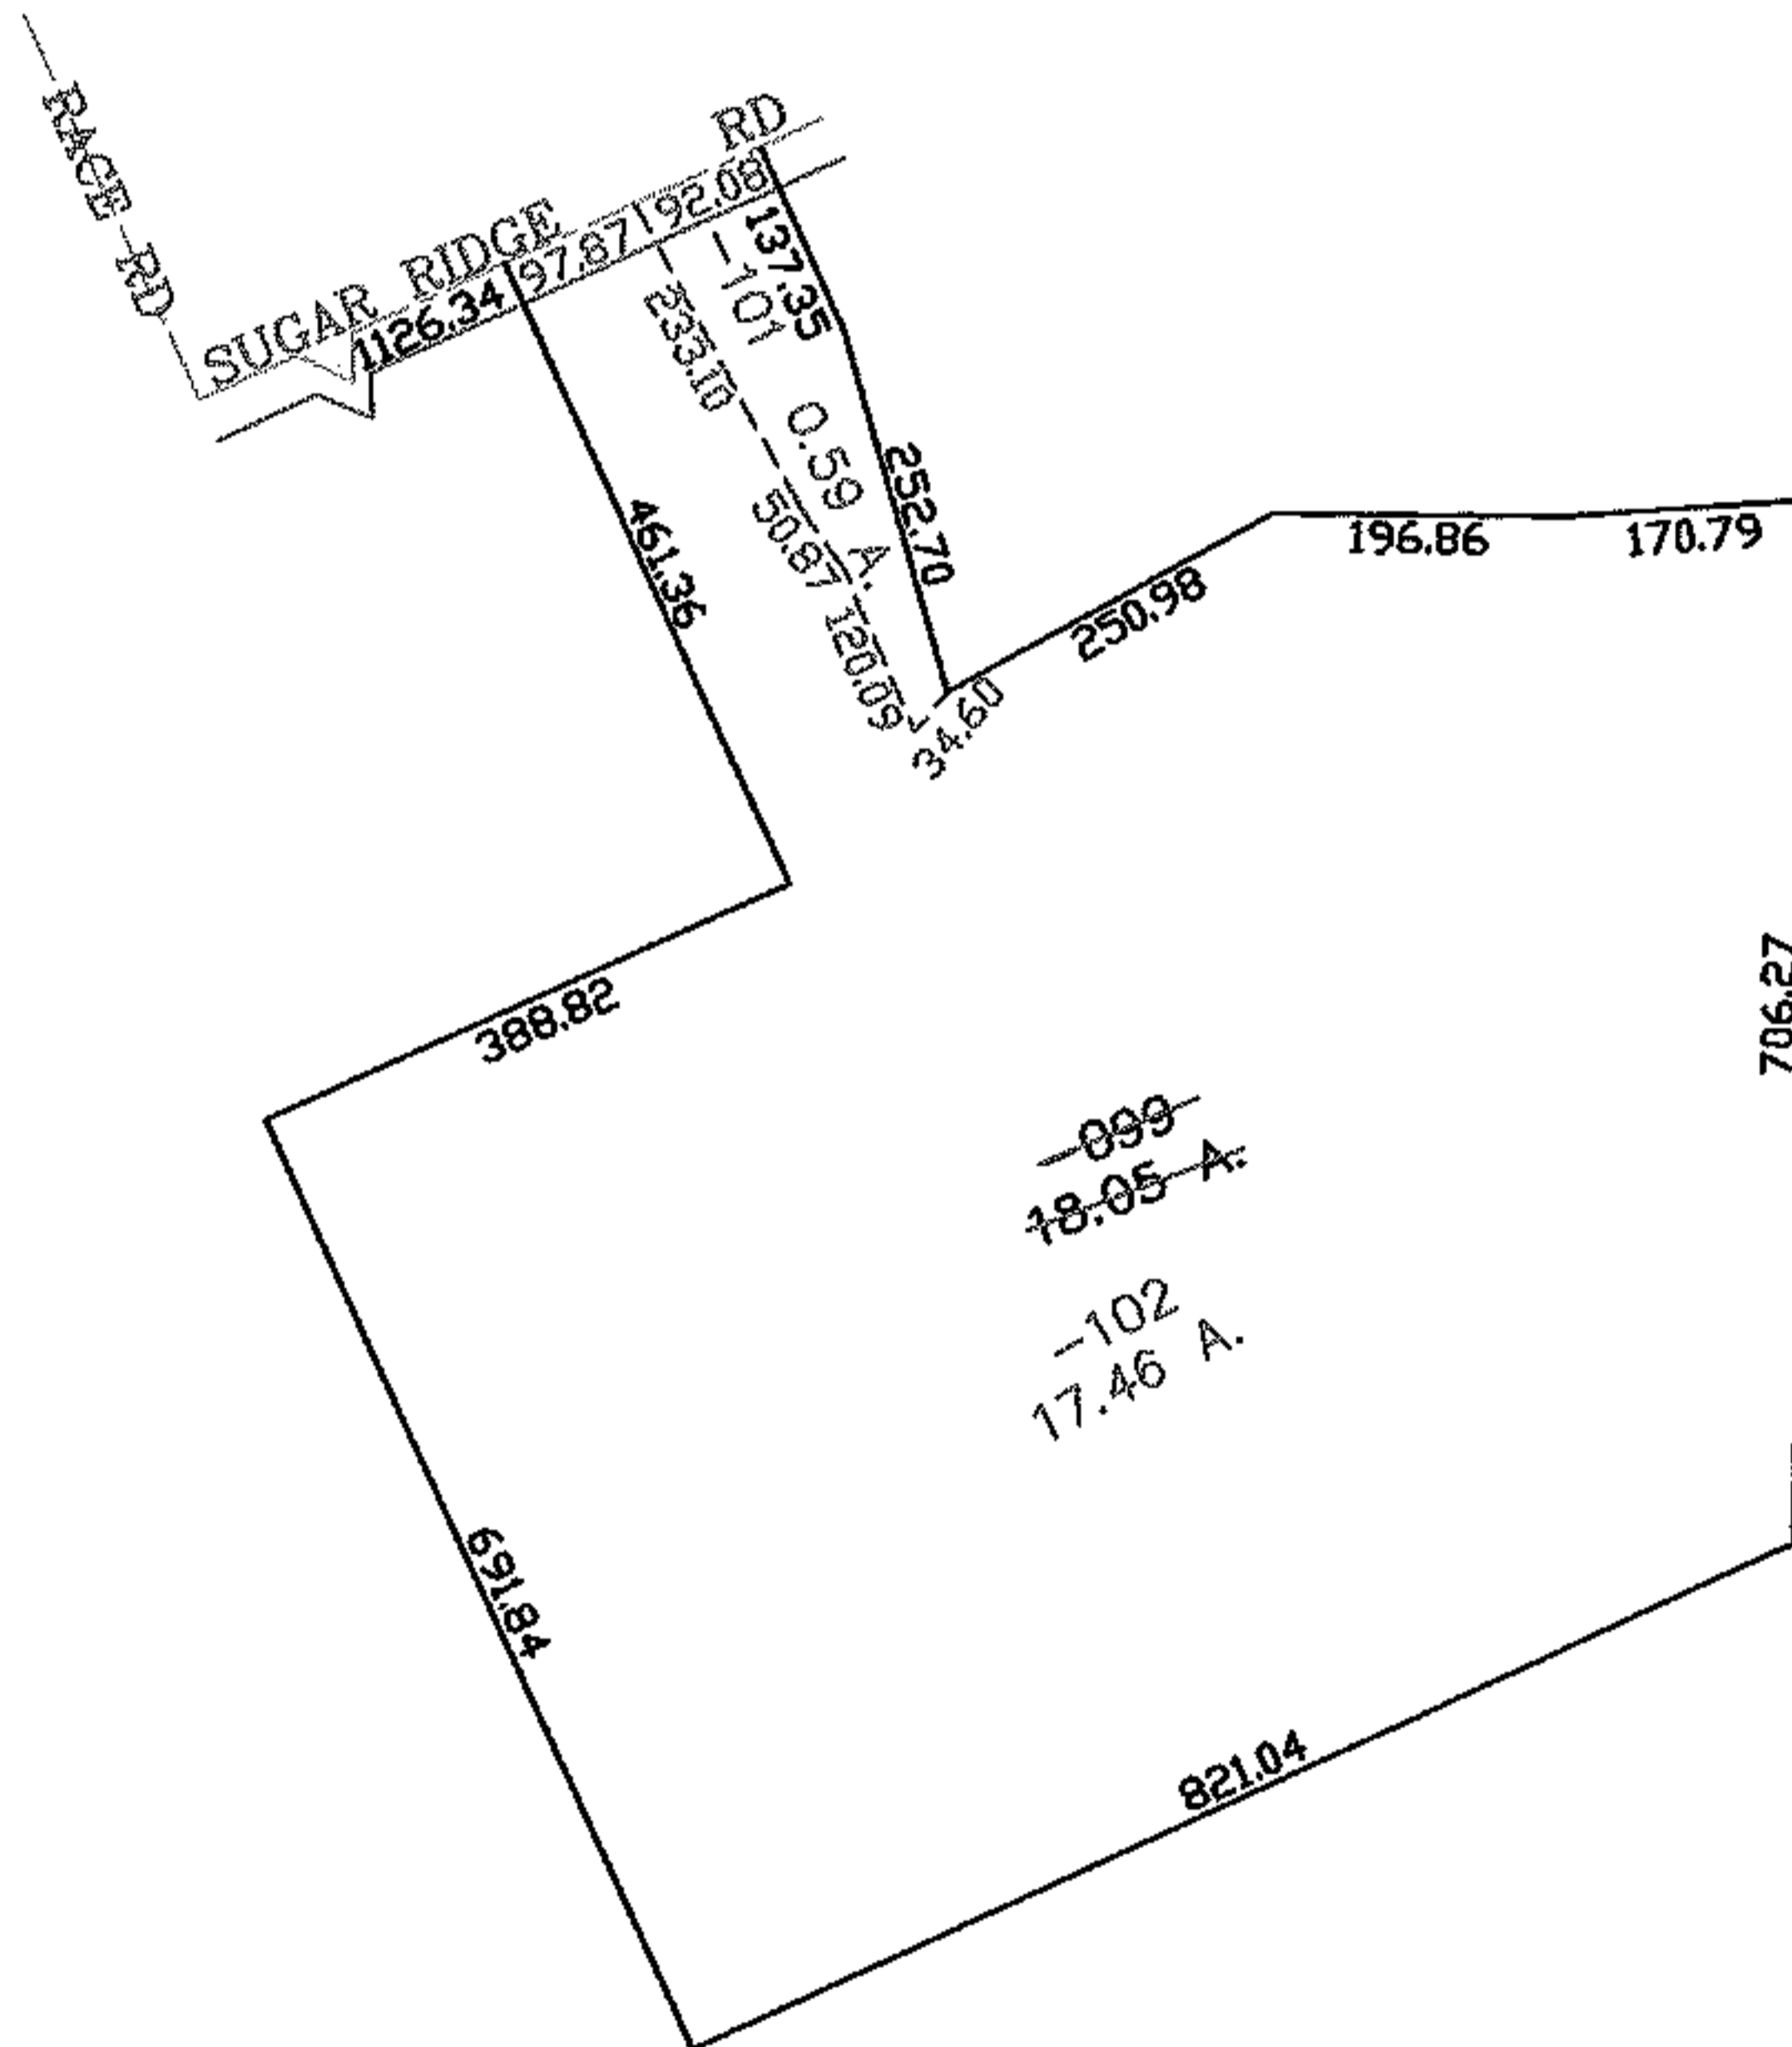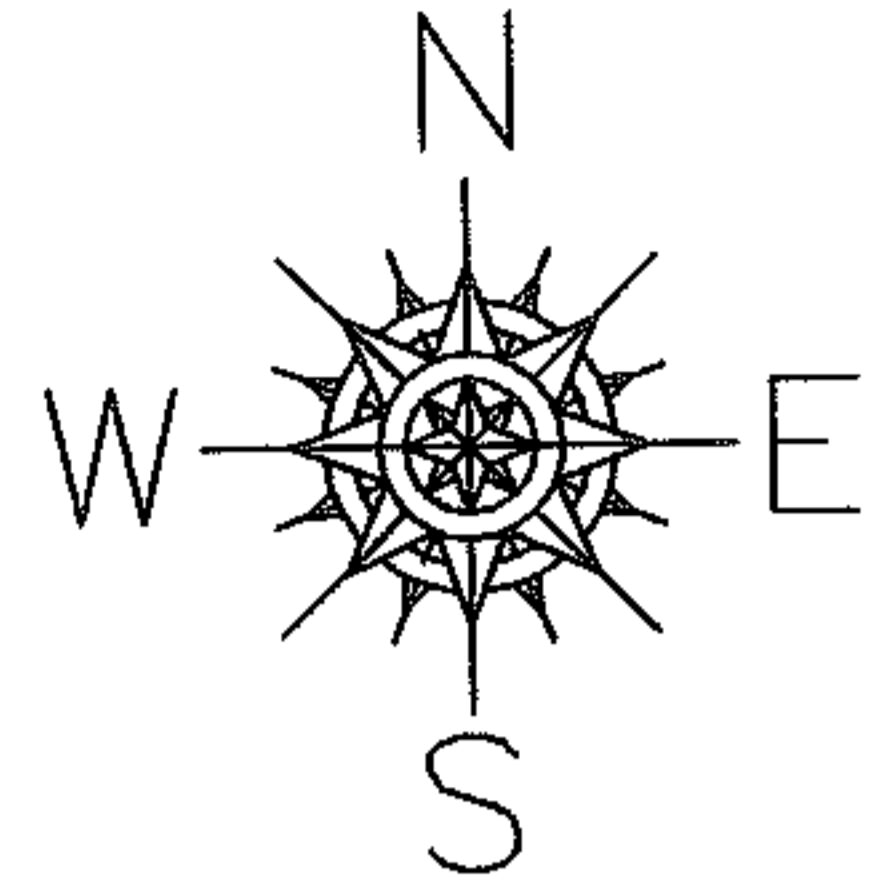

SPLITS/DEEDS PROCESSED

LORAIN COUNTY TAX MAP DEPARTMENT
226 MIDDLE AVE. ELYRIA, OHIO

SURVEYED BY: KENNETH BOHNING

CLOSURE: 0.00 : 10.000

MAP PAGE(S): 07-00-035-A

APPROVED BY: JAH DATE: 8-4-06

SCALE: 1" = 300 PRIOR INSTRUMENT: 20060141500