
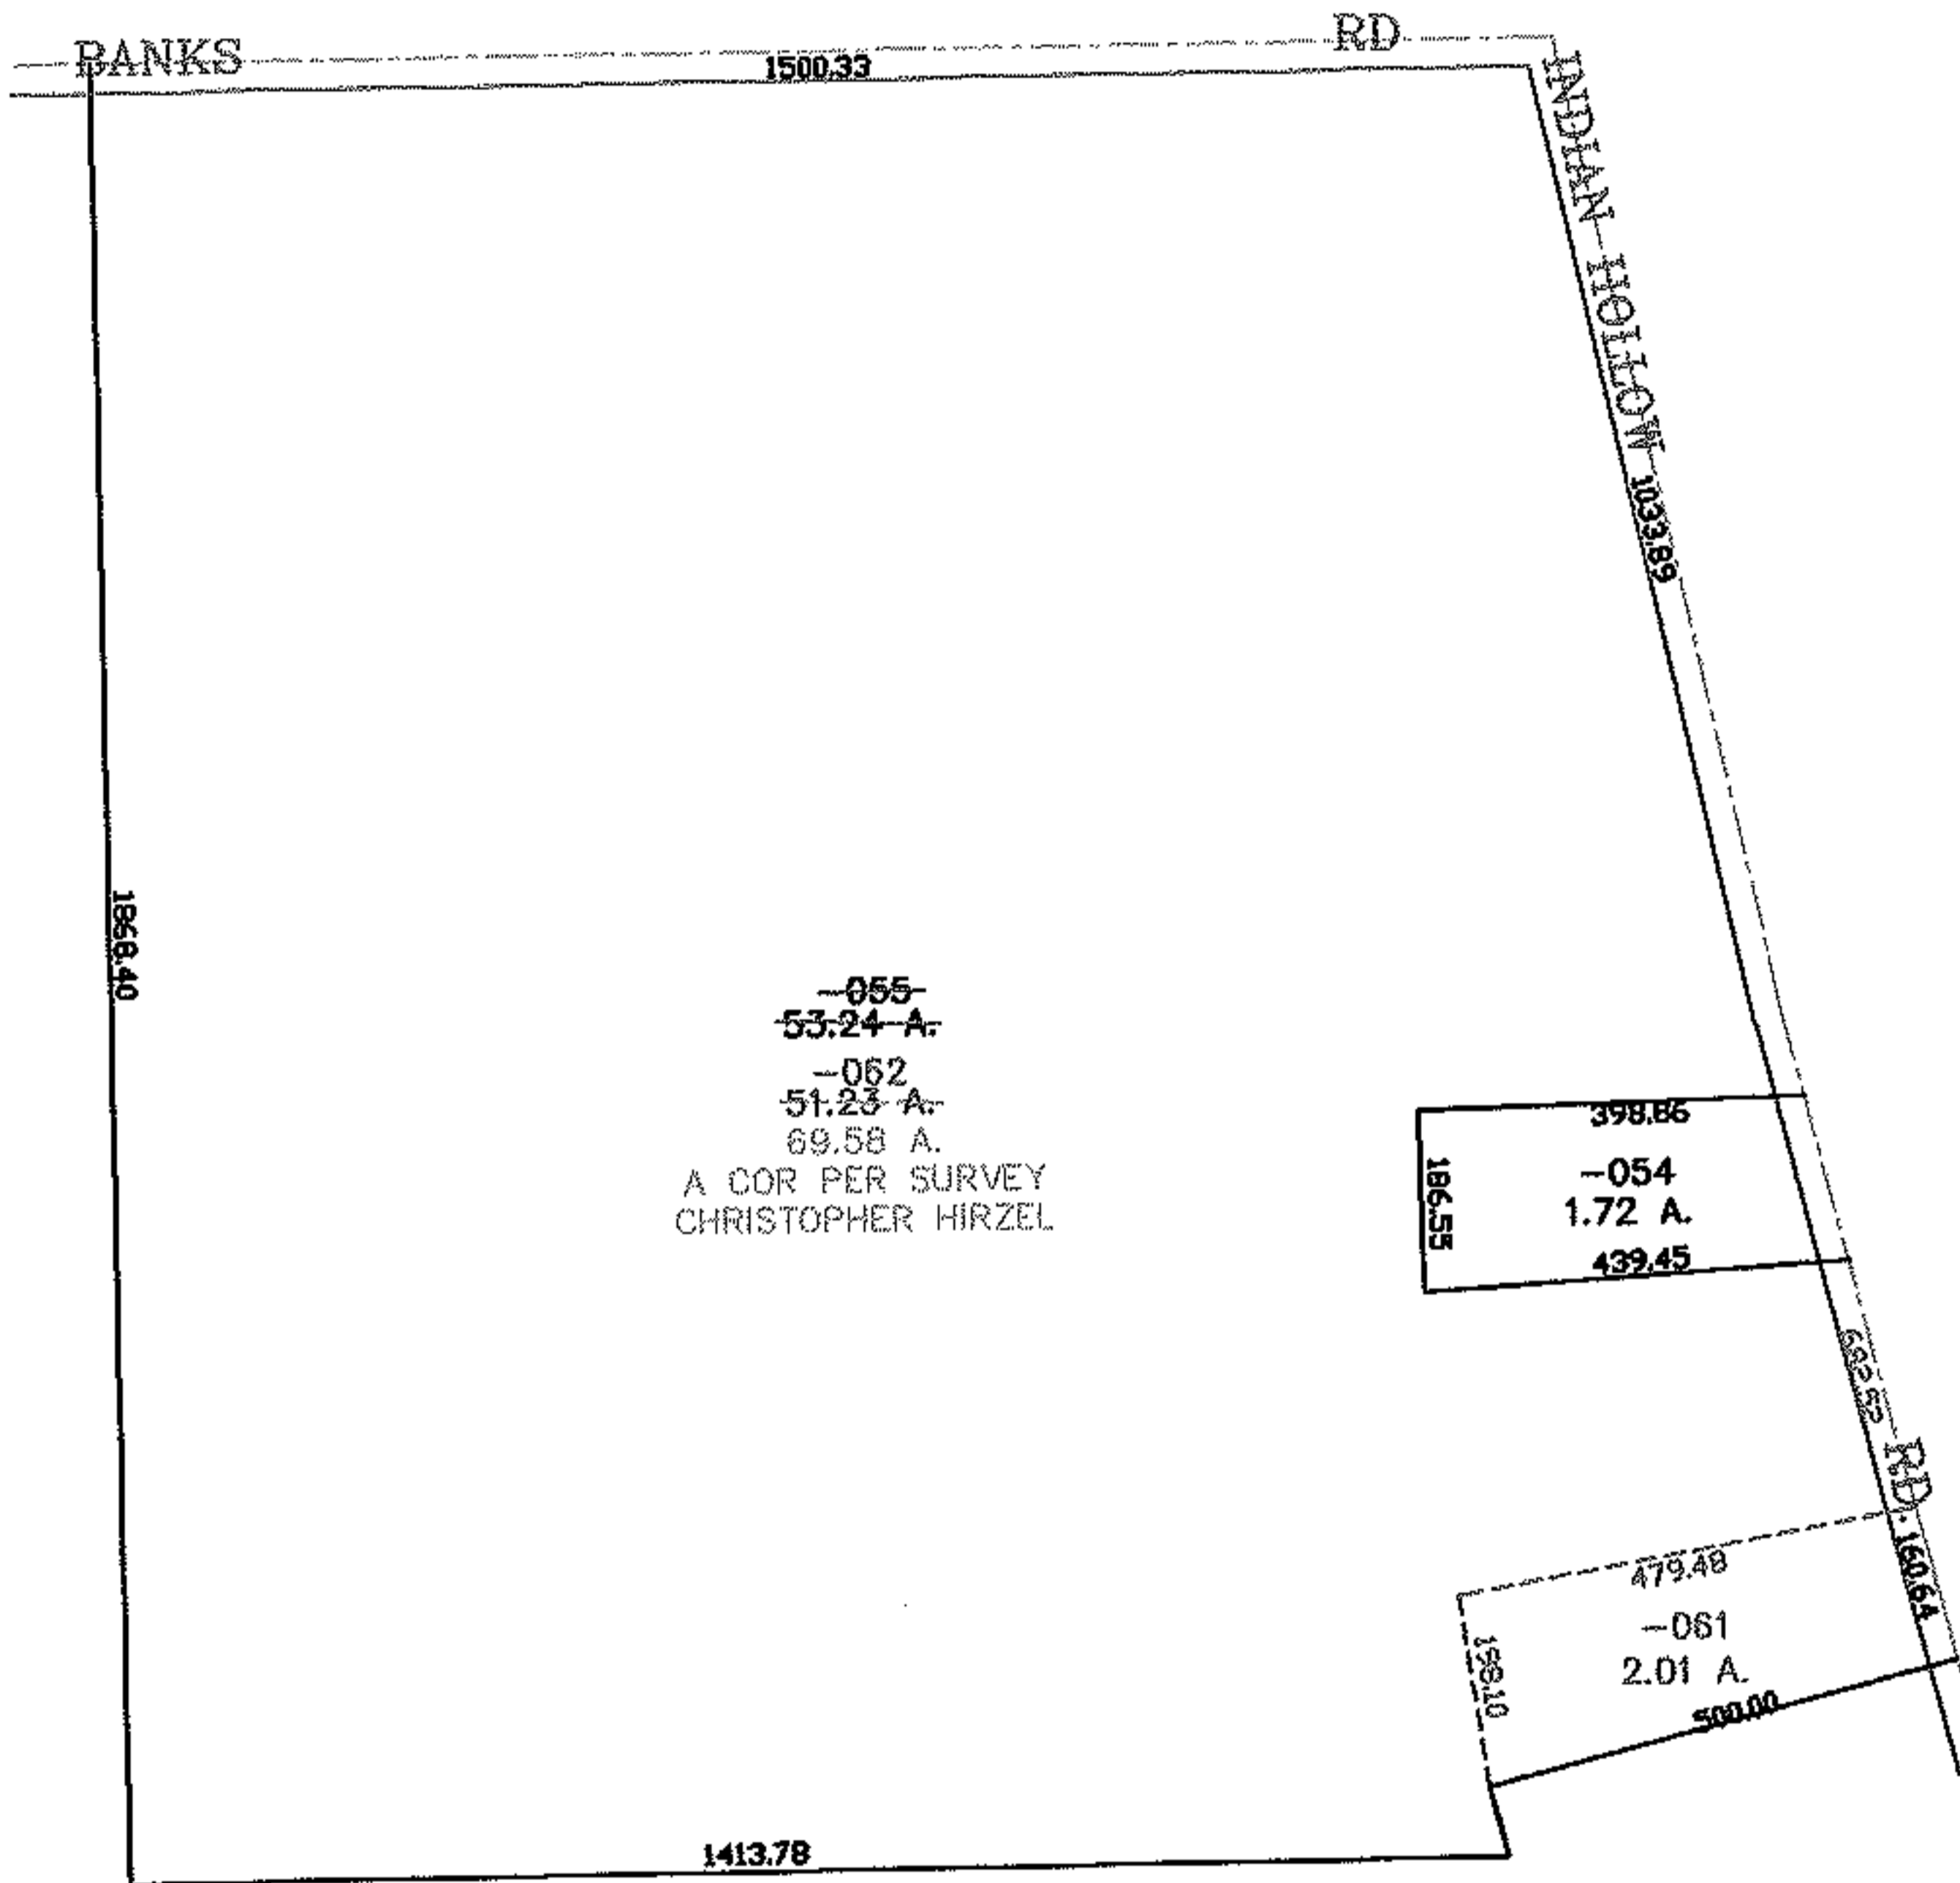


PARENT PARCEL: 10-00-025-101-055

CHILD PARCEL: 10-00-025-101-061, -062

STARTING POINT: CENTERLINE OF BANKS RD & INDIAN HOLLOW RD


06-02199

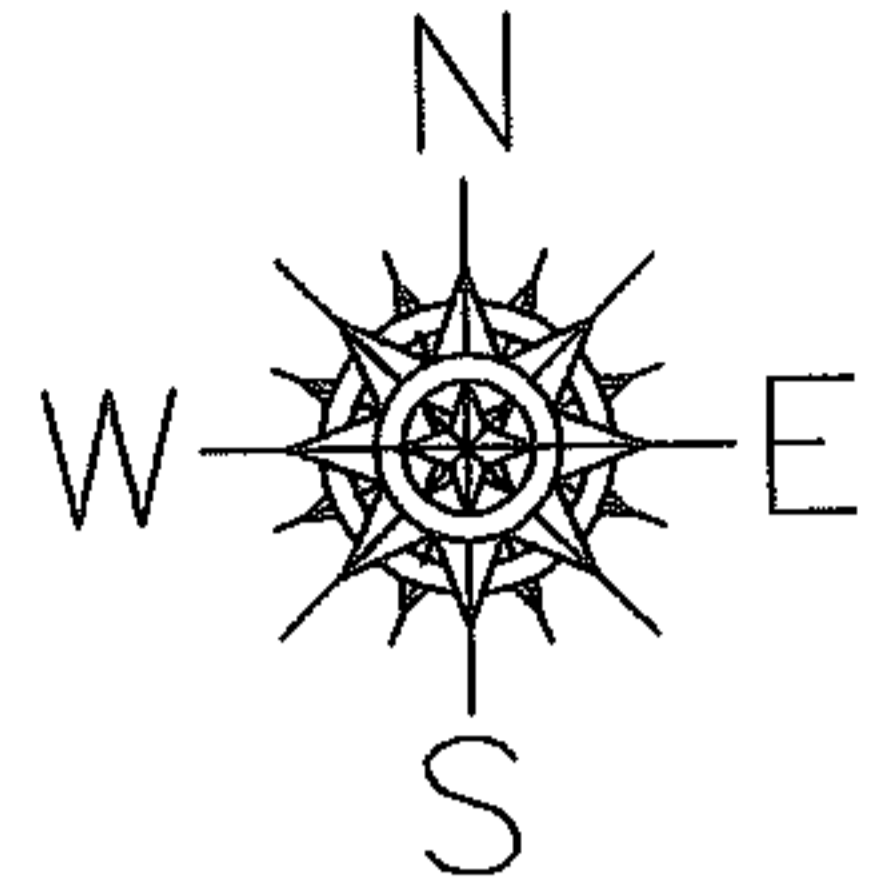

-055-
53.24 A.
-062
51.23 A.
69.58 A.
A COR PER SURVEY
CHRISTOPHER HIRZEL

398.86
-054
1.72 A.
439.45

479.48
-061
2.01 A.
500.00

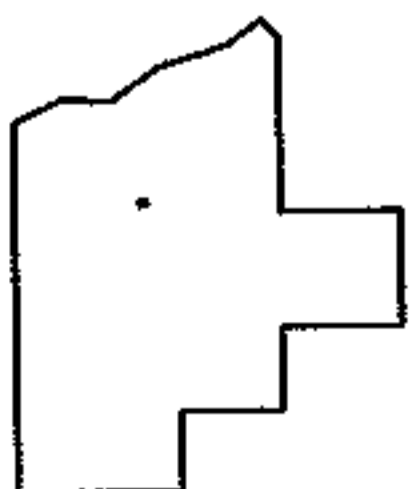

SPLITS/DEEDS PROCESSED
LORAIN COUNTY TAX MAP DEPARTMENT
226 MIDDLE AVE. ELYRIA, OHIO

SURVEYED BY: CHRISTOPHER HIRZEL

CLOSURE: 0.00 : 10.000

MAP PAGE(S): 10-00-025-F

APPROVED BY: JAH DATE: 8-8-06

SCALE: 1" = 400 PRIOR INSTRUMENT: DV 1352/916