




RASTER

PARENT PARCEL: 07-00-004-110-026, -035

06-02203

CHILD PARCEL: 07-00-004-110-042 THRU -047

STARTING POINT: CENTERLINE OF BUTTERNUT RIDGE RD & O.L. 4

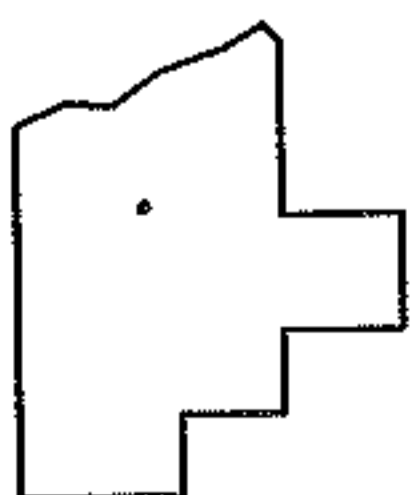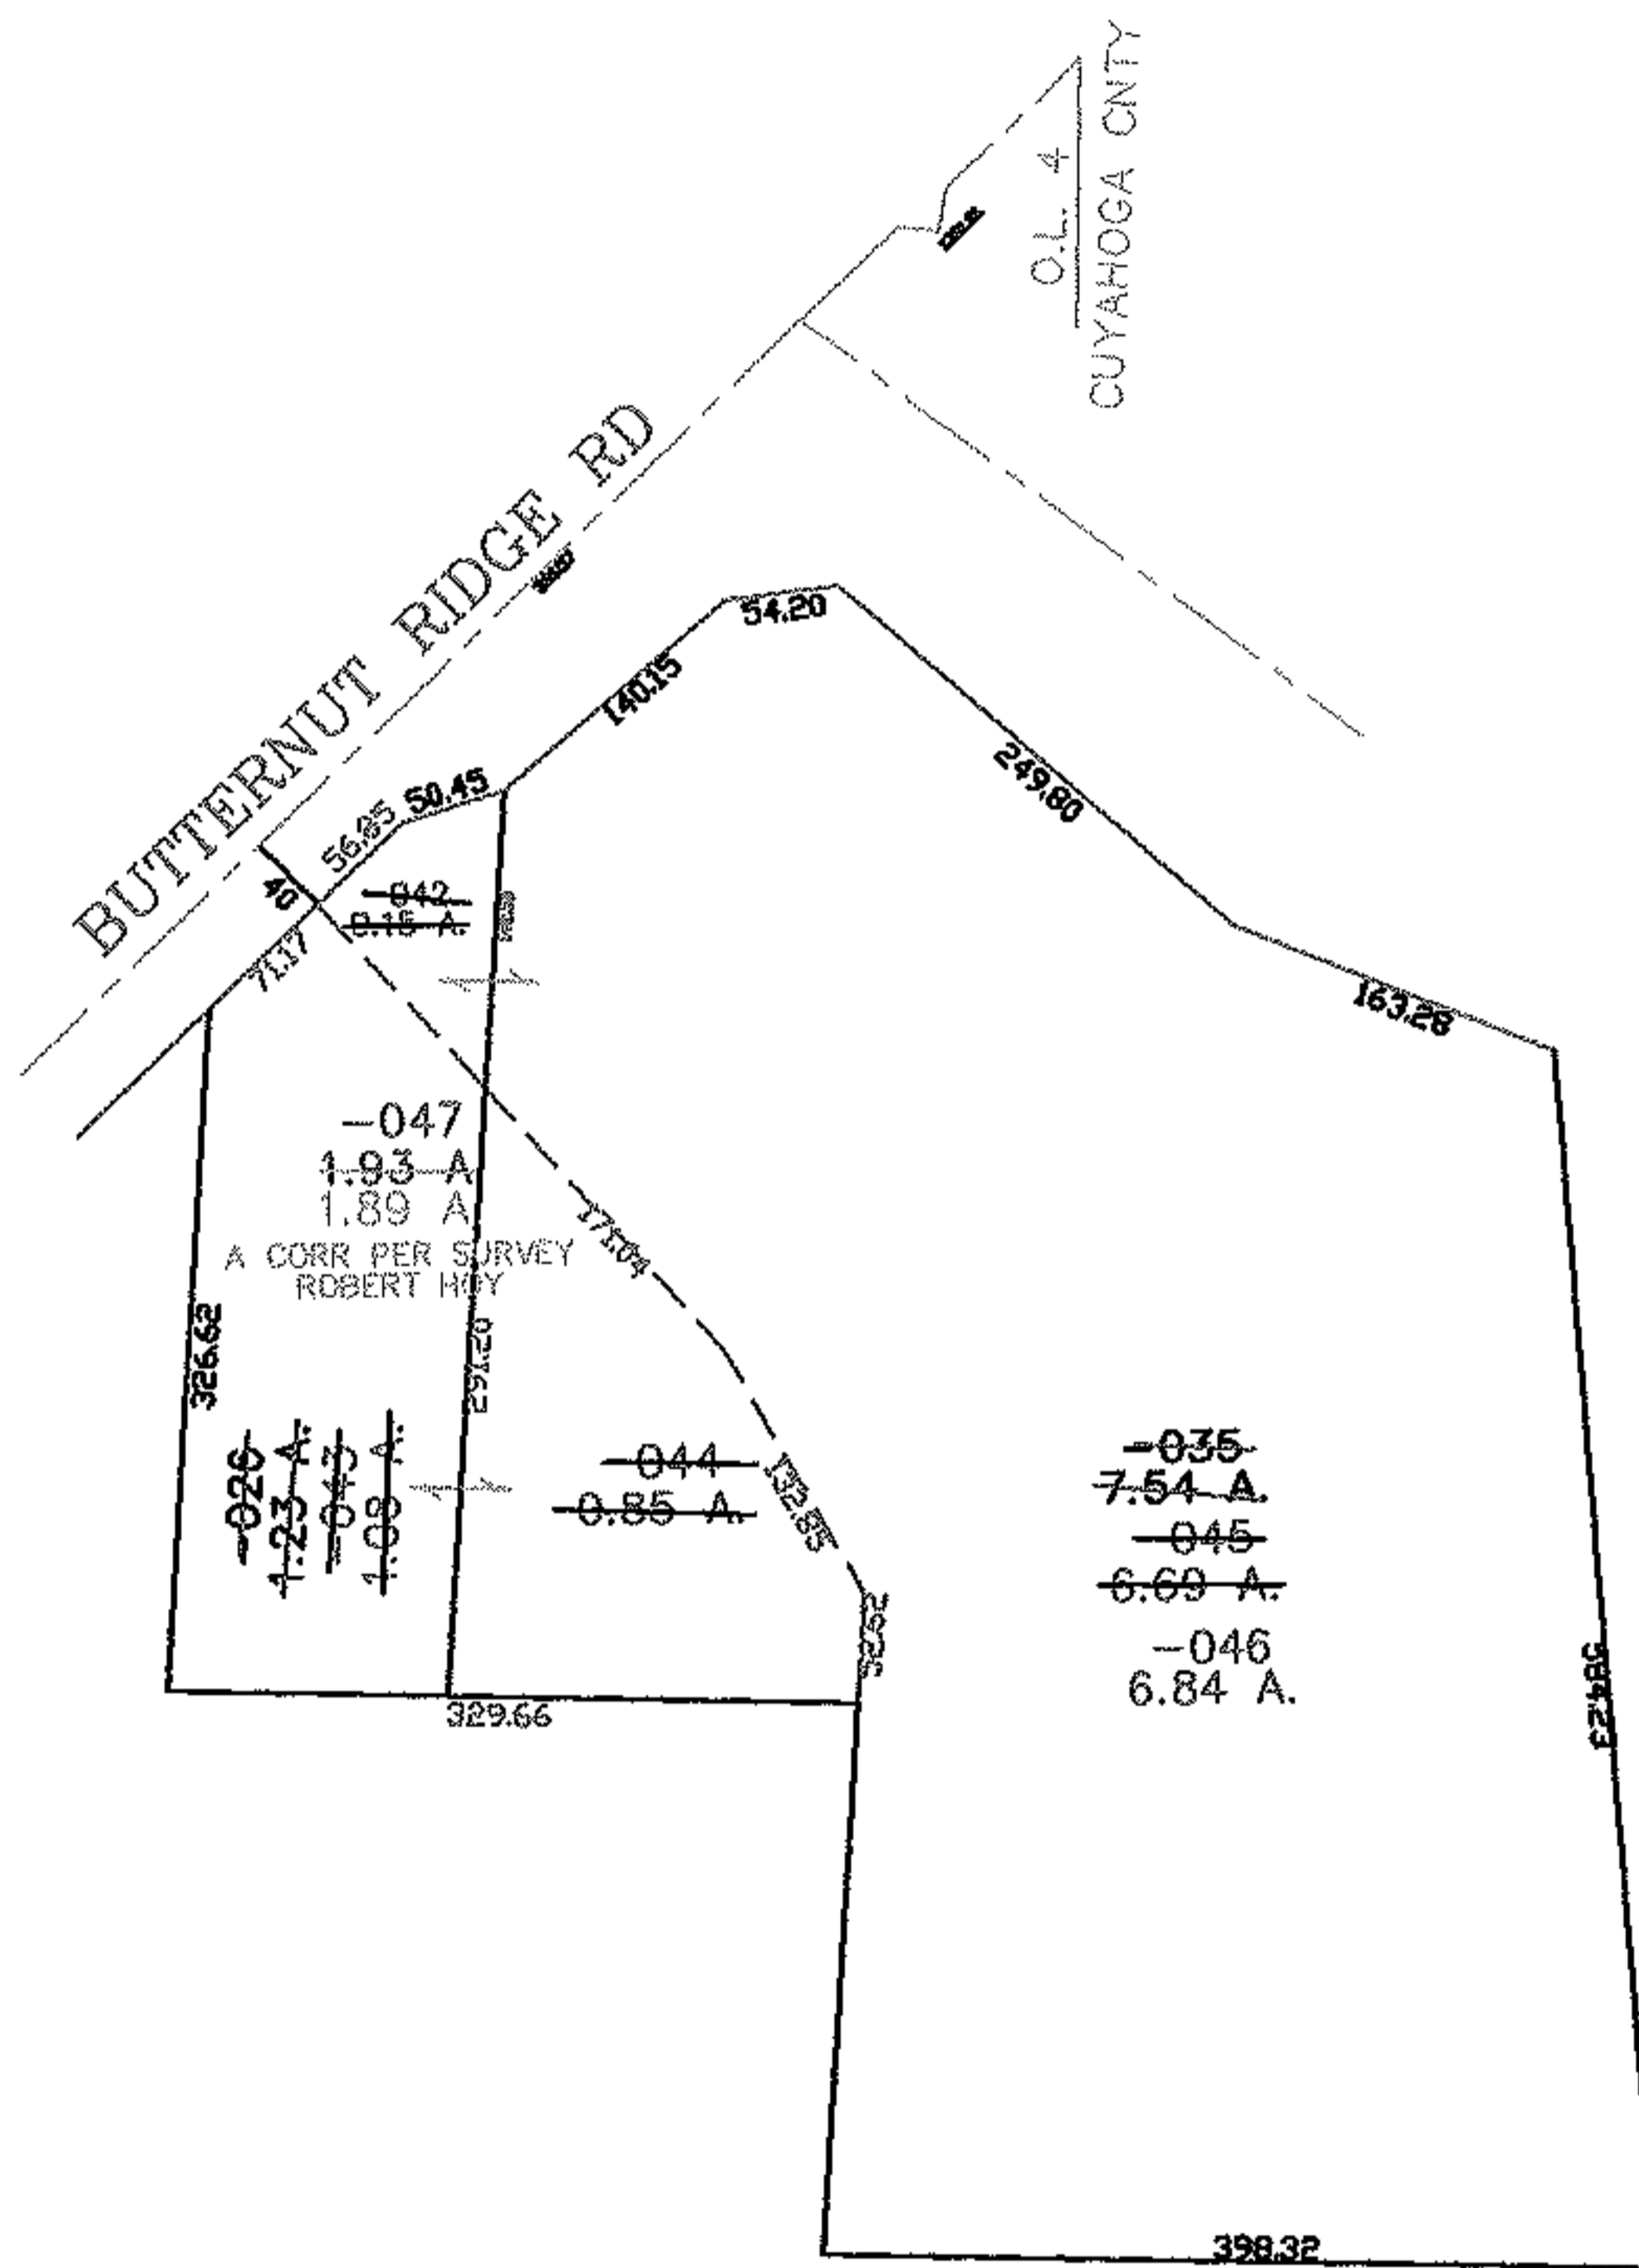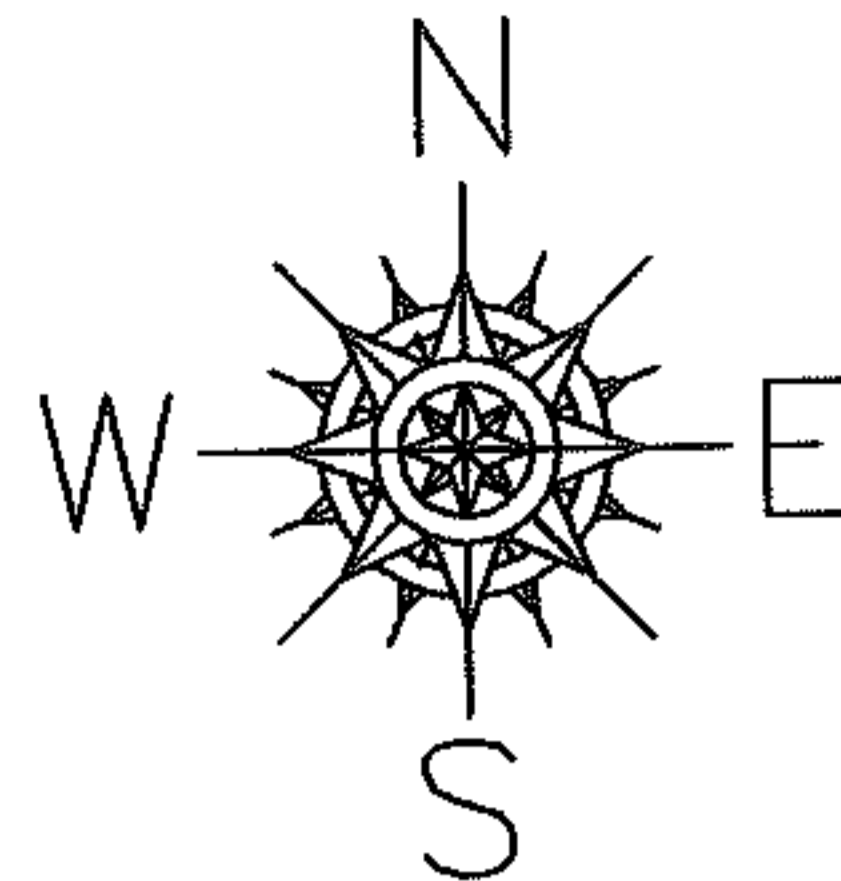

**SPLITS/DEEDS PROCESSED**

LORAIN COUNTY TAX MAP DEPARTMENT  
226 MIDDLE AVE. ELYRIA, OHIO

SURVEYED BY: ROBERT HOY

CLOSURE: 0.00 : 10.000

MAP PAGE(S): 07-00-004-D

APPROVED BY: JAH DATE: 8-14-06

SCALE: 1" = 200 PRIOR INSTRUMENT: 20060133034