
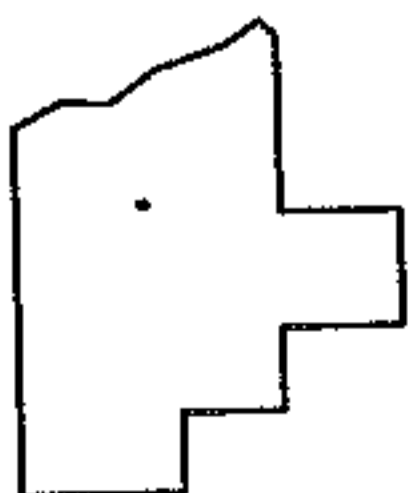
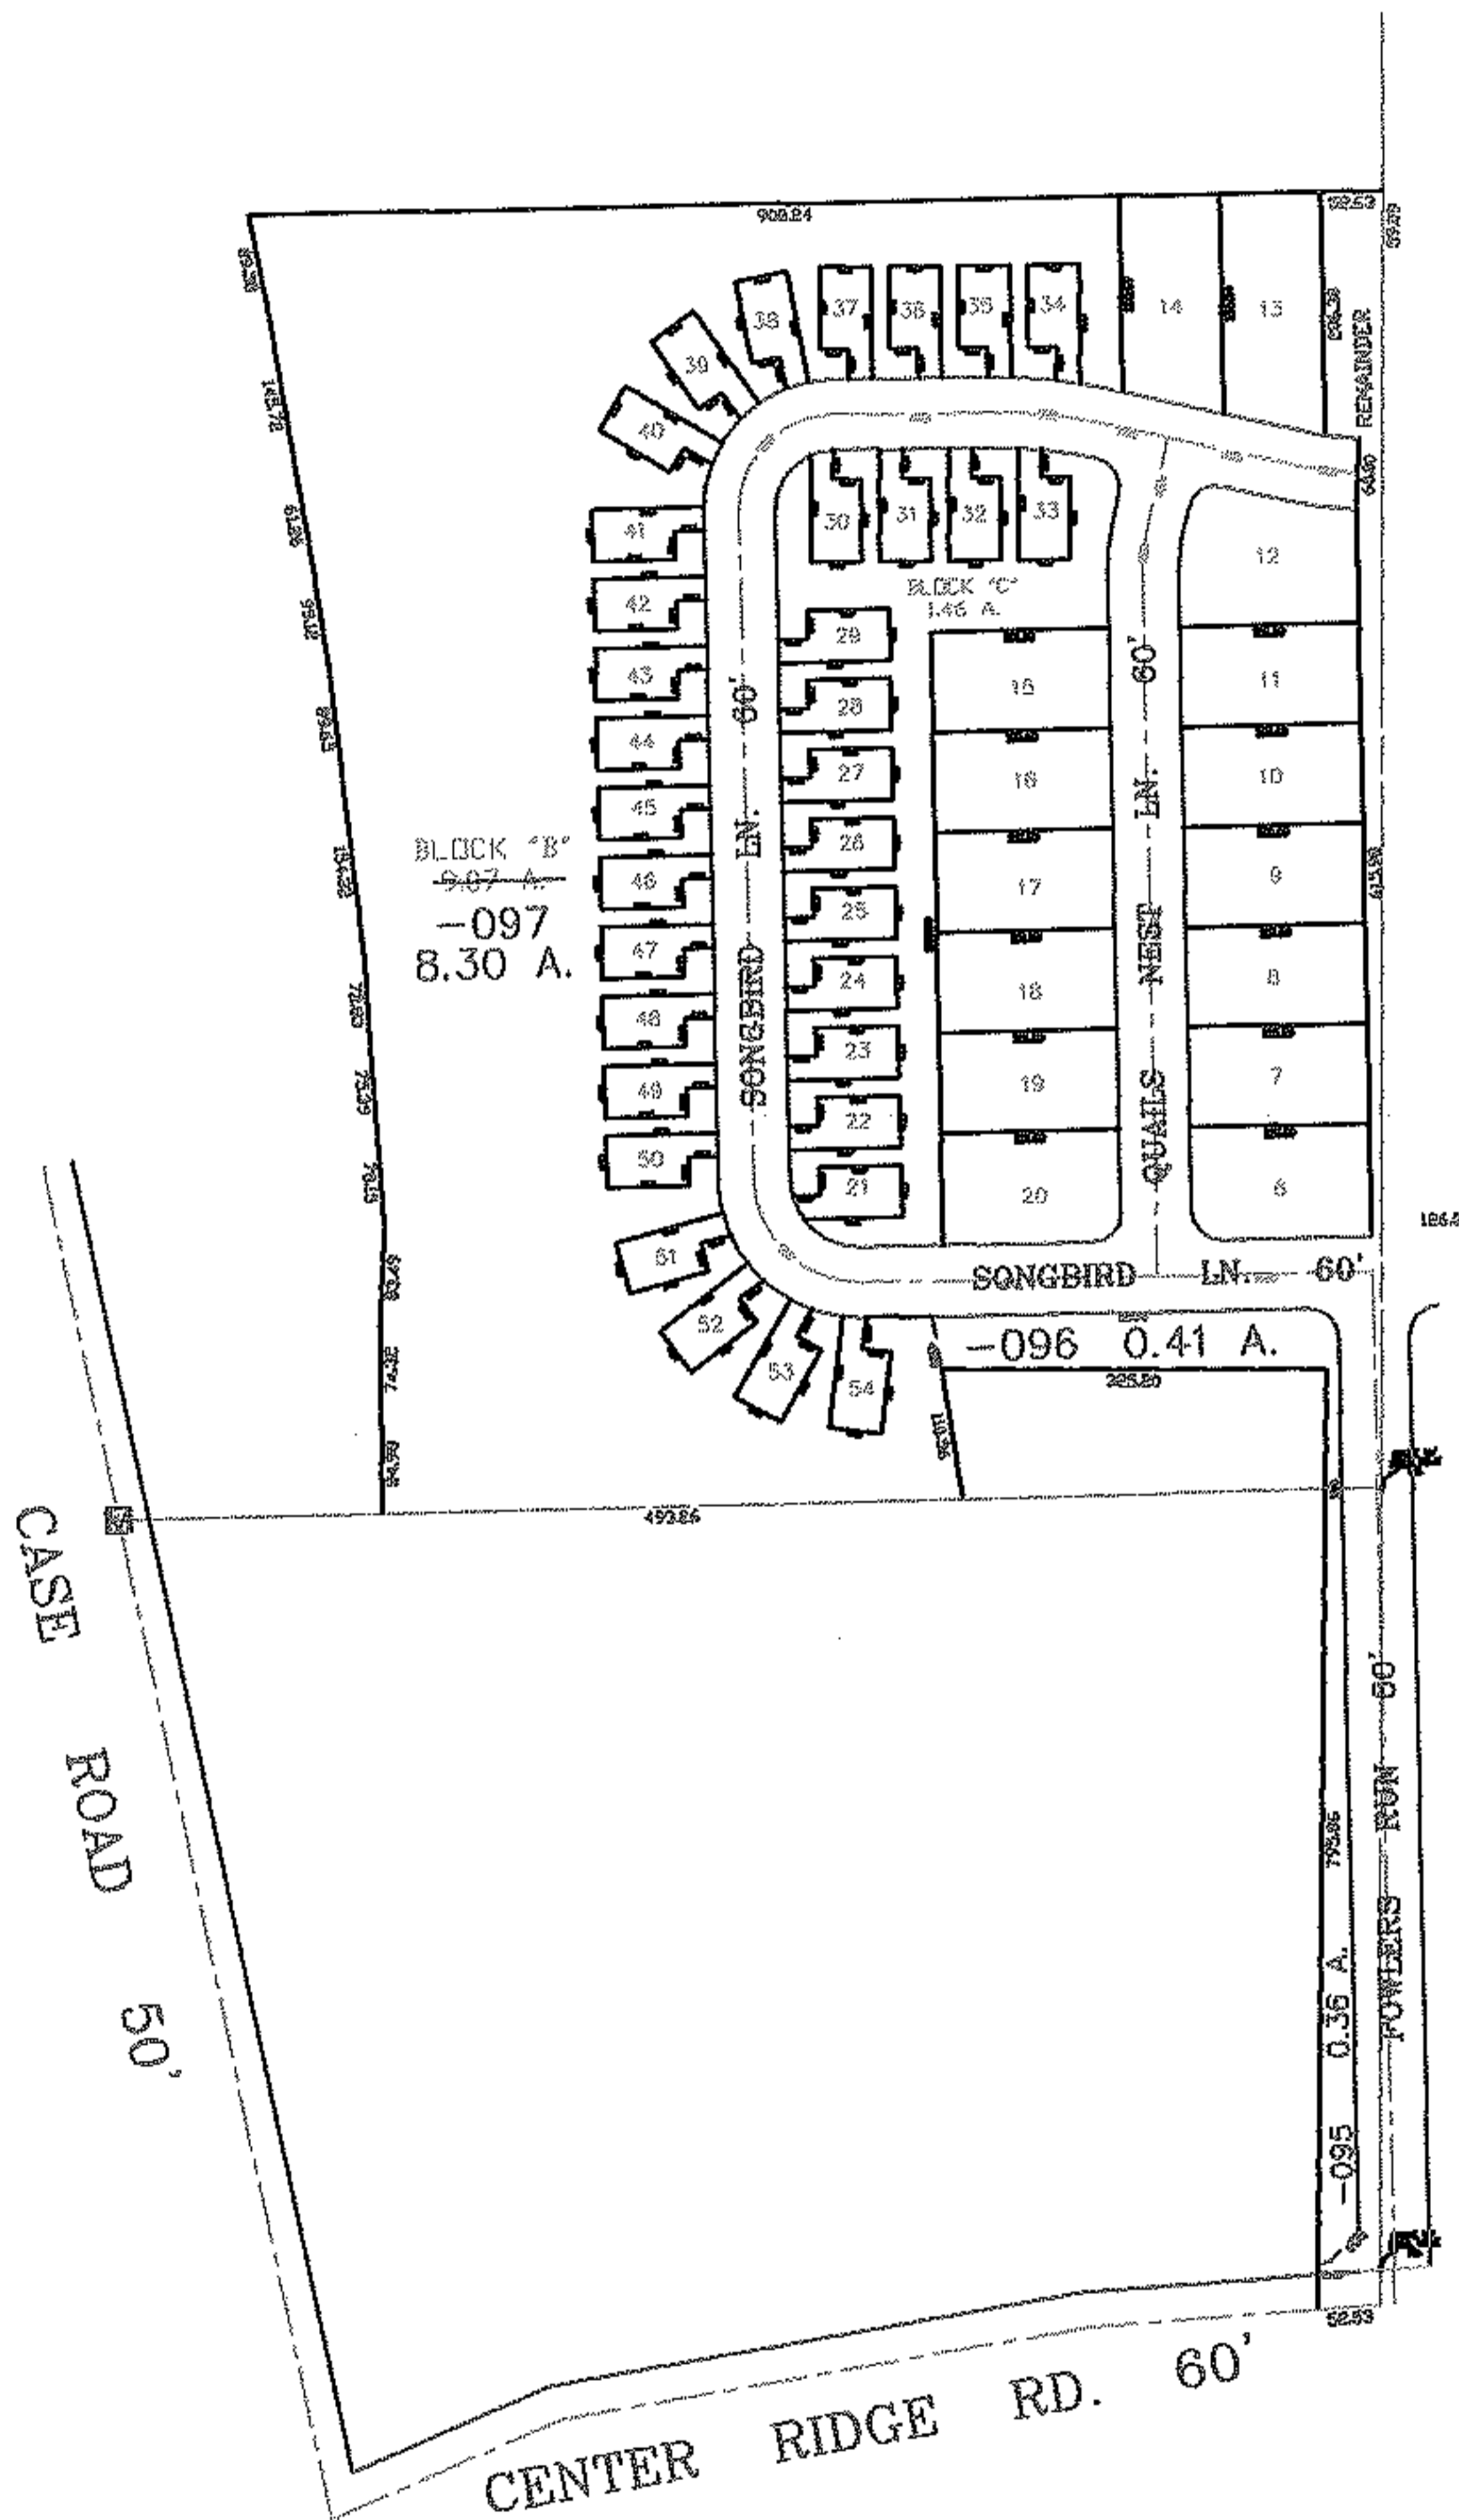


PARENT PARCEL: 07-00-045-110-071

CHILD PARCEL: 07-00-045-110-095 THRU -097

STARTING POINT: CENTERLINE OF FLOWERS RUN & SONG BIRD LN

06-02204

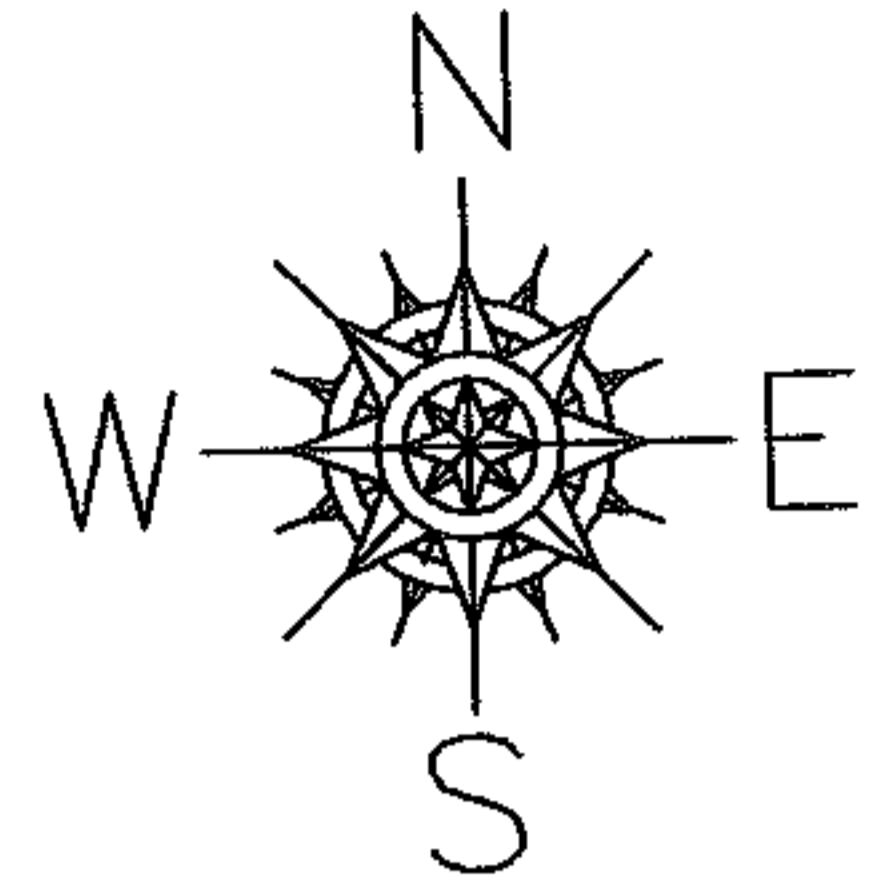

SPLITS/DEEDS PROCESSED
LORAIN COUNTY TAX MAP DEPARTMENT
226 MIDDLE AVE. ELYRIA, OHIO

SURVEYED BY: DAVID ELWELL
CLOSURE: 0.00 : 10.000
MAP PAGE(S): 07-00-046-B
APPROVED BY: JAH DATE: 8-21-06
SCALE: 1" = 300 PRIOR INSTRUMENT: PL VL 87/1