


RASTER

PARENT PARCEL: 15-00-097-000-034, -035

06-02205

CHILD PARCEL: 15-00-097-000-036 THRU -041



STARTING POINT: CENTERLINE OF MEADOW LN & WHITEHEAD RD

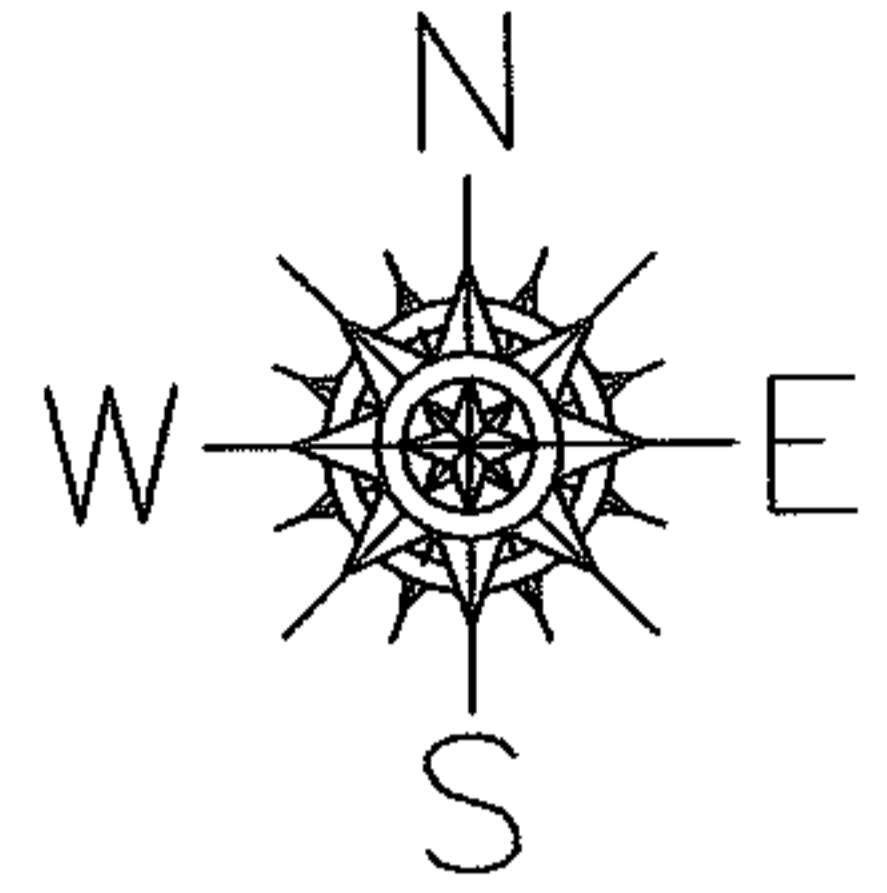

MEADOW LN

DR

WHITEHEAD

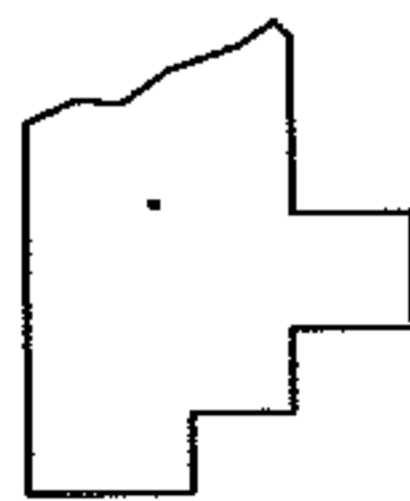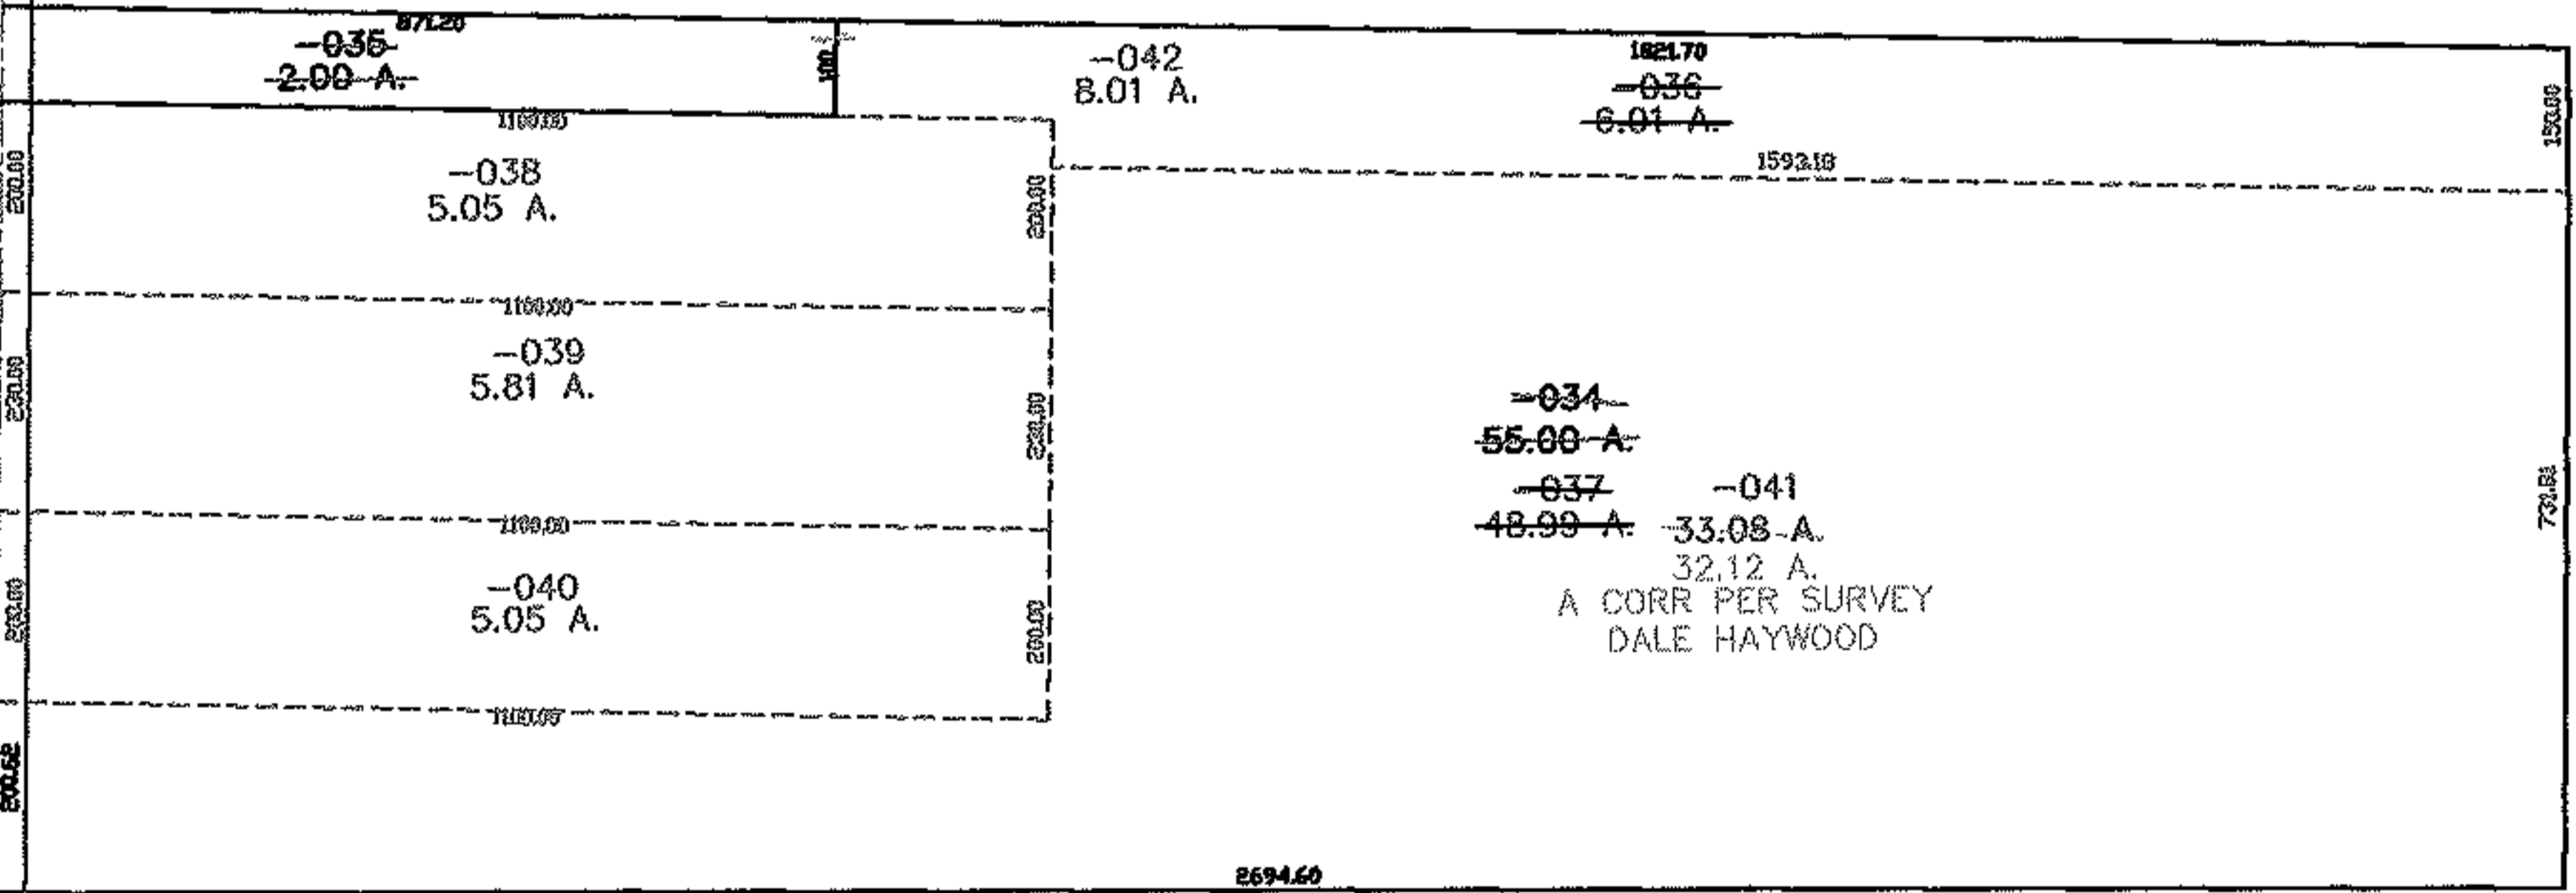

**SPLITS/DEEDS PROCESSED**  
 LORAIN COUNTY TAX MAP DEPARTMENT  
 226 MIDDLE AVE. ELYRIA, OHIO

SURVEYED BY: DALE HAYWOOD  
 CLOSURE: 0.00 : 10.000  
 MAP PAGE(S): 15-F  
 APPROVED BY: JAH DATE: 8-16-06  
 SCALE: 1" = 400 PRIOR INSTRUMENT: 20060144087