


RASTER

06-02-10

PARENT PARCEL: *SEE BELOW

CHILD PARCEL: *SEE BELOW

STARTING POINT: CENTERLINE OF SNELL RD & EAST RIVER RD


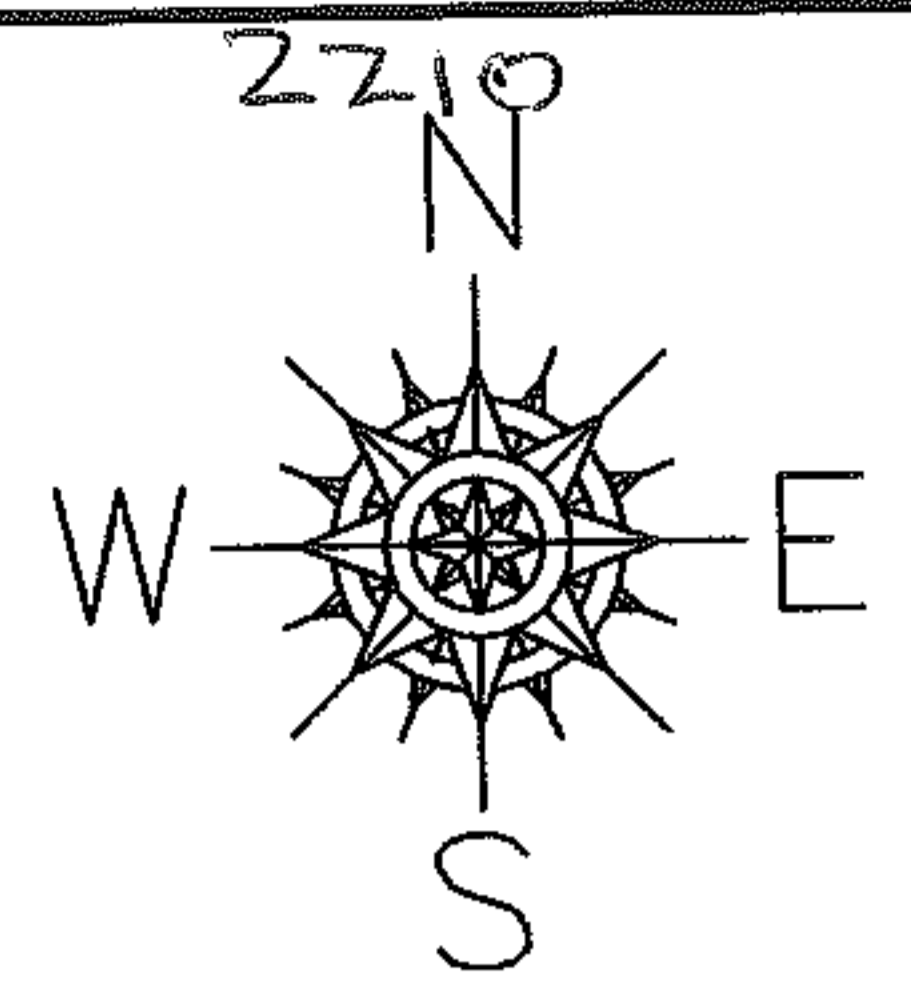


PARENT PARCELS

- 12-00-038-000-072
- 12-00-022-000-015, -023
- 12-00-023-000-002, -025
- 12-00-038-000-015
- 12-00-039-000-012, -013, -014

CHILD PARCELS

- 12-00-023-000-067
- 12-00-039-000-087, -088
- 12-00-022-000-027
- 12-00-038-000-095, -096, -015
- 12-00-039-000-089

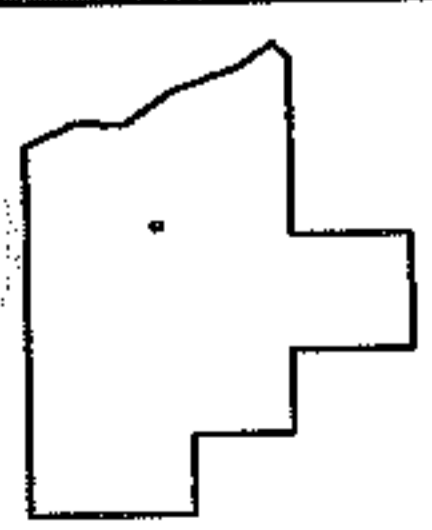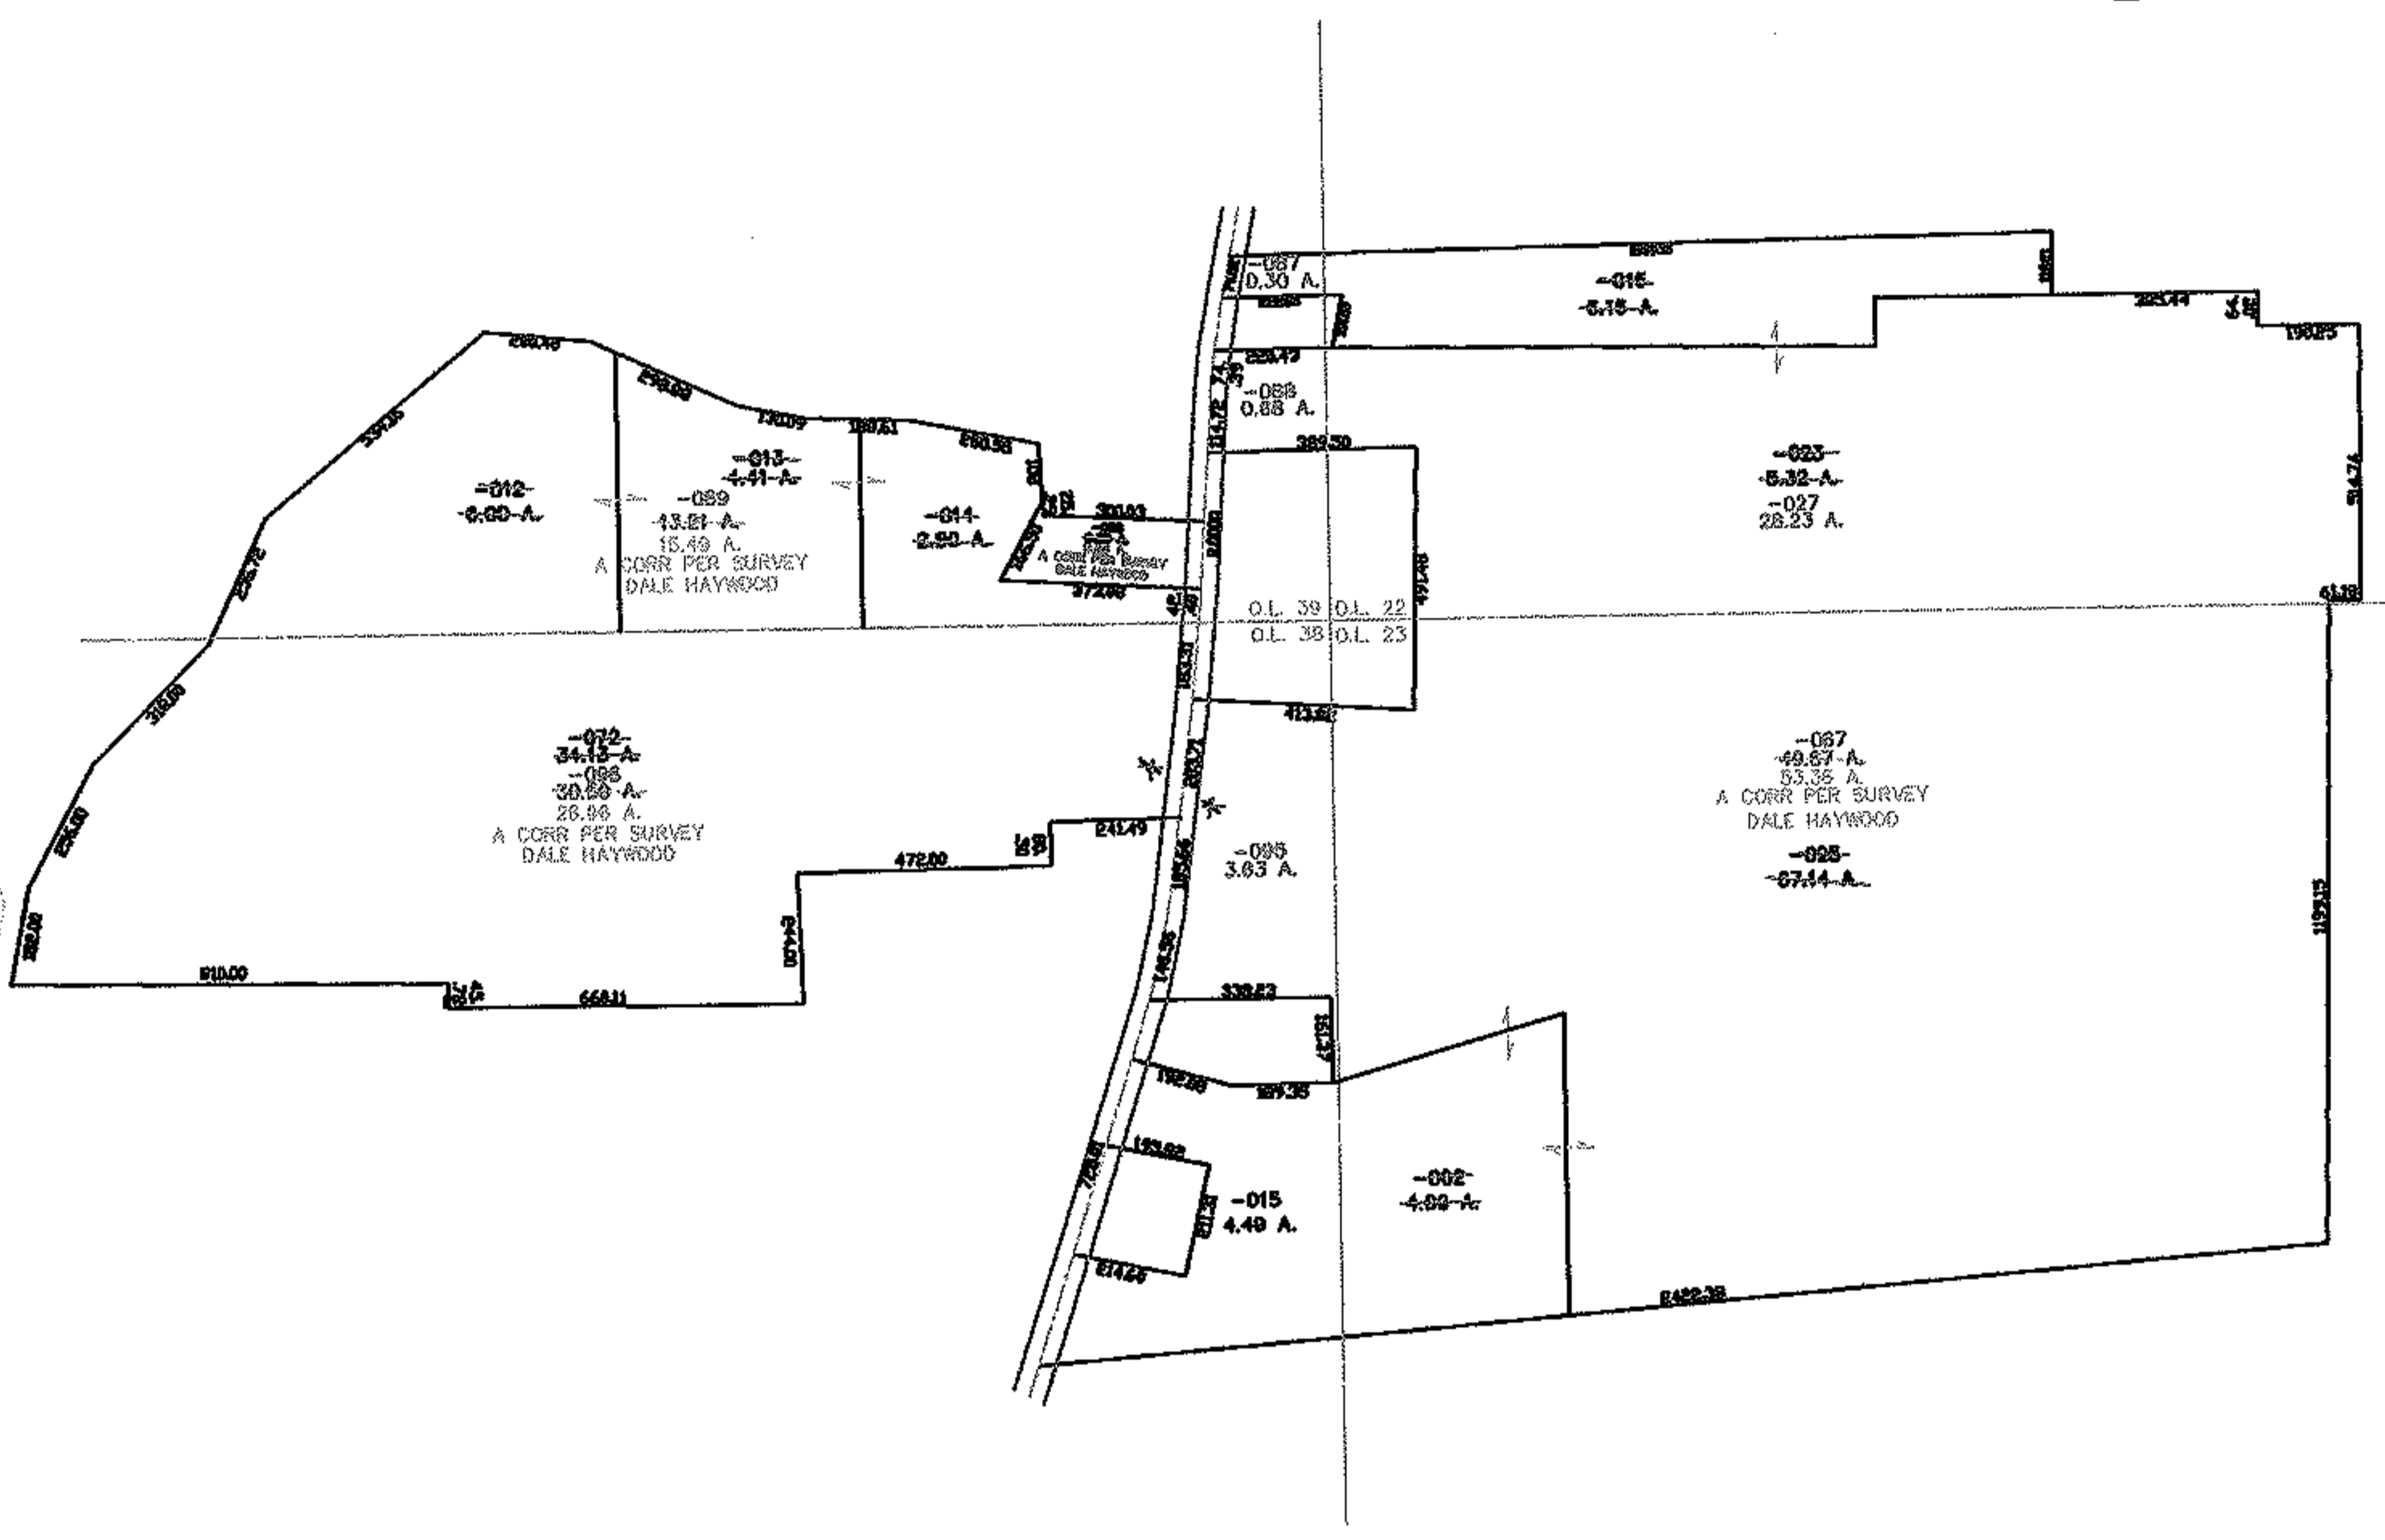

SPLITS/DEEDS PROCESSED

LORAIN COUNTY TAX MAP DEPARTMENT
226 MIDDLE AVE. ELYRIA, OHIO

SURVEYED BY: DALE HAYWOOD
 CLOSURE: 0.00 : 10.000
 MAP PAGE(S): 12-00-022A, 023B, 038B
 APPROVED BY: JAH DATE: 8-31-06
 SCALE: 1" = 600 PRIOR INSTRUMENT: OR 807/801