
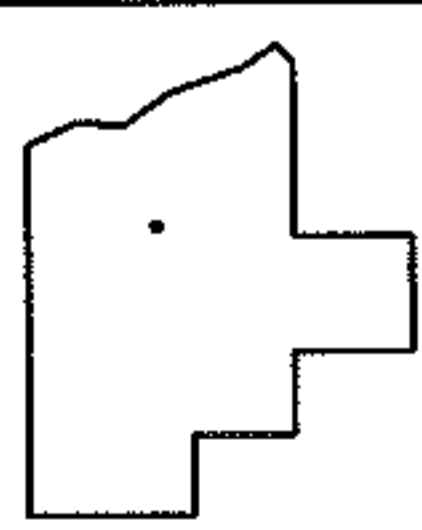
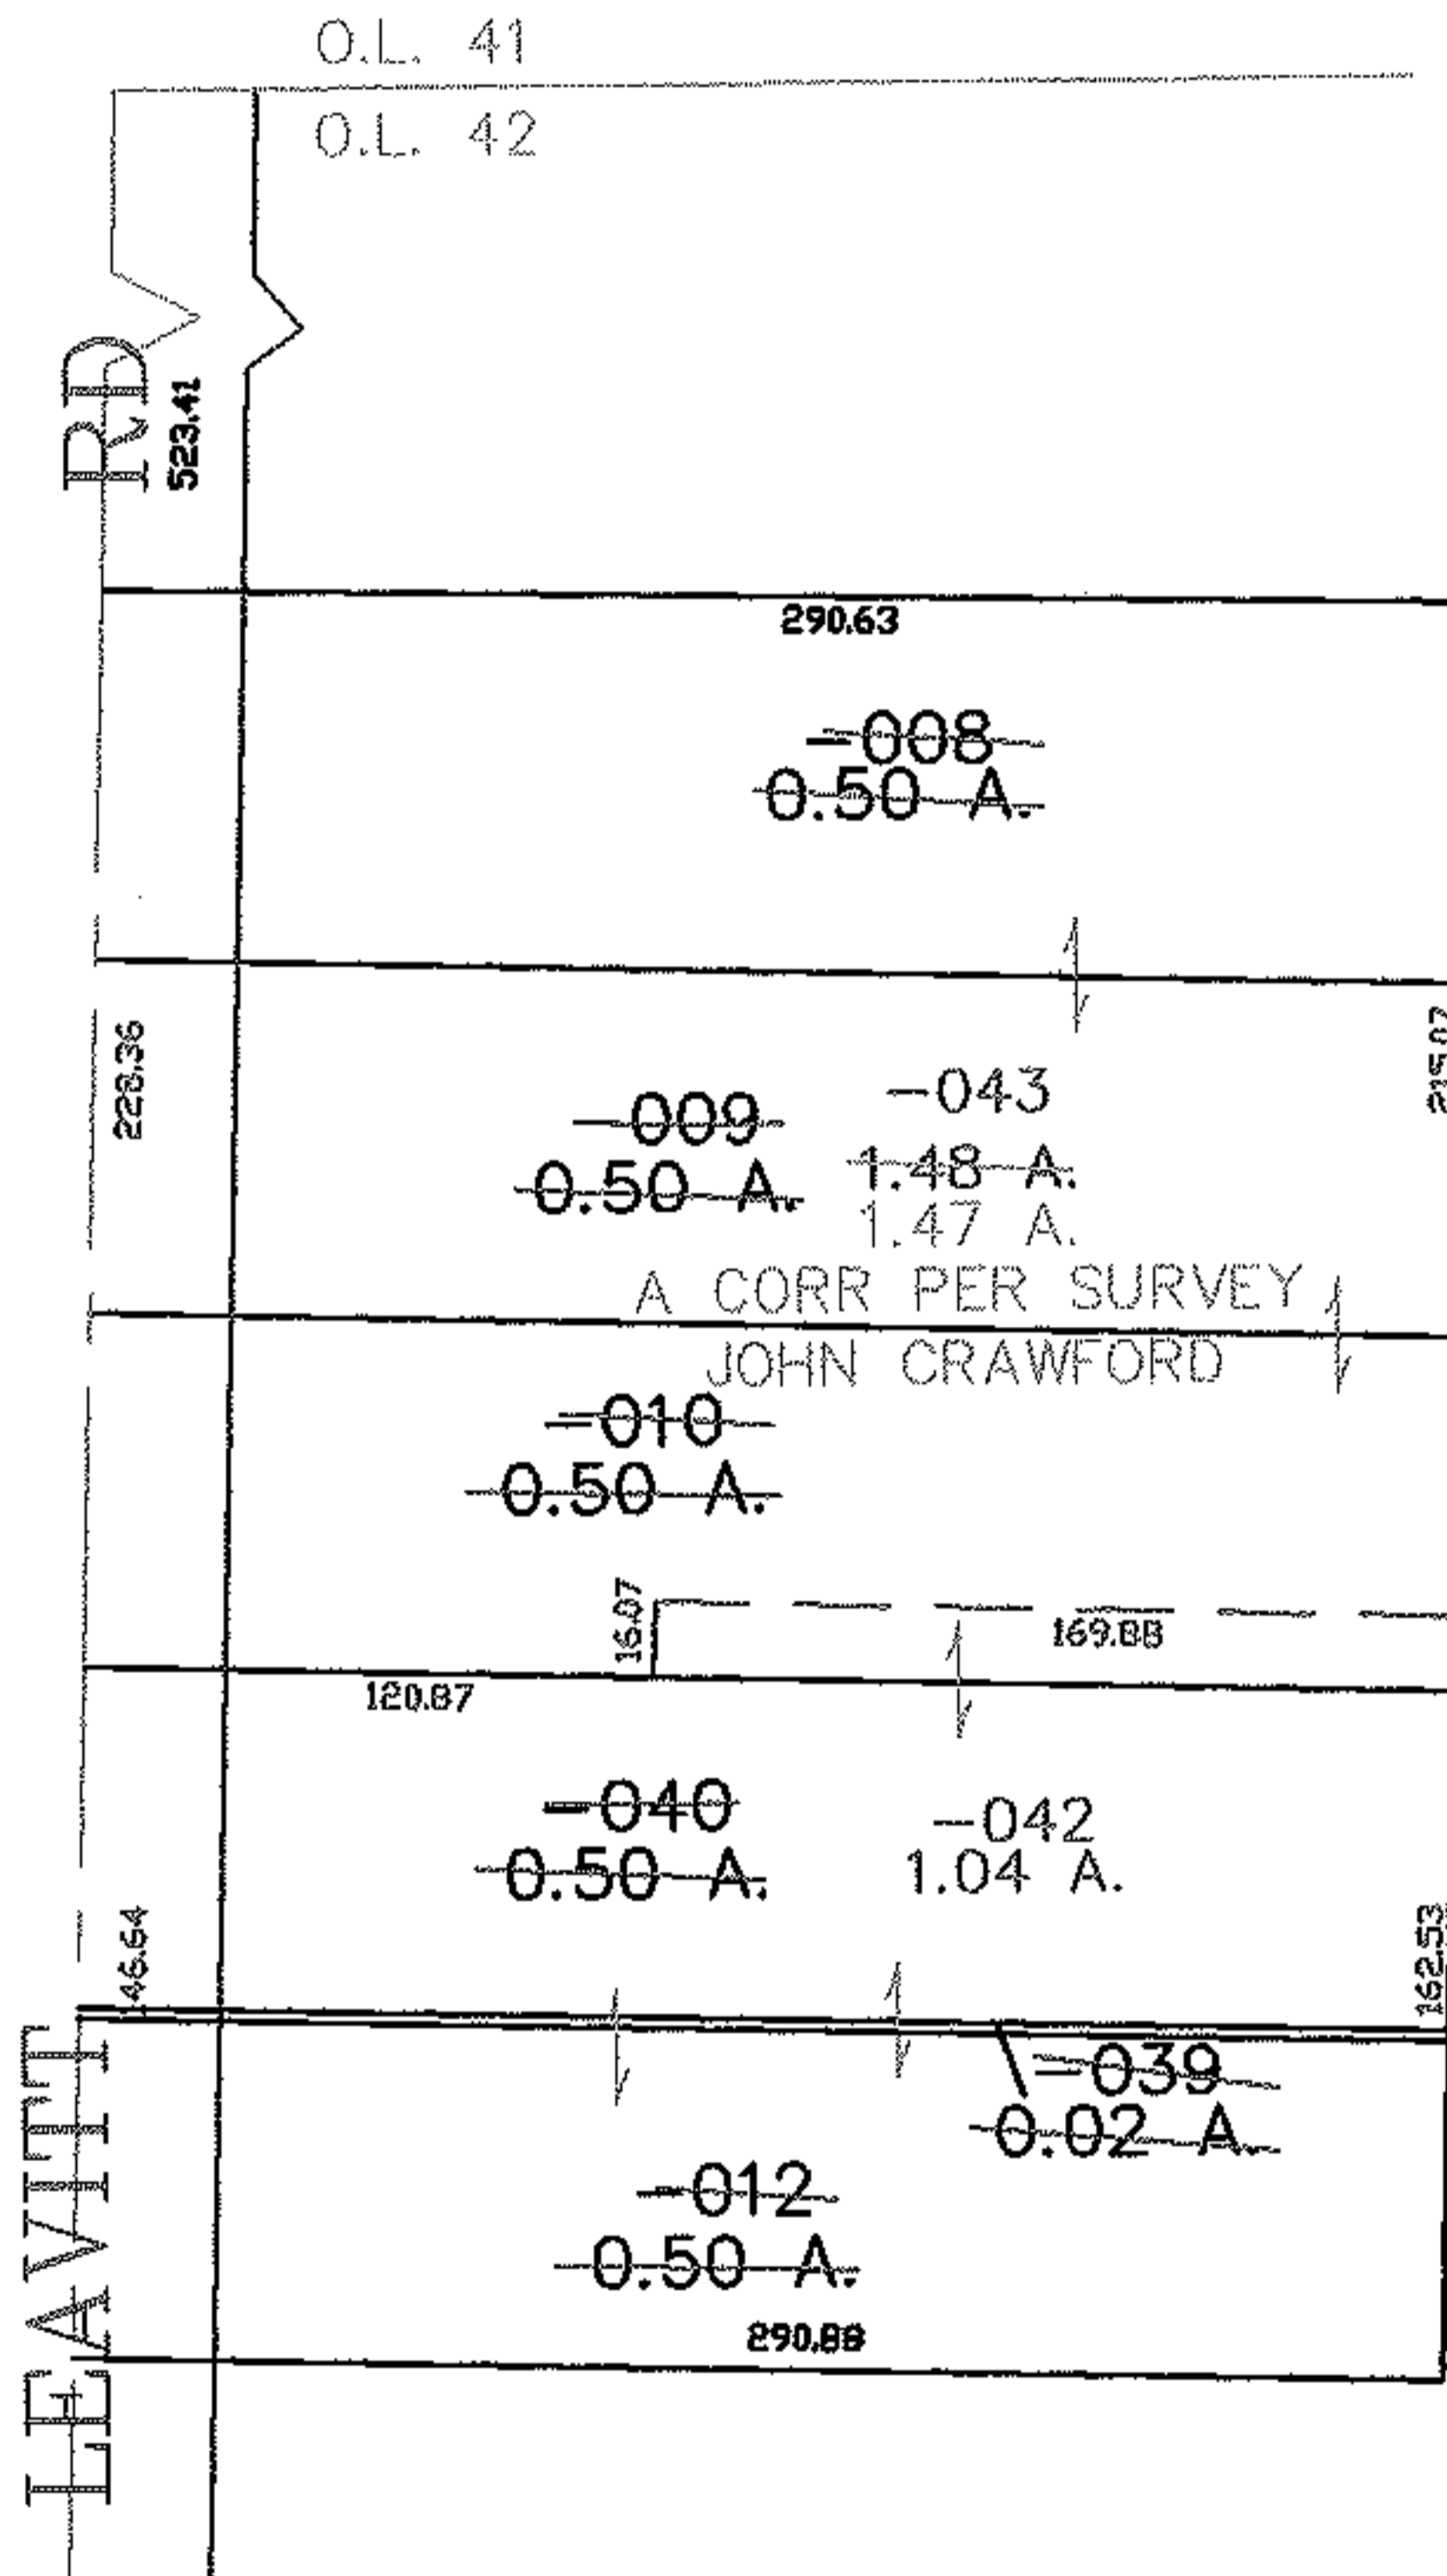


PARENT PARCEL: 05-00-042-101-039, 040, 008 THRU -010, -012

CHILD PARCEL: 05-00-042-101-042, -043

STARTING POINT: CENTERLINE OF LEAVITT RD & O.L. 42

06-02212

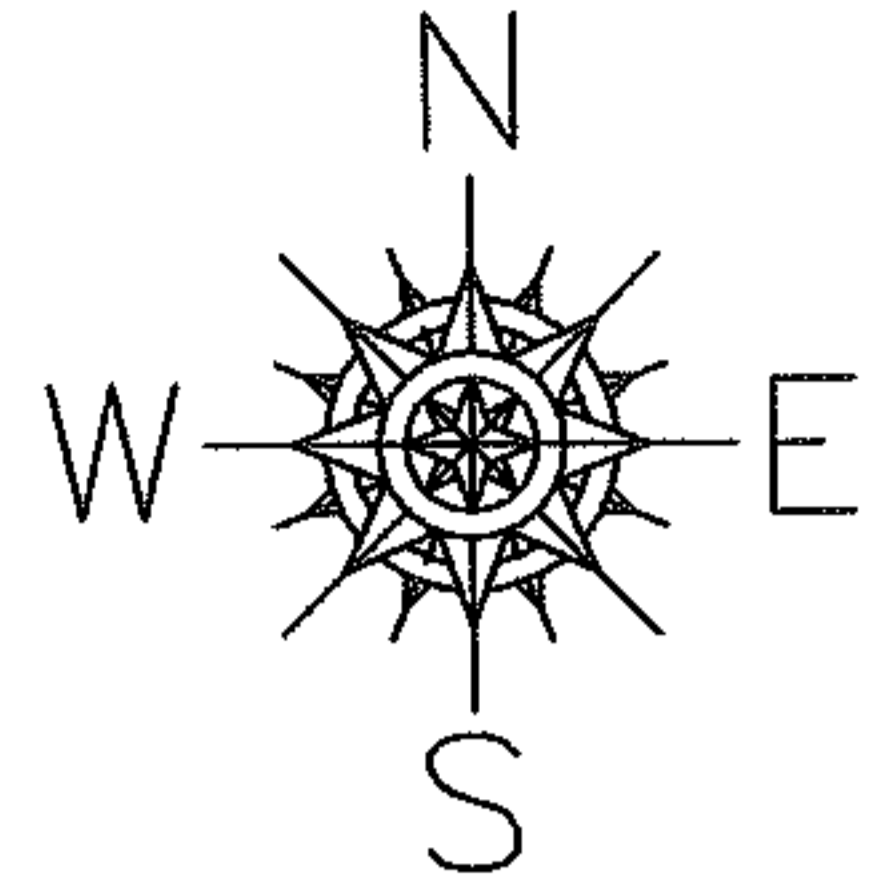

SPLITS/DEEDS PROCESSED

LORAIN COUNTY TAX MAP DEPARTMENT
226 MIDDLE AVE. ELYRIA, OHIO

SURVEYED BY: JOHN CRAWFORD
 CLOSURE: 0.00 : 10.000
 MAP PAGE(S): 05-00-042-A
 APPROVED BY: JAH DATE: 9-6-06
 SCALE: 1" = 100 PRIOR INSTRUMENT: 2005087956