



RASTER

PARENT PARCEL: 09-00-085-112-068, -069, & -070

CHILD PARCEL: 09-00-085-112-091

11-02213-A

STARTING POINT: DRILL HOLE FD, NORTH LINE OF VINE ST. & WEST LINE OF SOUTH MAIN ST.

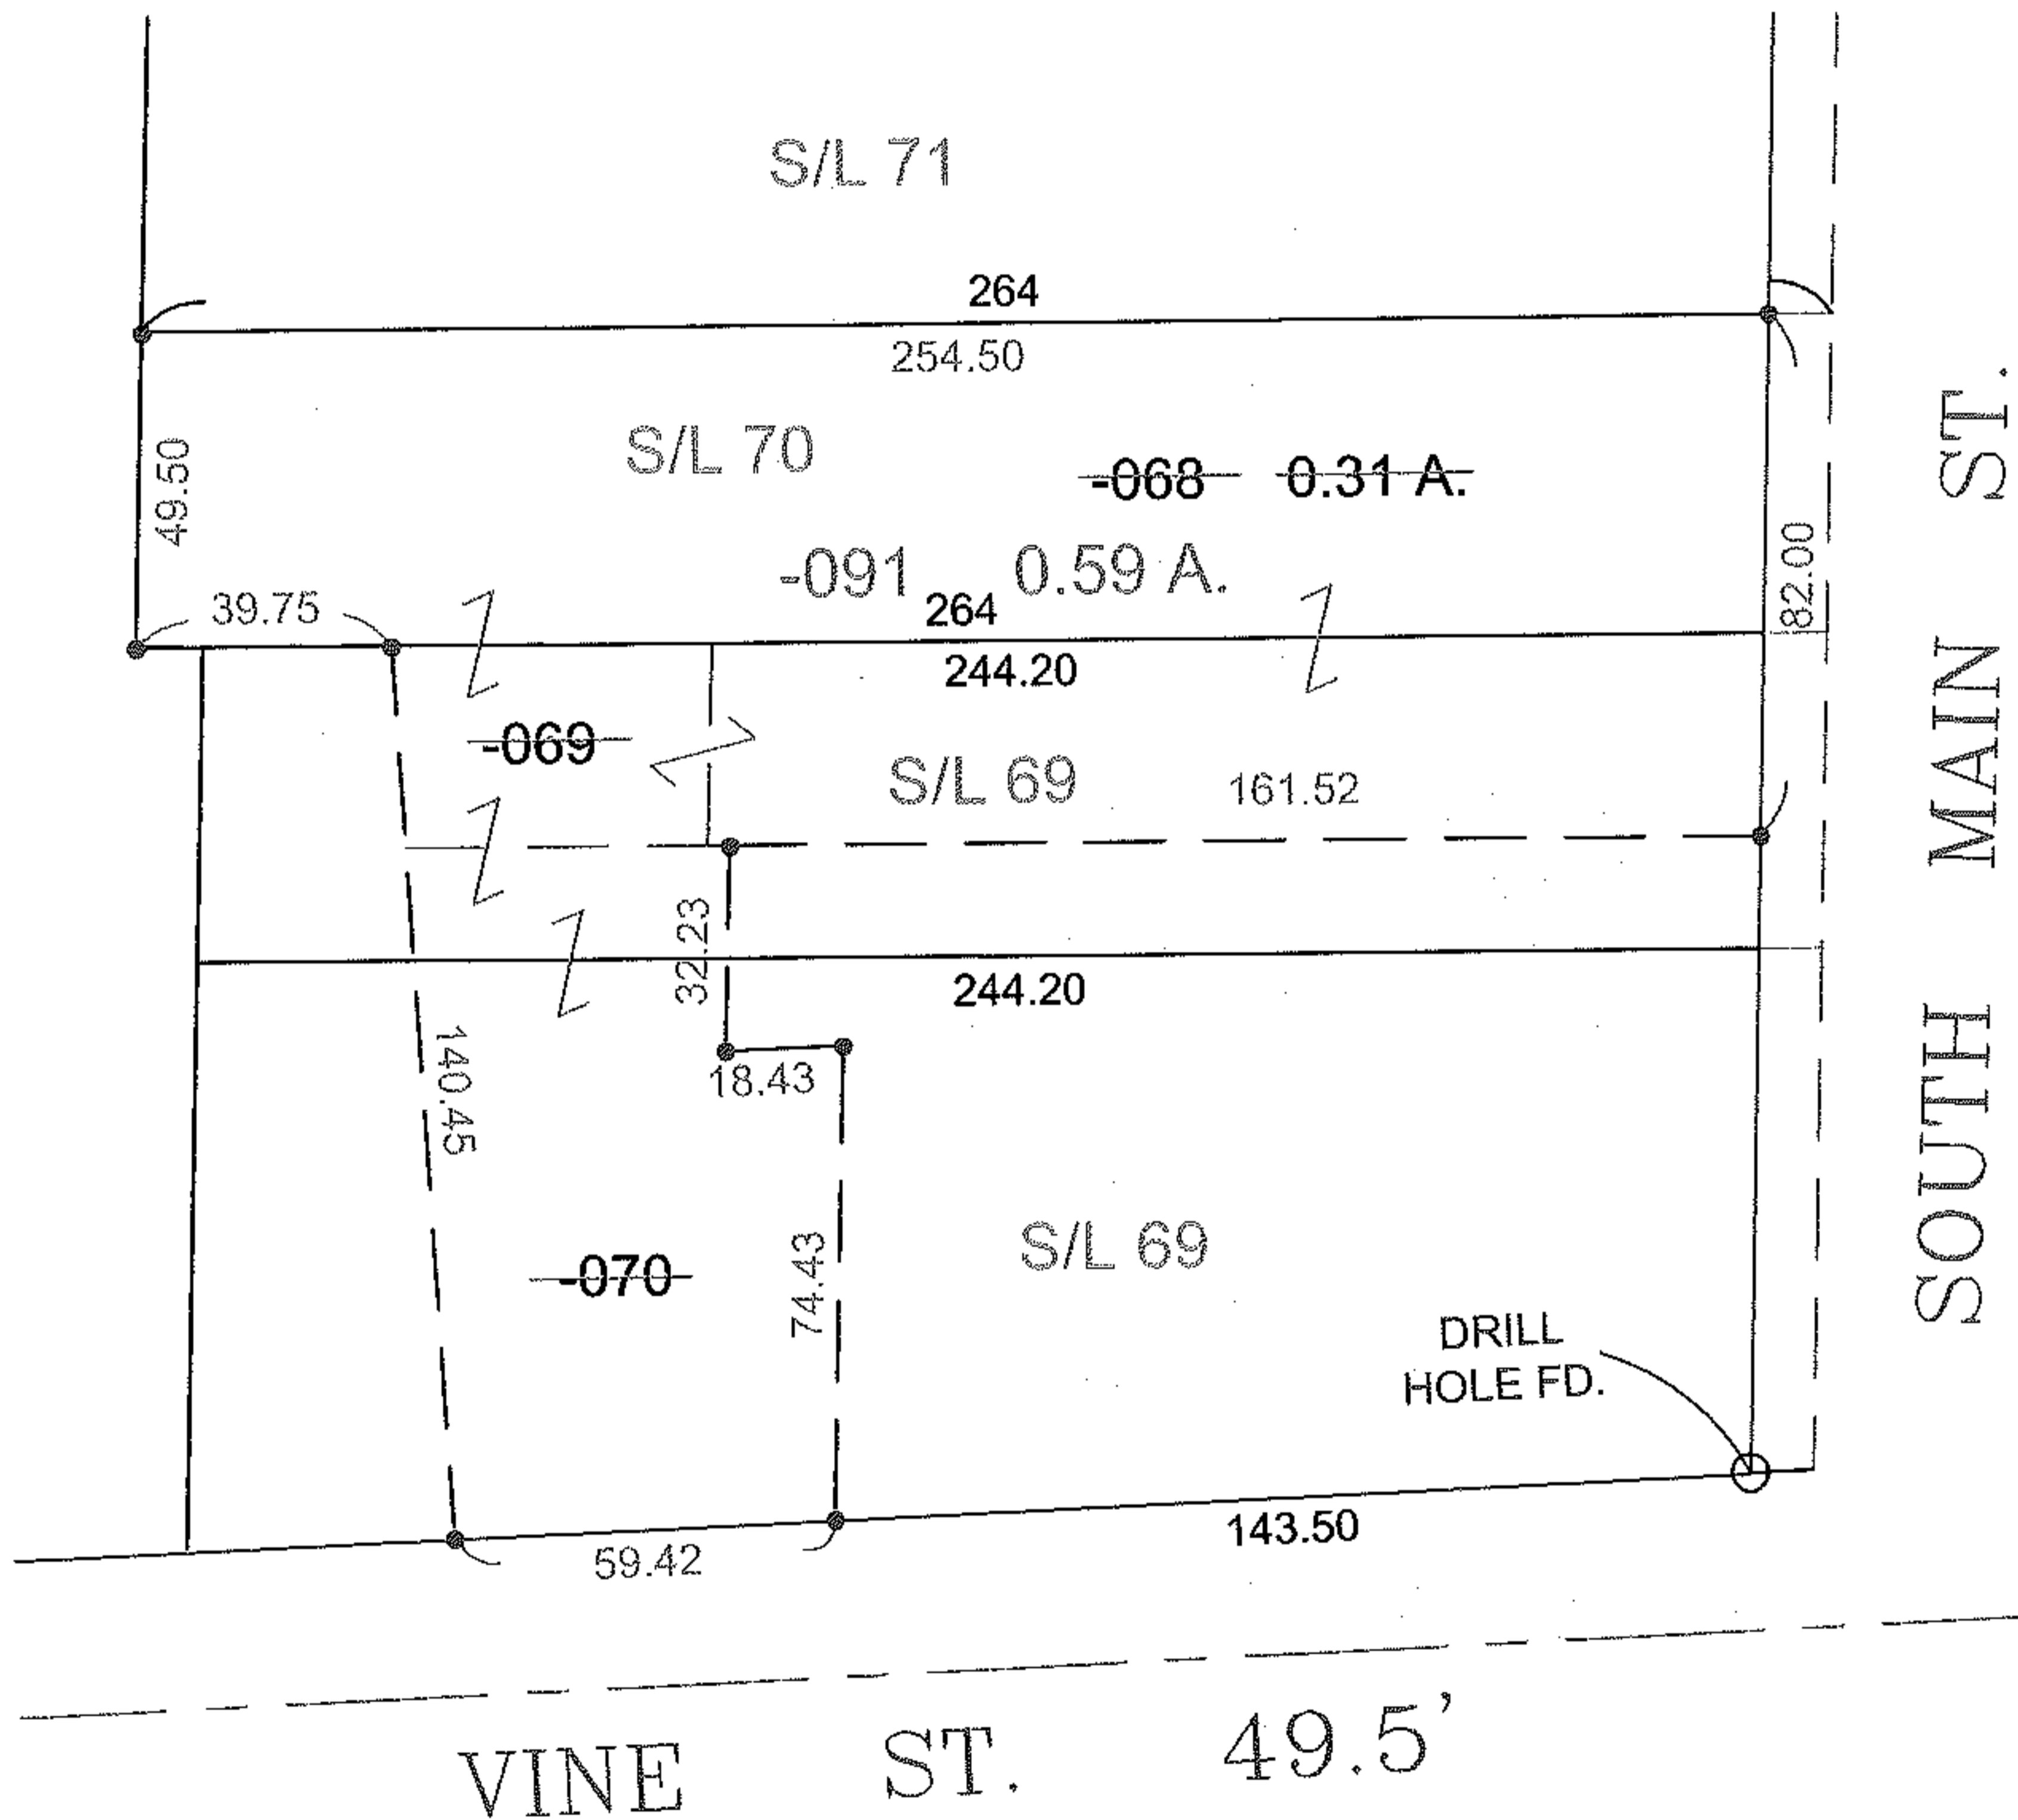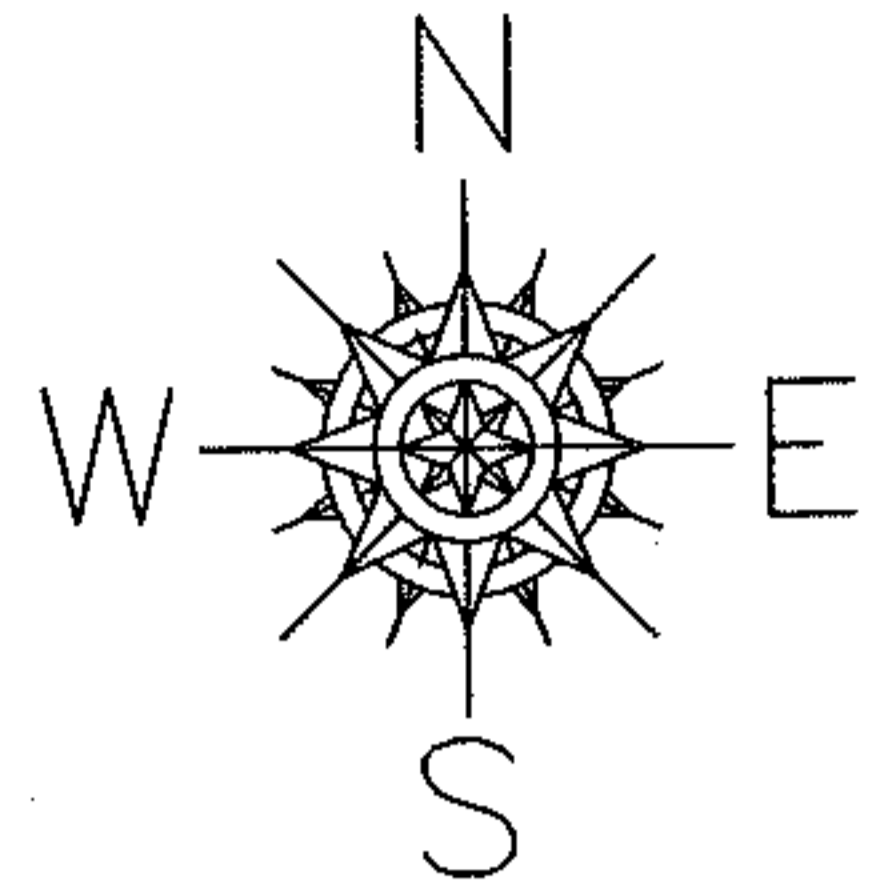

**SPLITS/DEEDS PROCESSED**

LORAIN COUNTY TAX MAP DEPARTMENT  
226 MIDDLE AVE. ELYRIA, OHIO

SURVEYED BY: RIDHARD A. FREDRICKSON

CLOSURE: 0.01: 10,000

MAP PAGE(S): 9-00-085-B

APPROVED BY: TJS DATE: 1/26/11

SCALE: 1"= 50' PRIOR INST.: 20100343340