




RASTER

PARENT PARCEL: 03-00-020-000-020

CHILD PARCEL: 03-00-020-000-028, -029

STARTING POINT: CENTERLINE OF OSTER RD & ABBE RD

06-02213

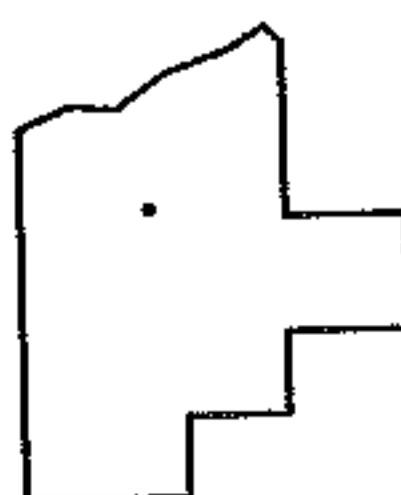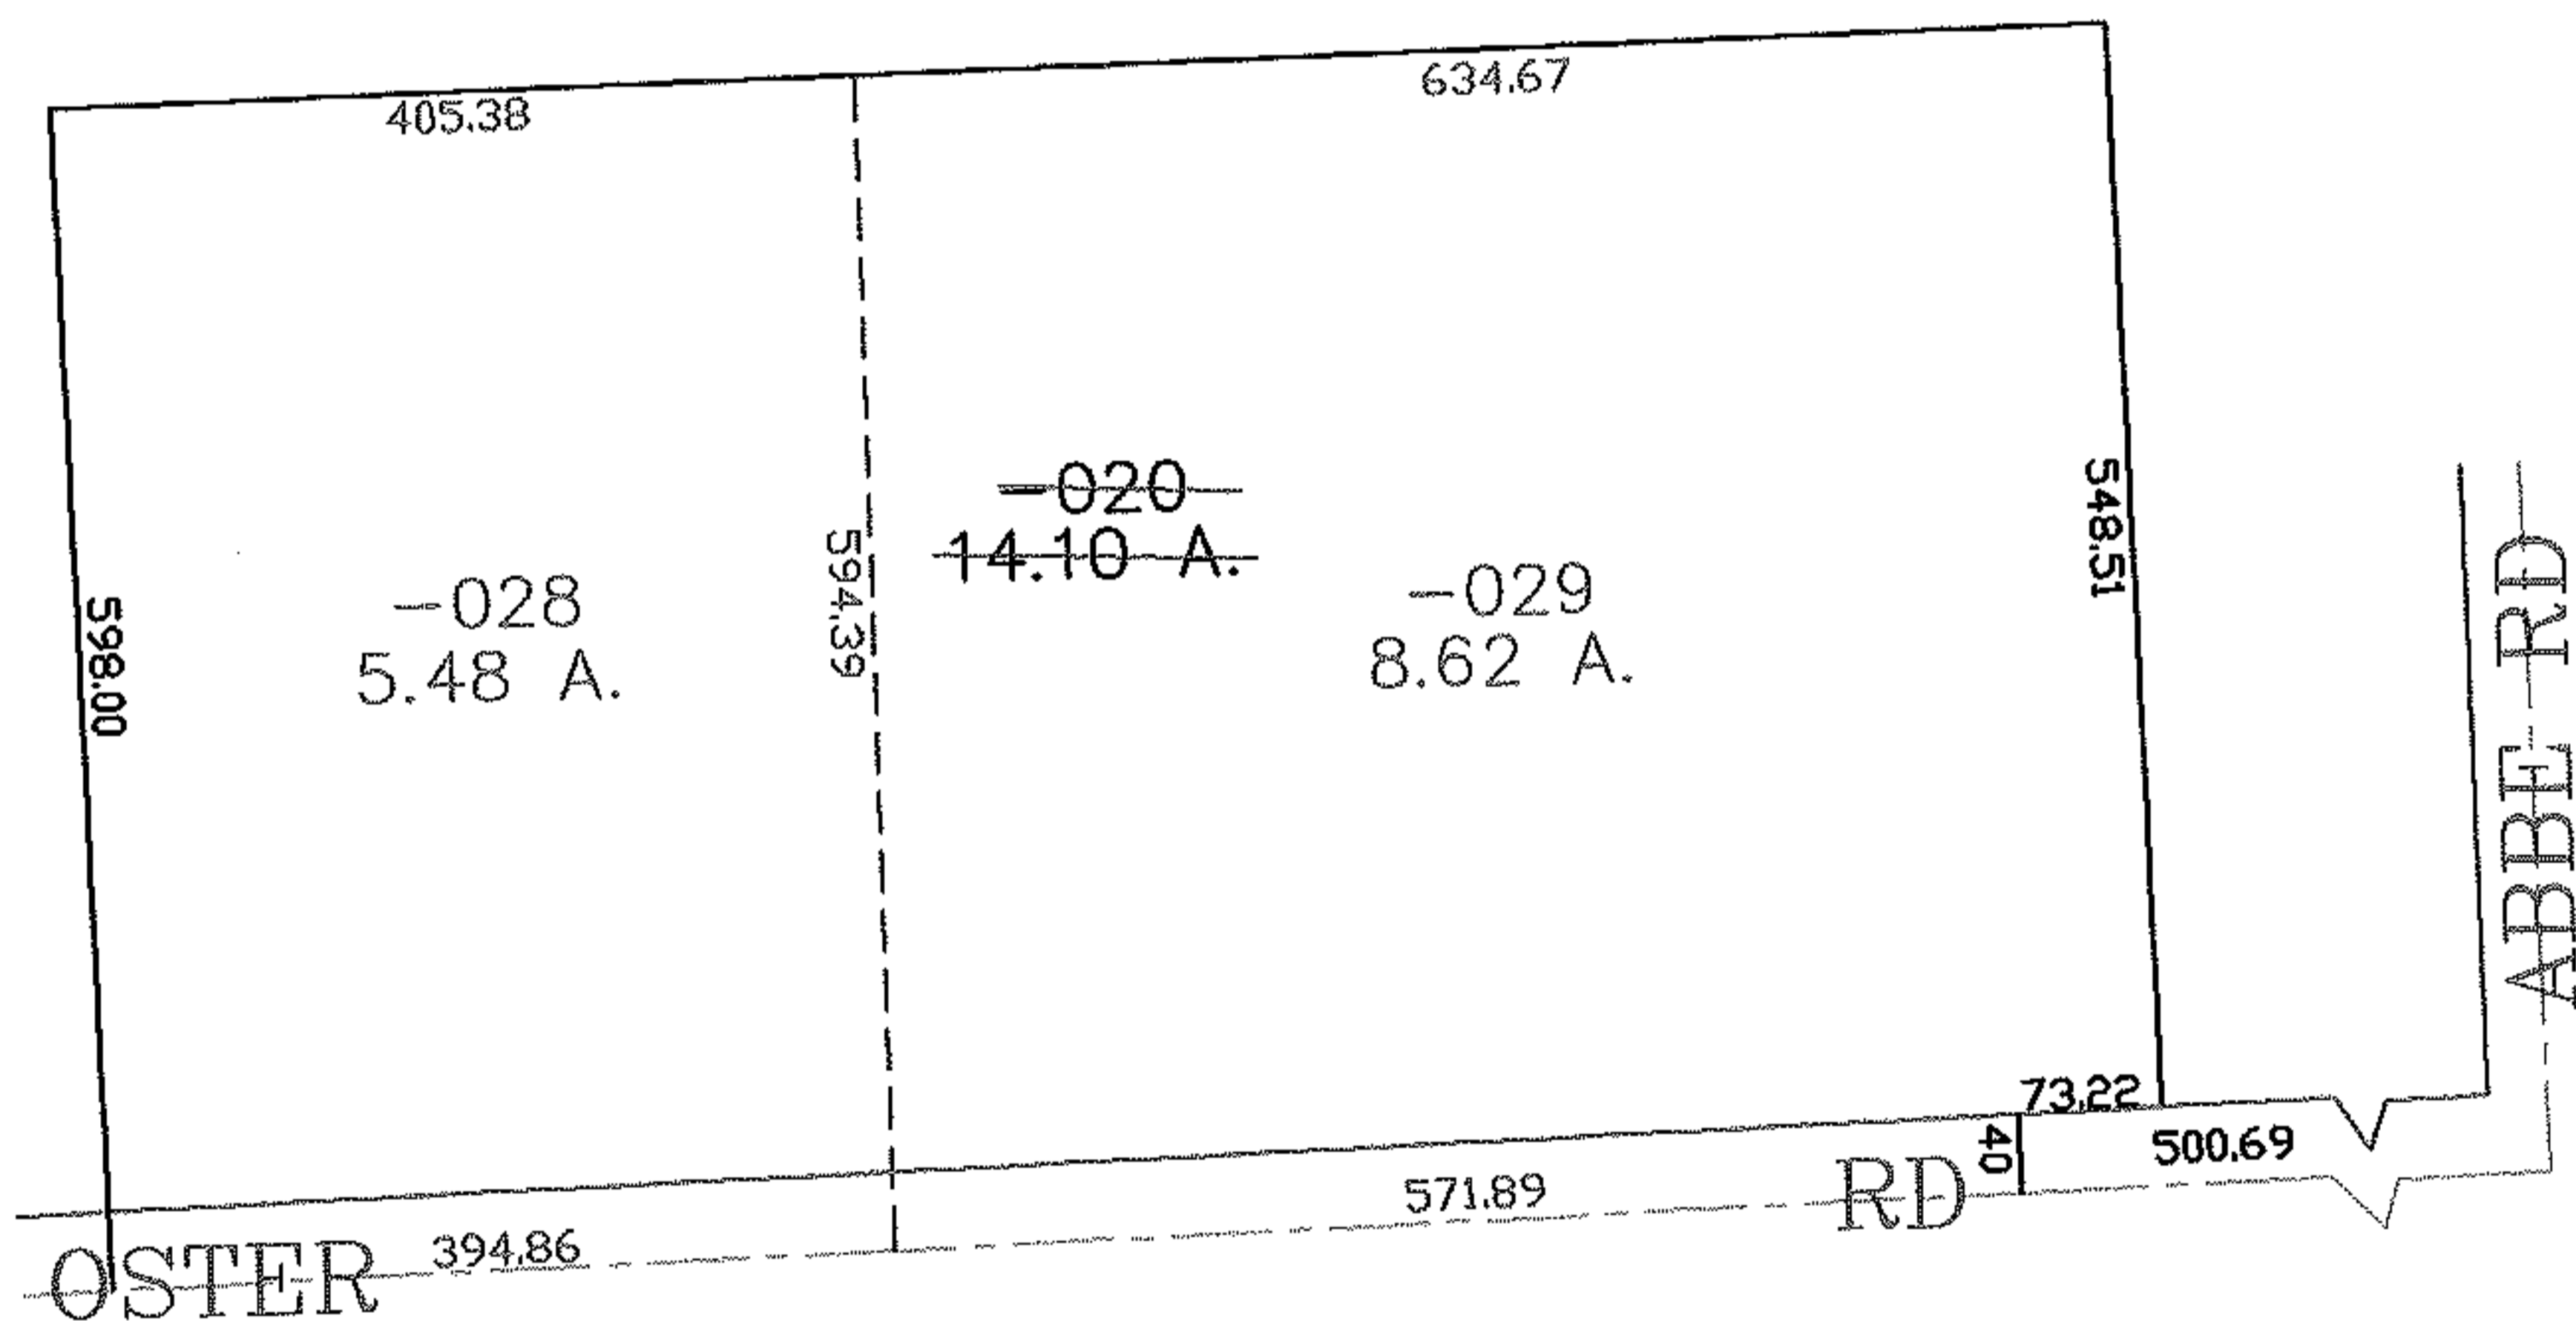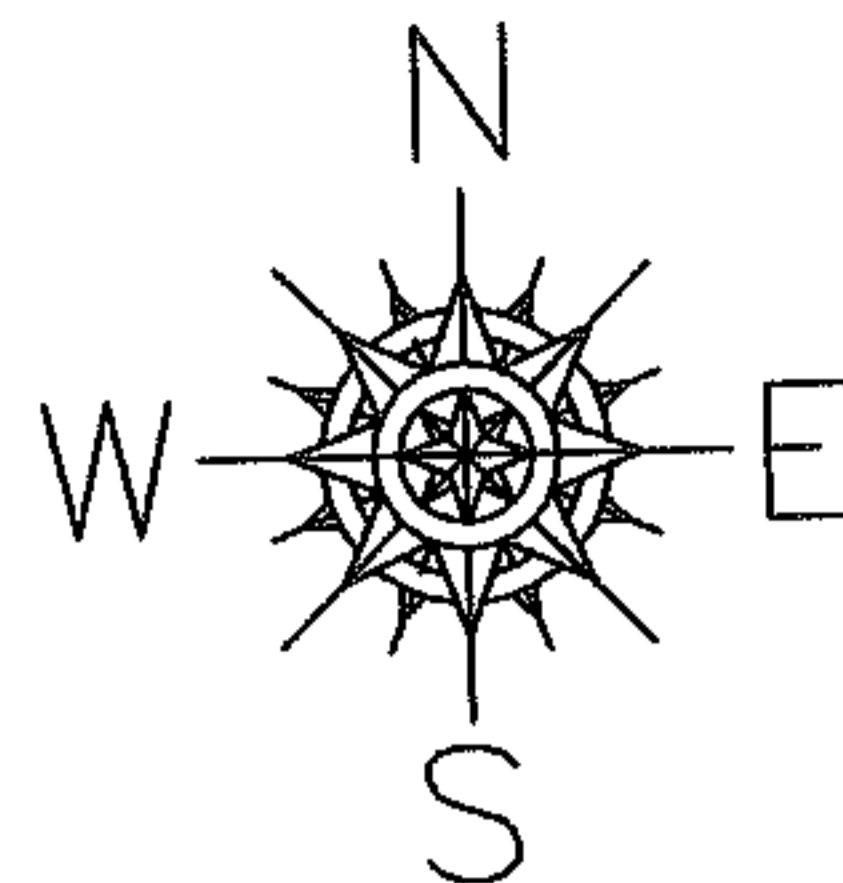

SPLITS/DEEDS PROCESSED

LORAIN COUNTY TAX MAP DEPARTMENT
226 MIDDLE AVE. ELYRIA, OHIO

SURVEYED BY: DAVID ELWELL

CLOSURE: 0.00 : 10.000

MAP PAGE(S): 03-00-020-B

APPROVED BY: JAH DATE: 8-29-06

SCALE: 1" = 200 PRIOR INSTRUMENT: 20050063354