
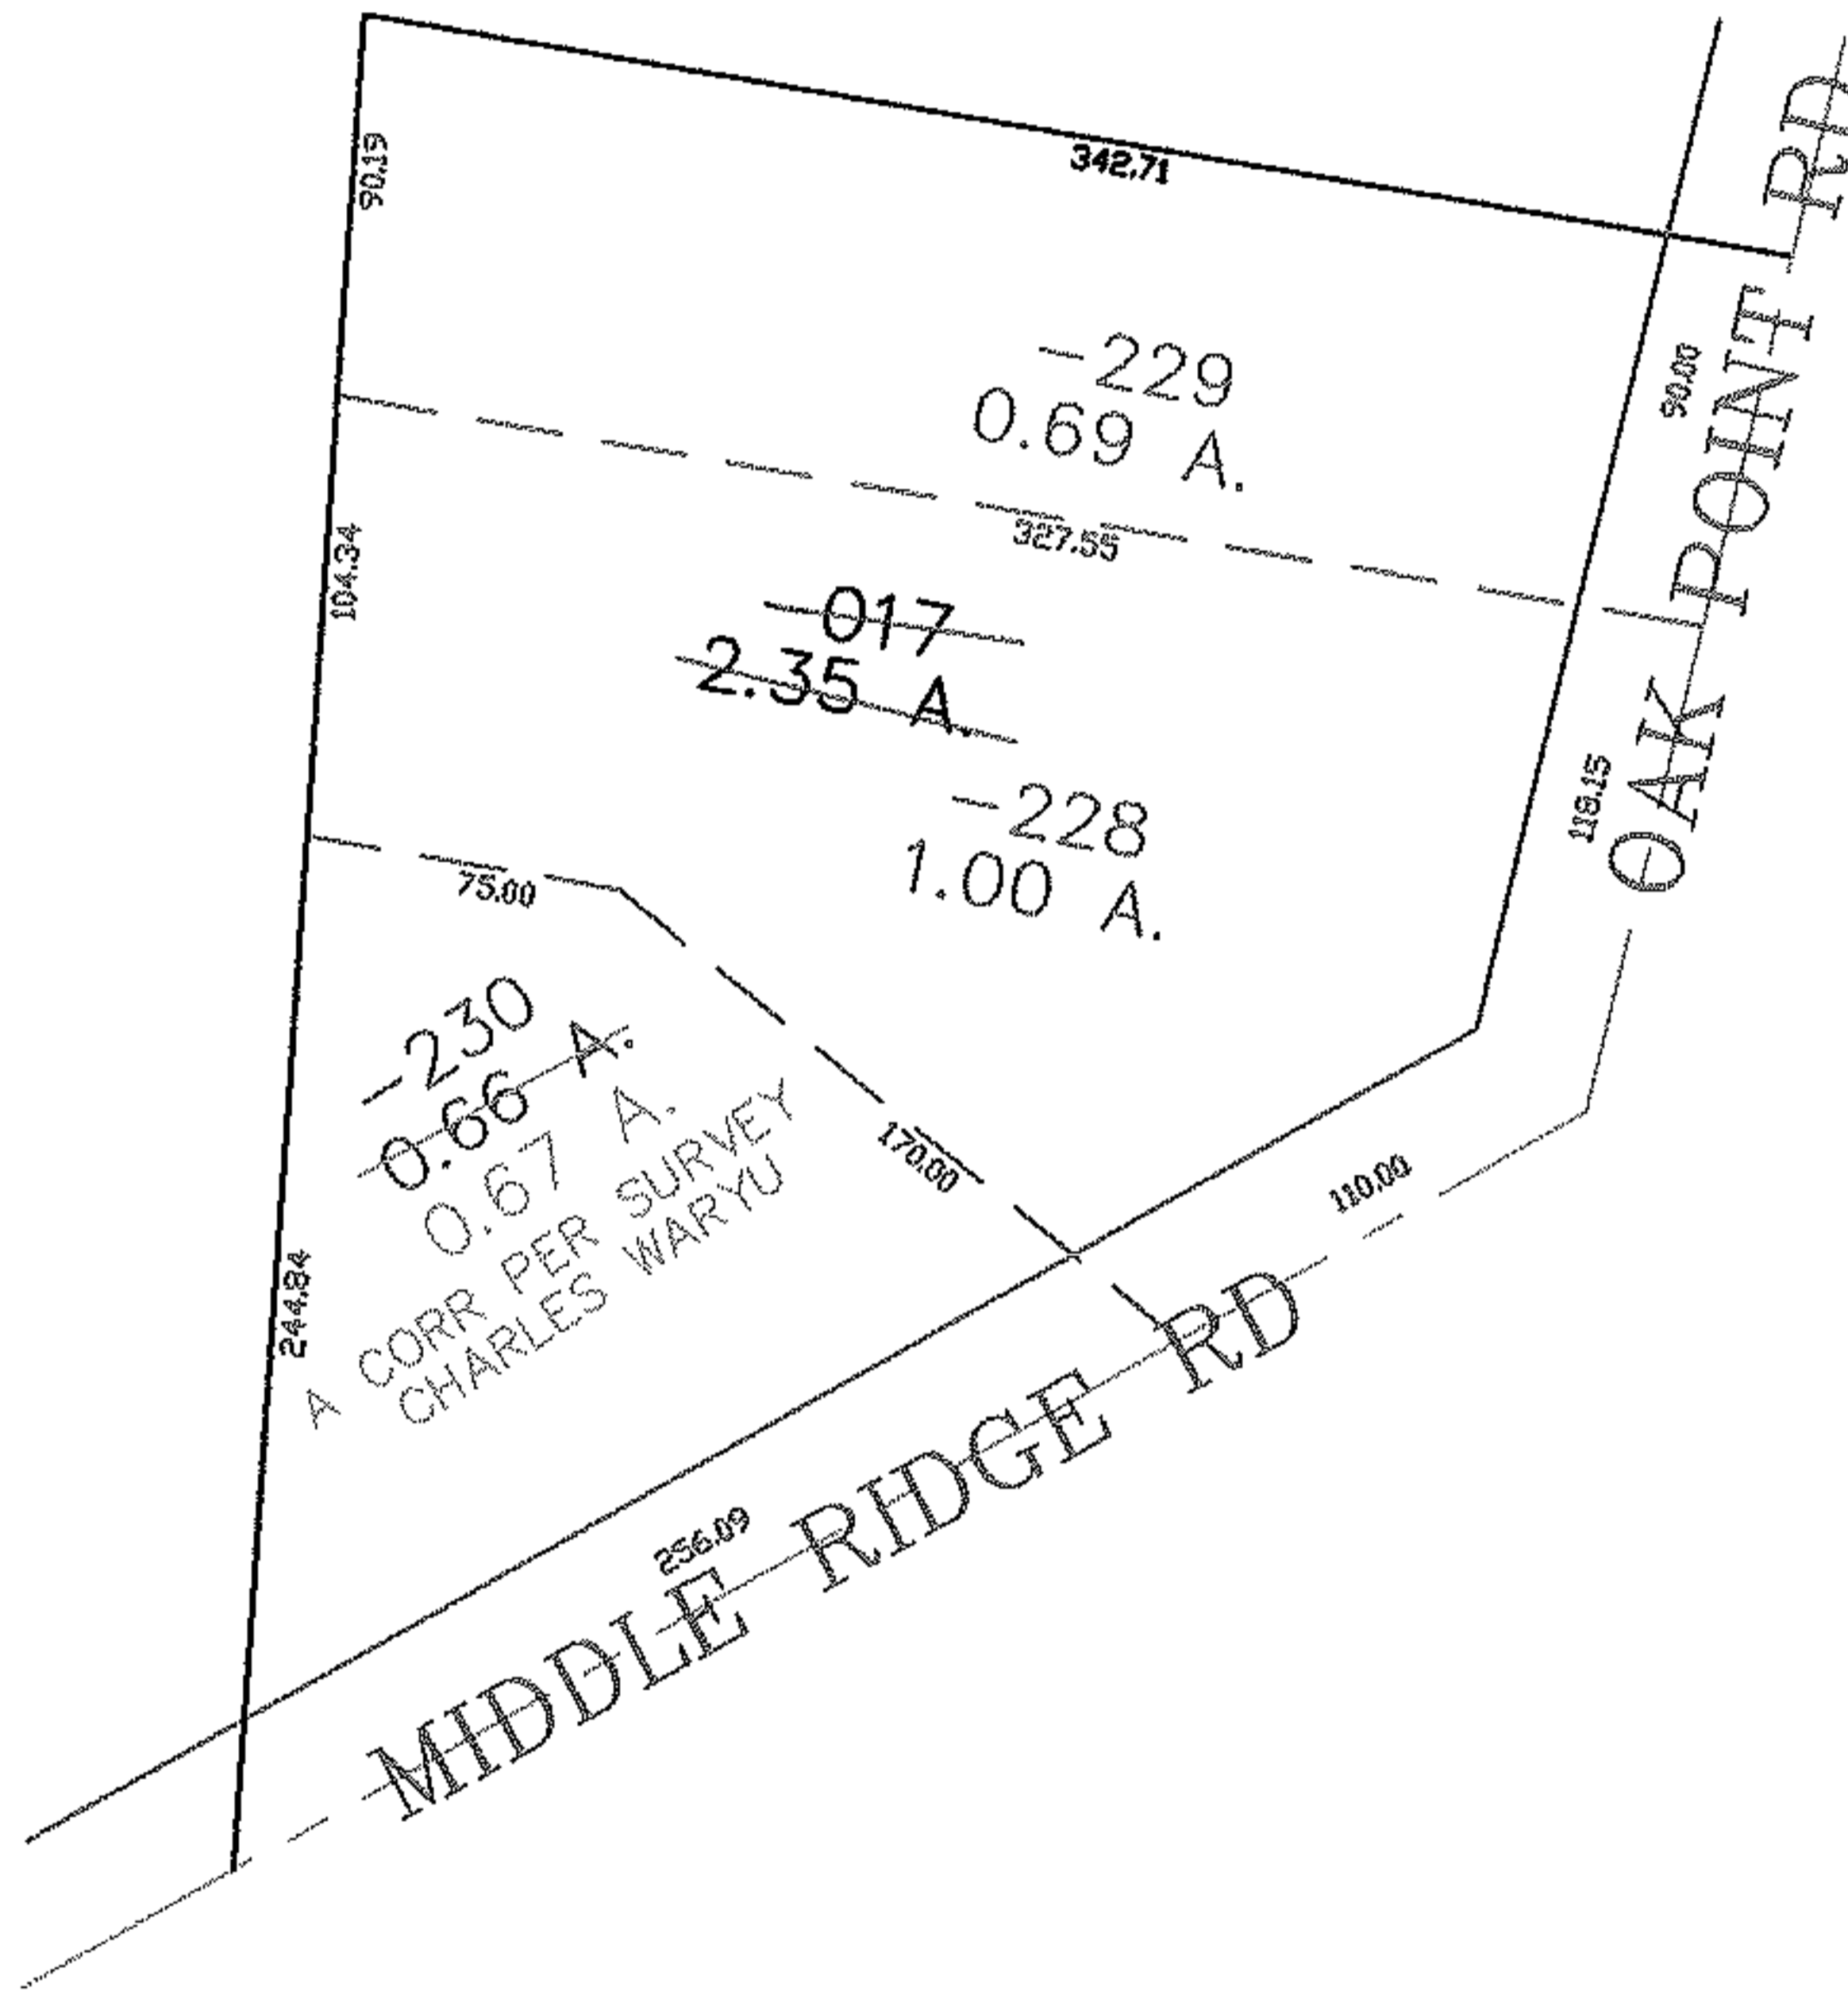


PARENT PARCEL: 05-00-006-000-017

CHILD PARCEL: 05-00-006-000-228, -229, -230

STARTING POINT: CENTERLINE OF MIDDLE RIDGE RD & OAK POINT RD

06-02215

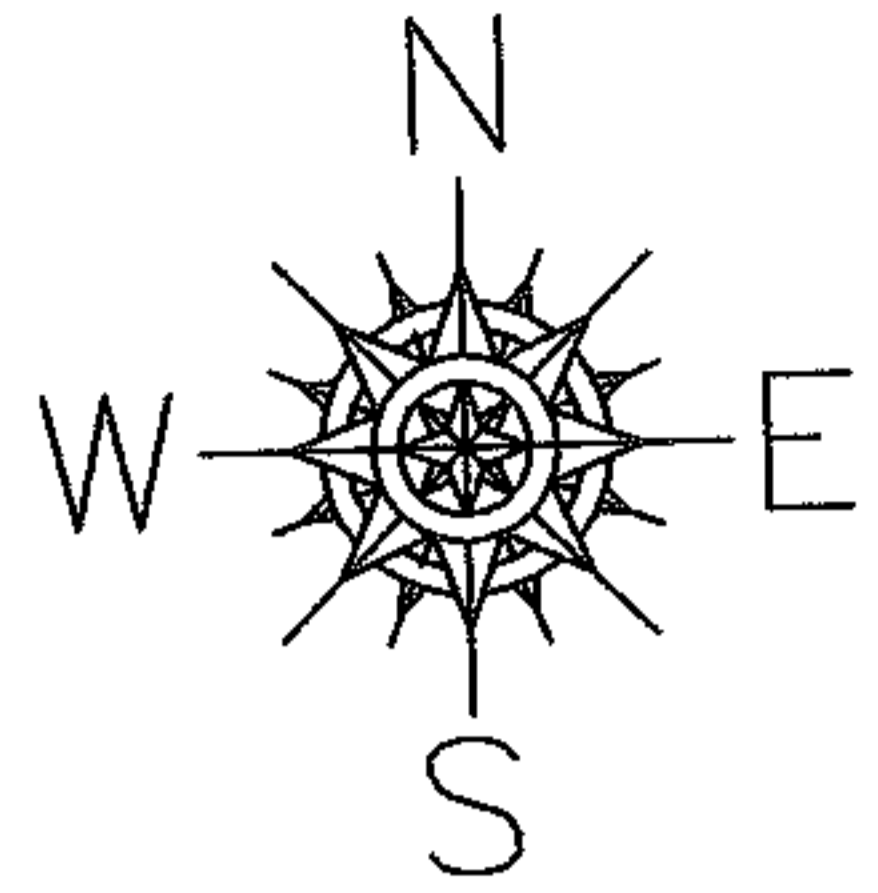

SPLITS/DEEDS PROCESSED

LORAIN COUNTY TAX MAP DEPARTMENT
226 MIDDLE AVE. ELYRIA, OHIO

SURVEYED BY: CHARLES WARYU

CLOSURE: 0.00 : 10.000

MAP PAGE(S): 05-00-006-A

APPROVED BY: JAH DATE: 8-31-06

SCALE: 1" = 100 PRIOR INSTRUMENT: 20030916438