
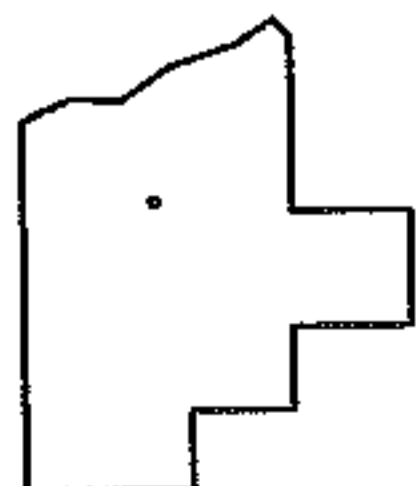
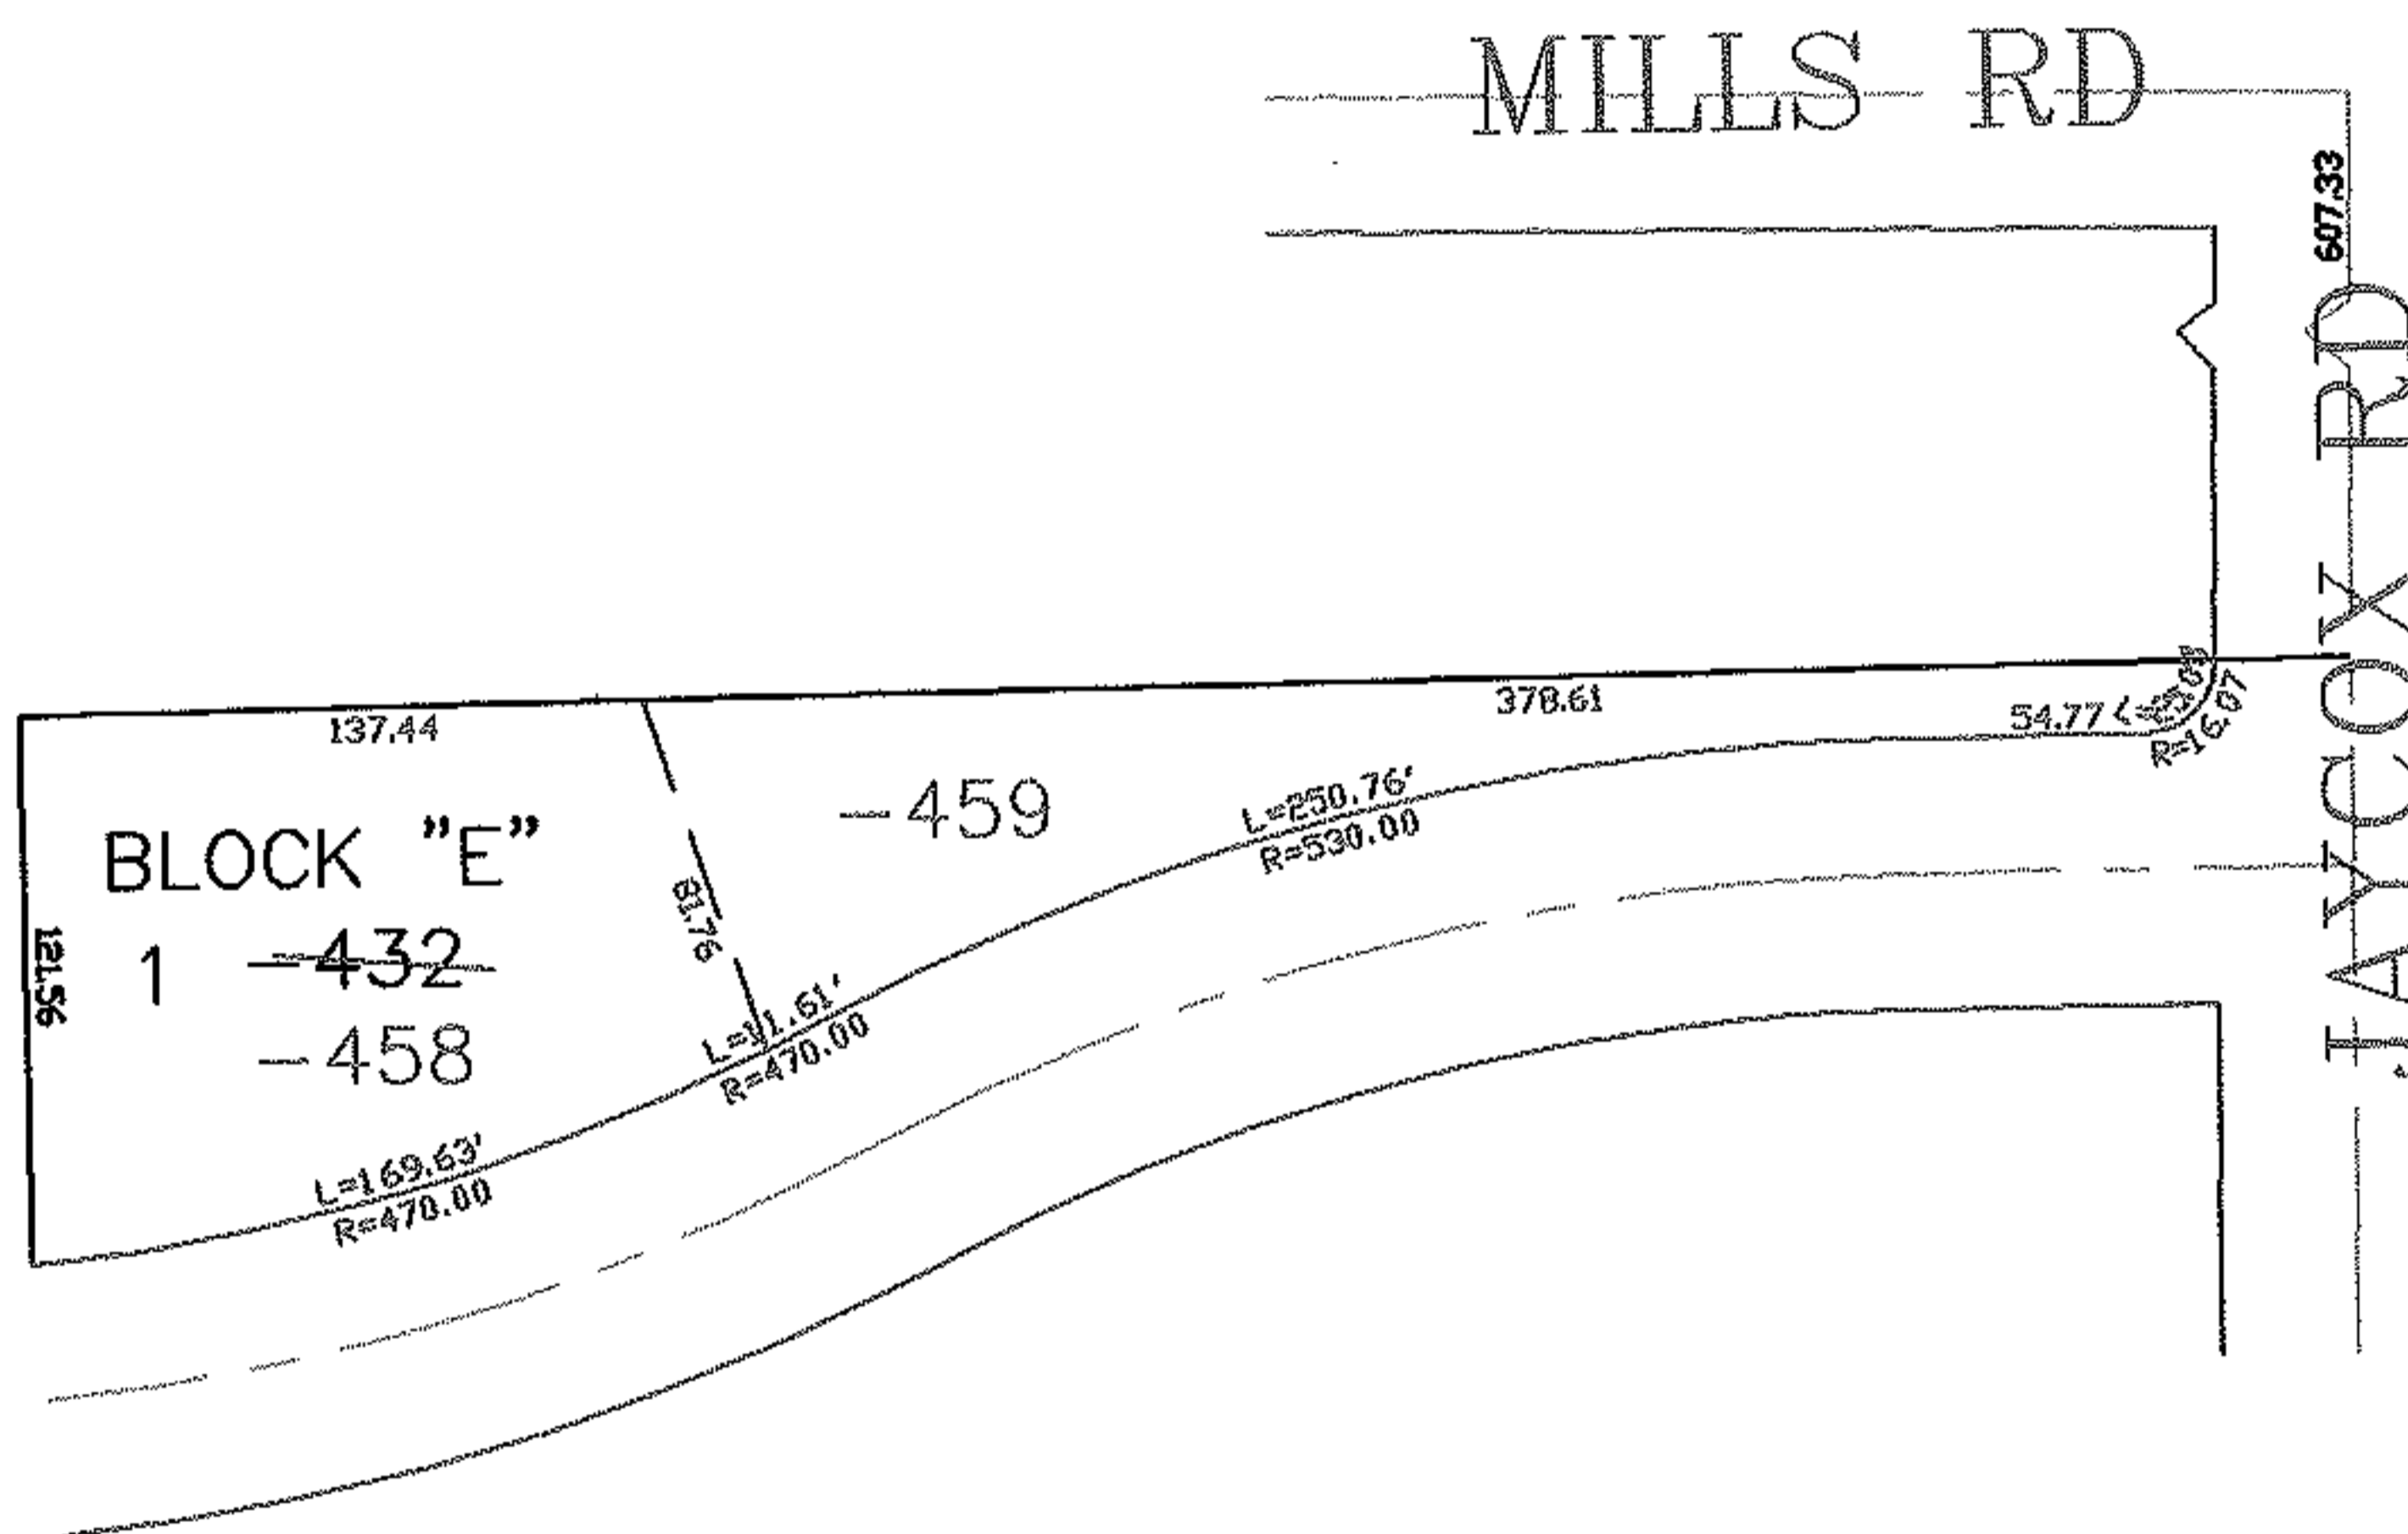


PARENT PARCEL: 07-00-019-000-432

CHILD PARCEL: 07-00-019-000-458, -459

STARTING POINT: CENTERLINE OF MILLS RD & JAYCOX RD

06-02216

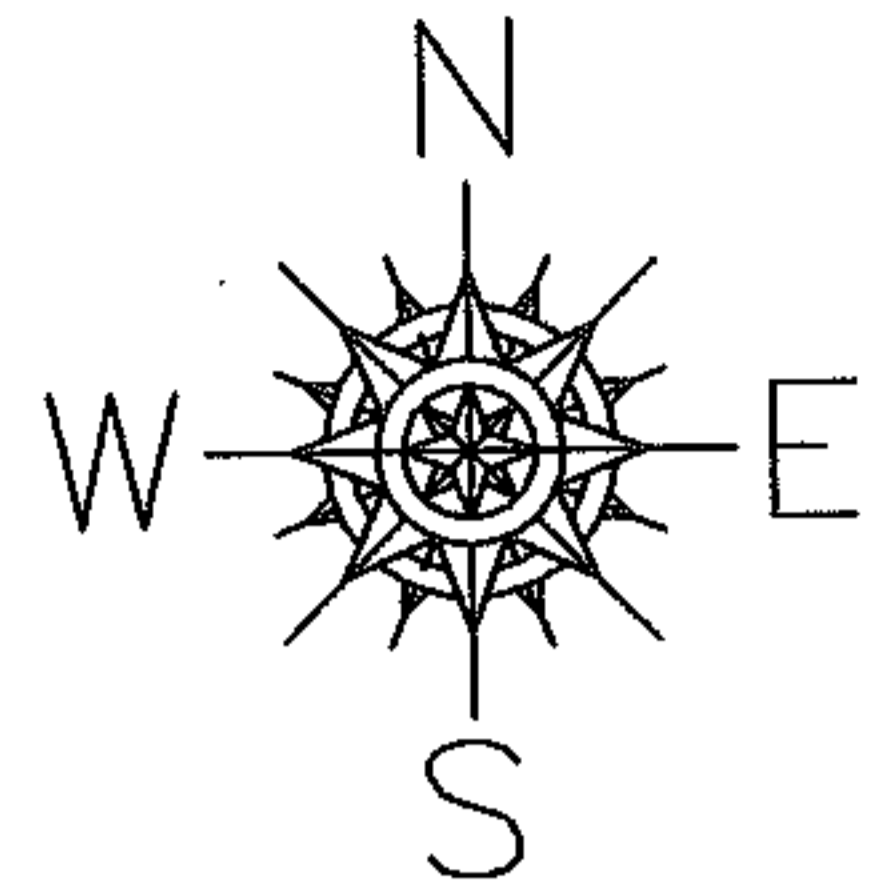

SPLITS/DEEDS PROCESSED

LORAIN COUNTY TAX MAP DEPARTMENT
226 MIDDLE AVE. ELYRIA, OHIO

SURVEYED BY: STUART SAYLER

CLOSURE: 0.00 : 10.000

MAP PAGE(S): 07-00-019

APPROVED BY: JAH DATE: 9-1-06

SCALE: 1" = 100 PRIOR INSTRUMENT: PL VOL 82/37