
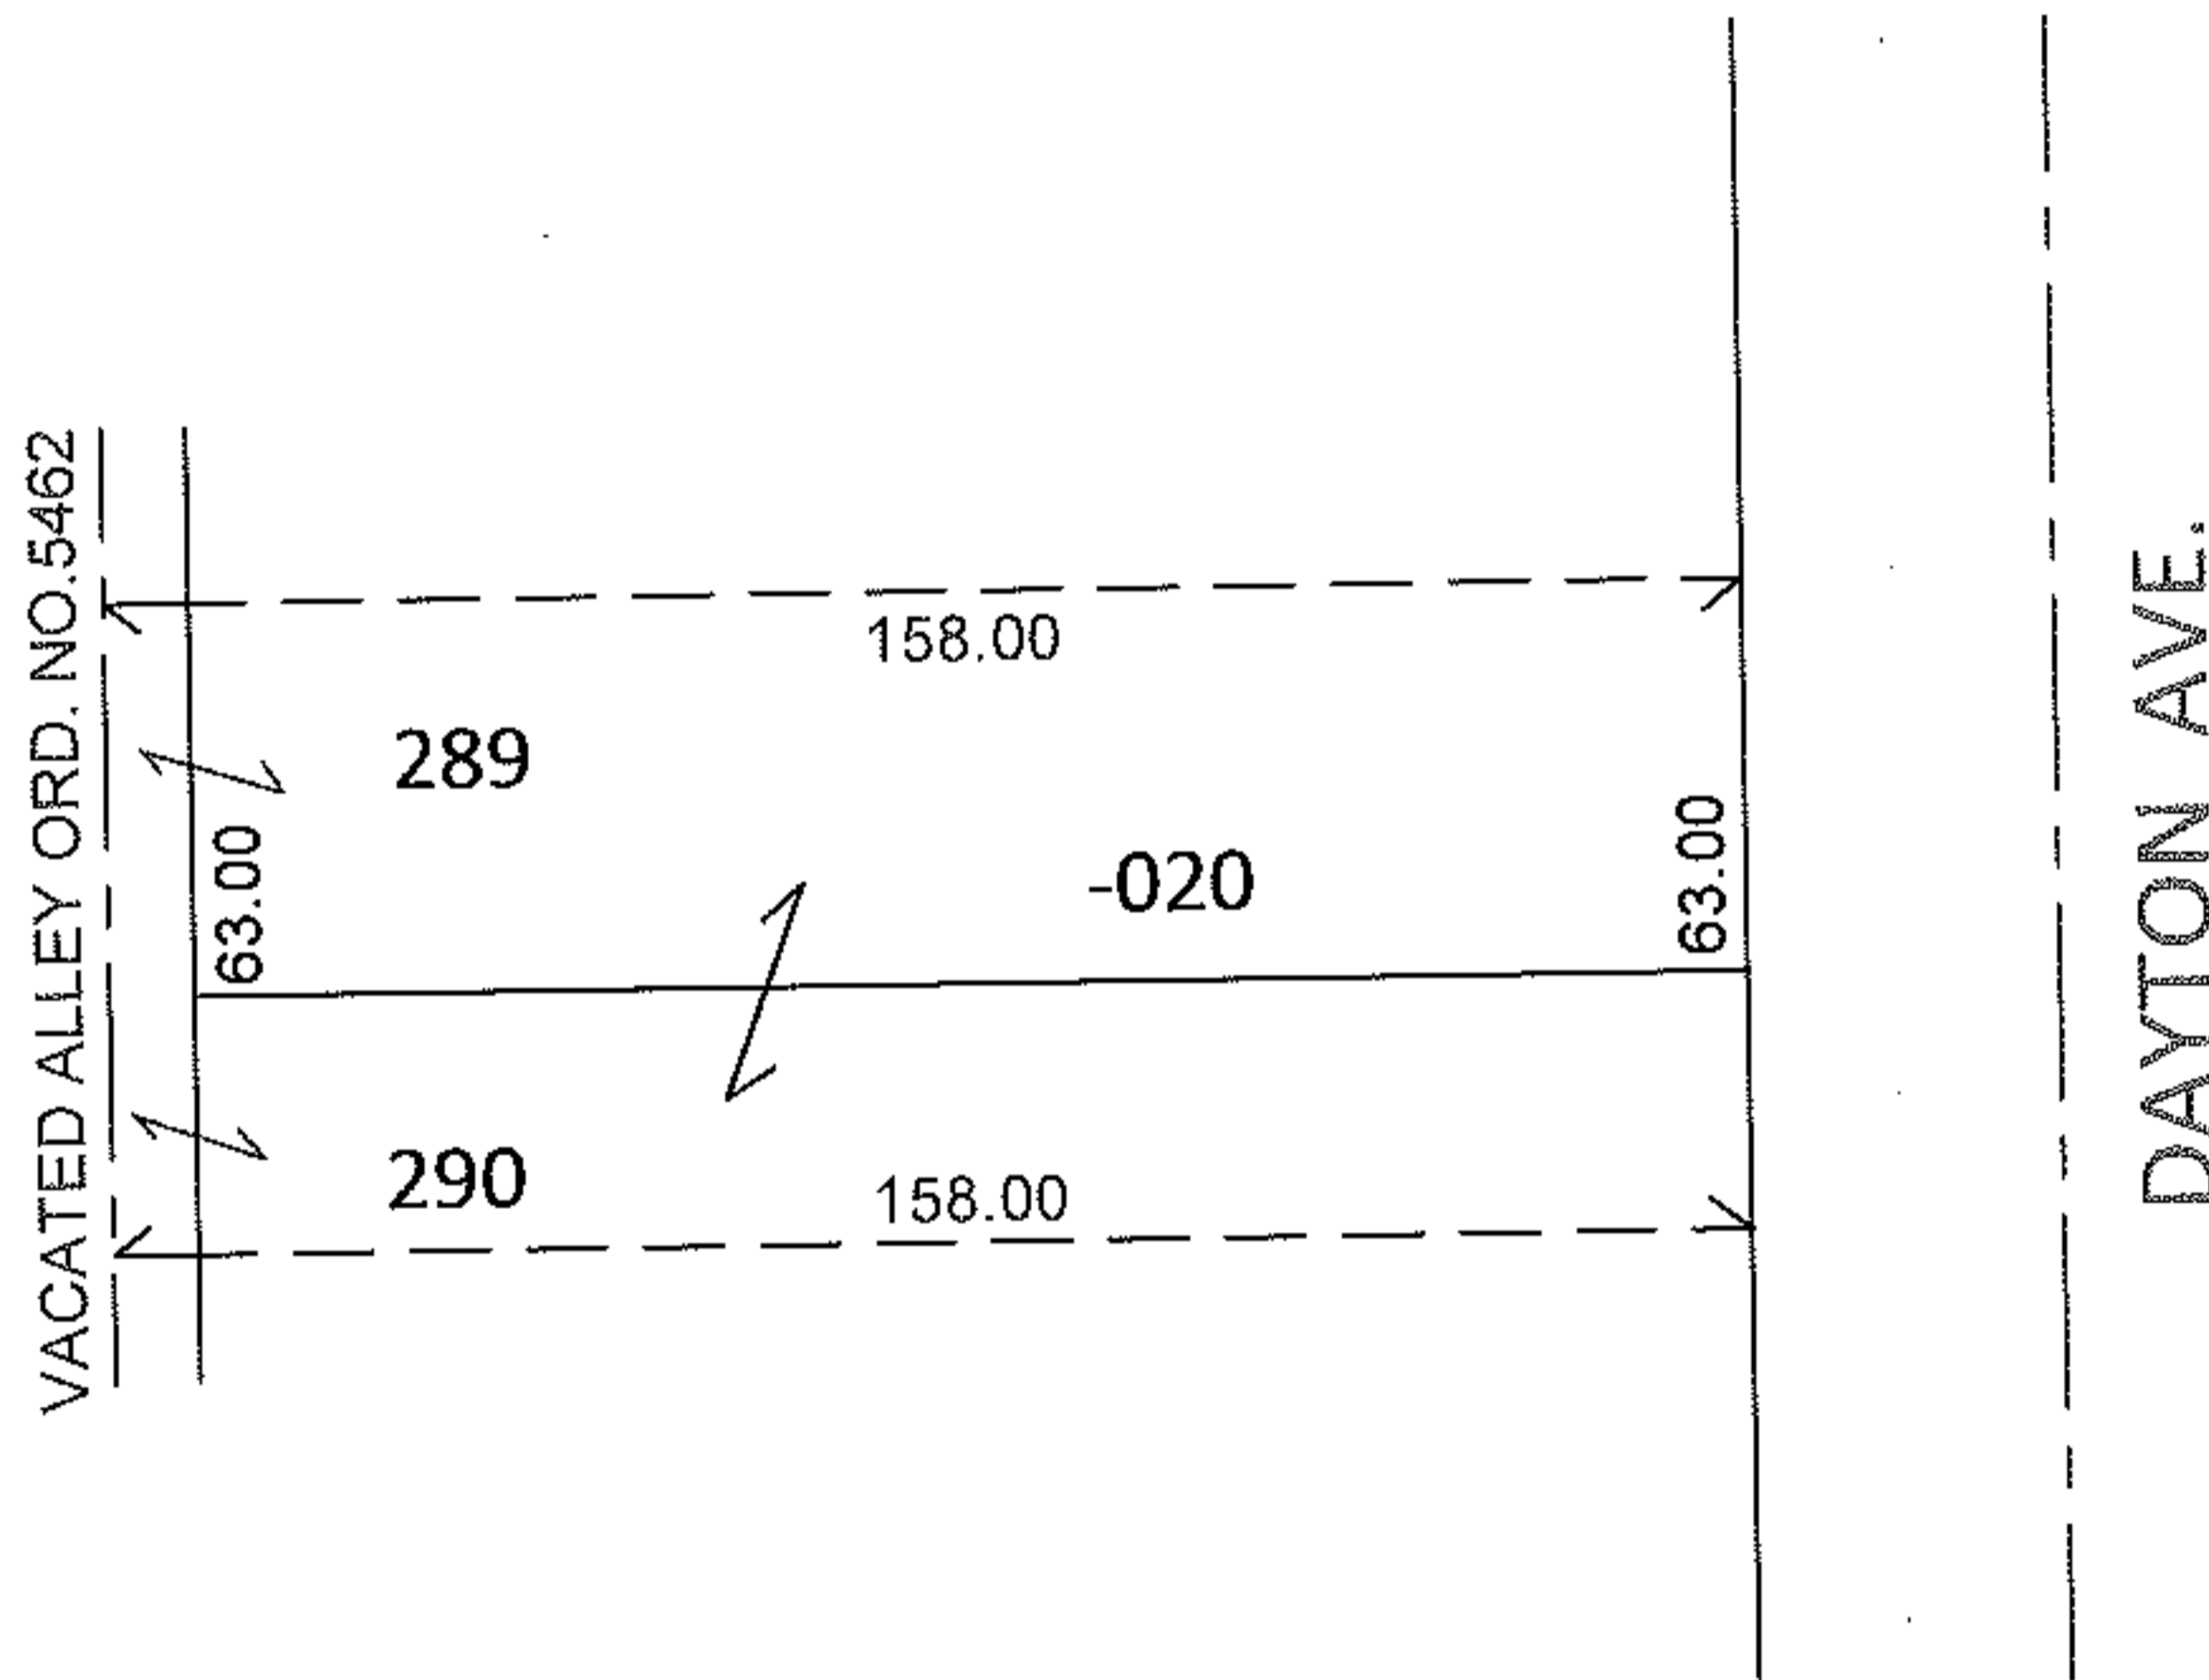


PARENT PARCEL: 02-01-003-231-020

11-02217-C

CHILD PARCEL: _____

STARTING POINT: PART OF S/L'S 289 & 290 IN LORAIN STONE CO'S 2ND SUB.(VOL. 6 PG.37)

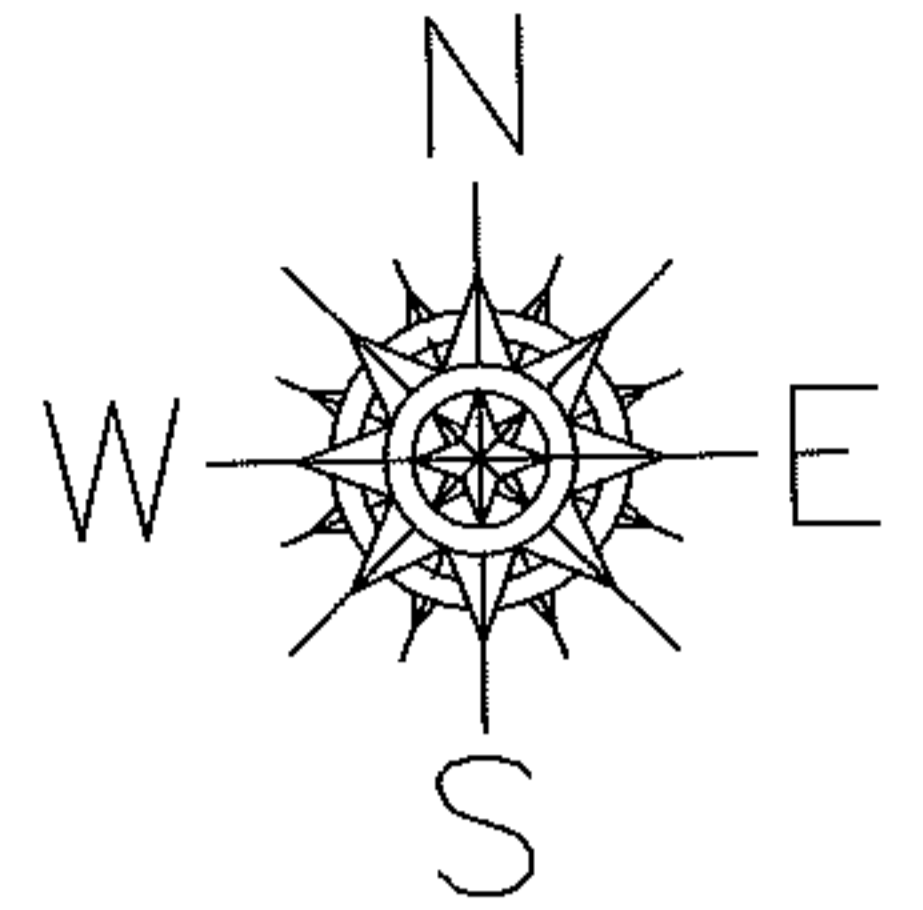


DEPTH CORRECTION

02-01-003-231-020

158

63 X ~~150~~

PER DEED & VAC. ORD. 5462

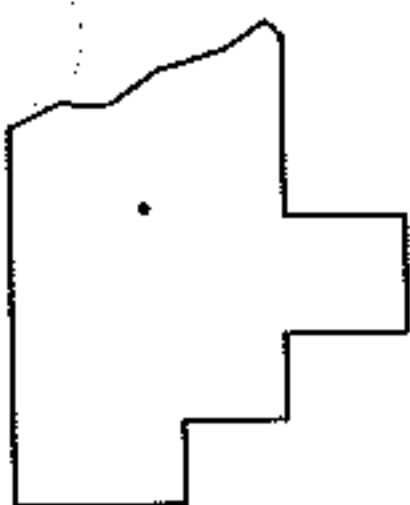

SPLITS/DEEDS PROCESSED

LORAIN COUNTY TAX MAP DEPARTMENT
226 MIDDLE AVE. ELYRIA, OHIO

SURVEYED BY: N/A

CLOSURE: N/A

MAP PAGE(S): 2-01-003-1

APPROVED BY: RRM DATE: 2-24-11

SCALE: 1"= 50' PRIOR INST.: 20070231645