
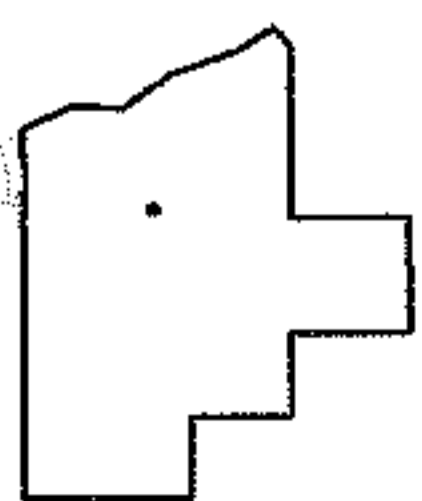
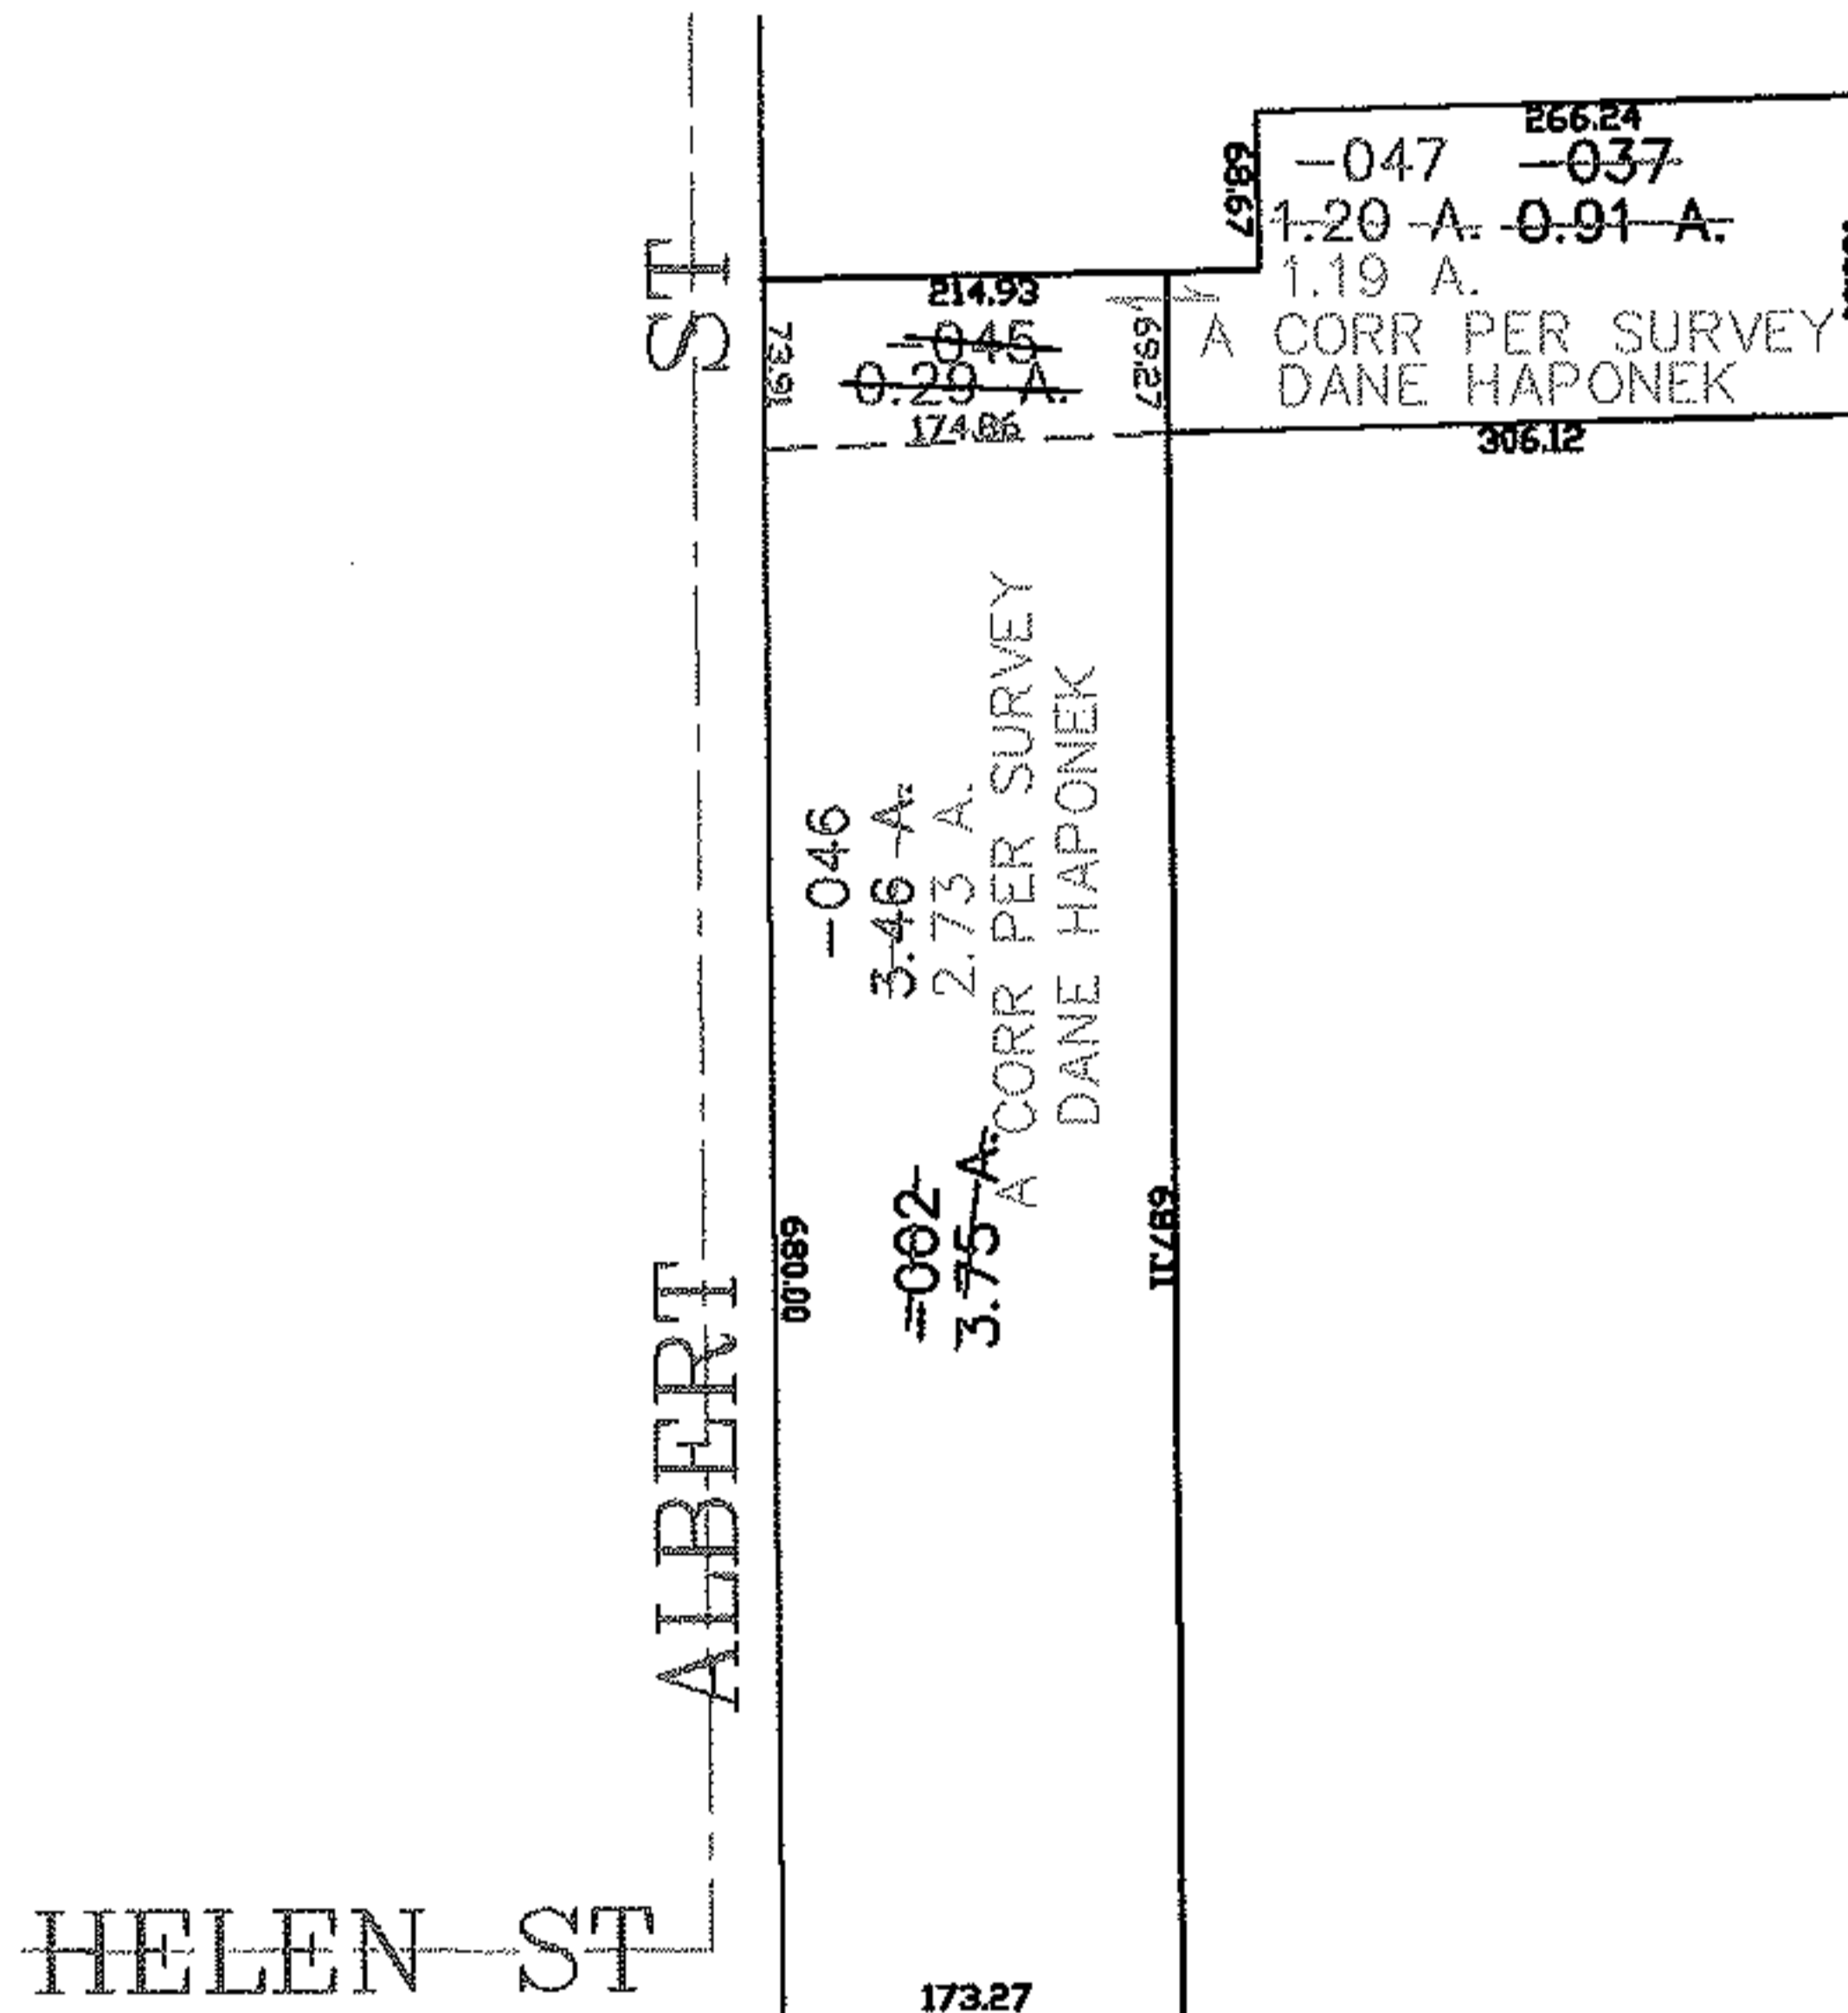


PARENT PARCEL: 07-00-020-138-002

CHILD PARCEL: 07-00-020-138-045 THRU -047

STARTING POINT: SIDELINE OF ALBERT ST & O.L. 20

06-02217

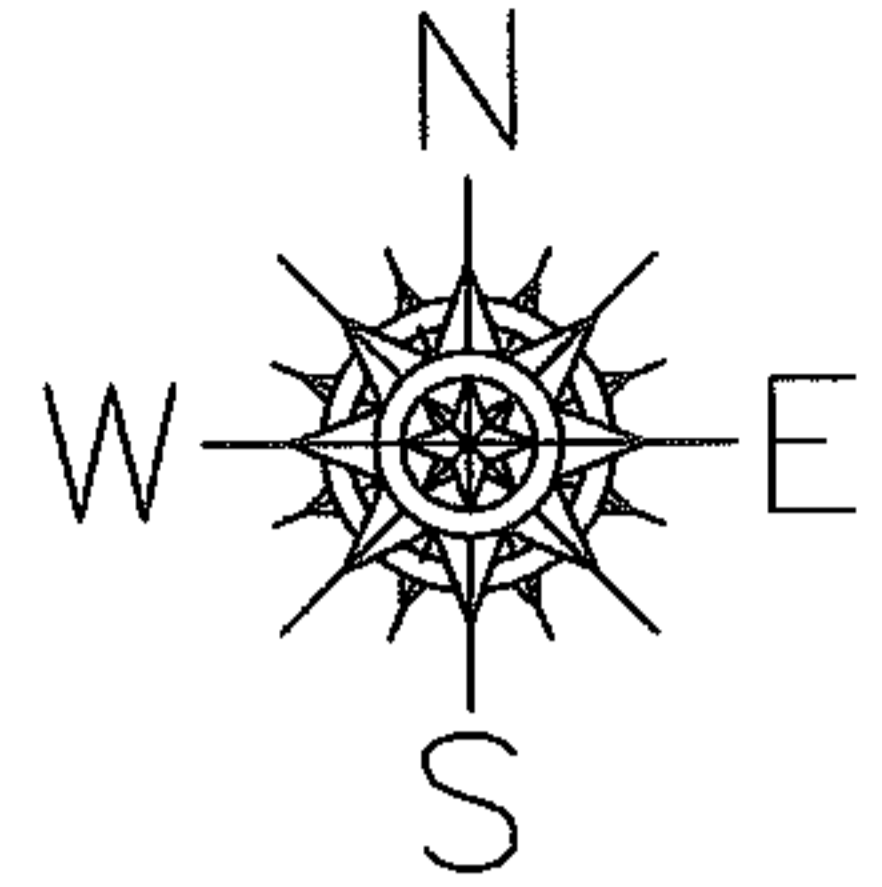

**SPLITS/DEEDS PROCESSED**  
 LORAIN COUNTY TAX MAP DEPARTMENT  
 226 MIDDLE AVE. ELYRIA, OHIO

SURVEYED BY: DANE HAPONEK  
 CLOSURE: 0.00 : 10.000  
 MAP PAGE(S): 07-00-020-D  
 APPROVED BY: JAH DATE: 9-5-06  
 SCALE: 1" = 200 PRIOR INSTRUMENT: DV 1327/523