


PARENT PARCEL: 02-01-006-156-027, -028, -029

CHILD PARCEL: \_\_\_\_\_

STARTING POINT: S/L'S 29, 30, 31 IN FRANK ZINK'S ADD. (VOL.8 PG.31)

11-02218-C

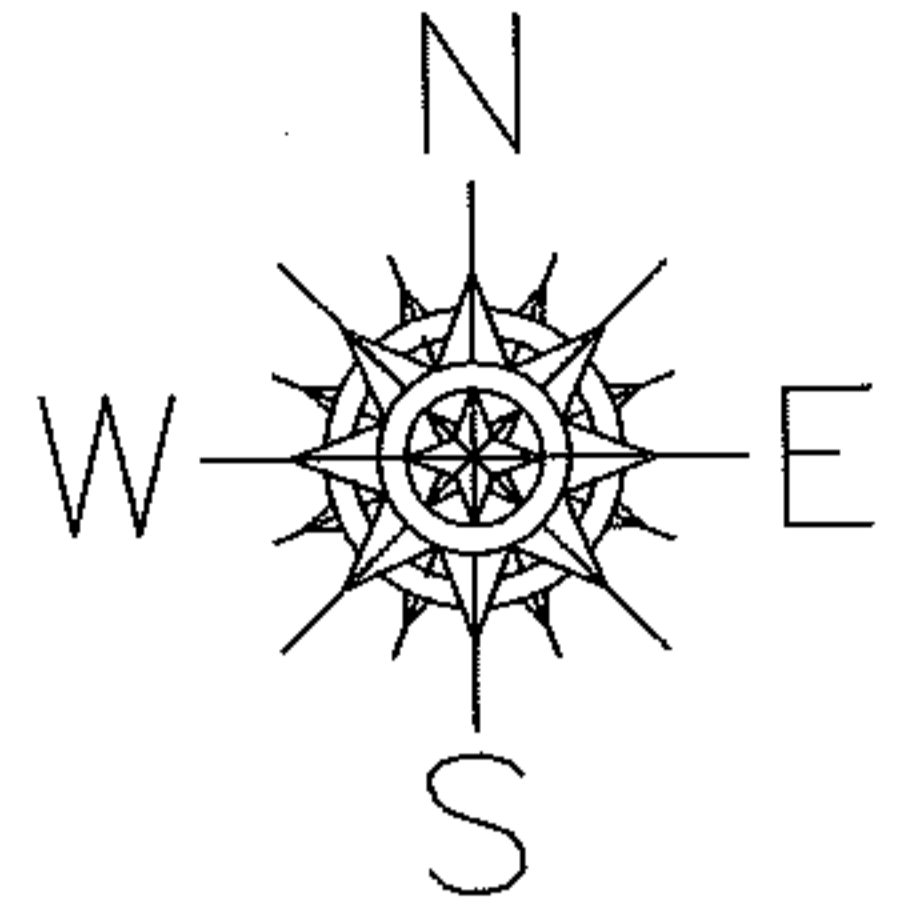

65.03	49.96	49.96	49.96	65.03
	29 -027	30 -028	31 -029	
	49.96	49.96	49.96	

HAMILTON AVE.

VACATED ALLEY ORD. 21-88

DEPTH CORRECTION

02-01-006-156-027

02-01-006-156-028

02-01-006-156-029

65.03

65.03


65.03

49.96 X ~~57~~

49.96 X ~~57~~

49.96 X ~~57~~

PER DEED AND VAC. ORD. 21-88

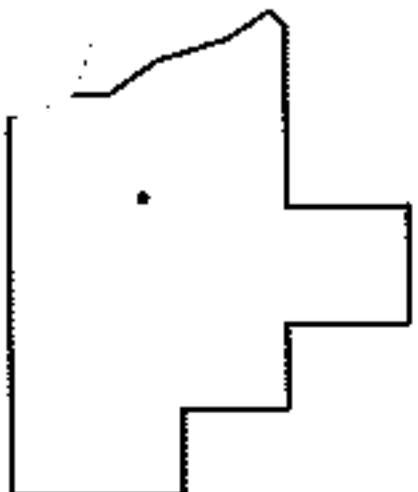

SPLITS/DEEDS PROCESSED

LORAIN COUNTY TAX MAP DEPARTMENT  
226 MIDDLE AVE. ELYRIA, OHIO

SURVEYED BY: N/A

CLOSURE: N/A

MAP PAGE(S): 2-01-006-E

APPROVED BY: RRM DATE: 3-7-11

SCALE: 1"= 50' PRIOR INST.: 20060177485