
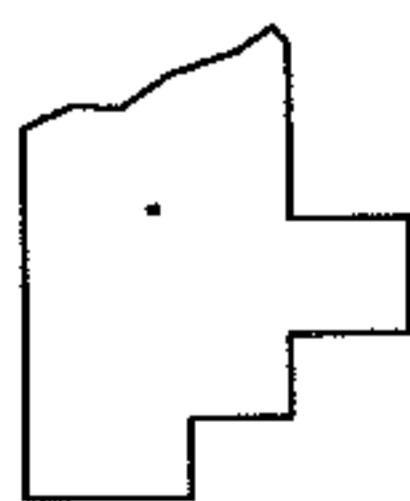
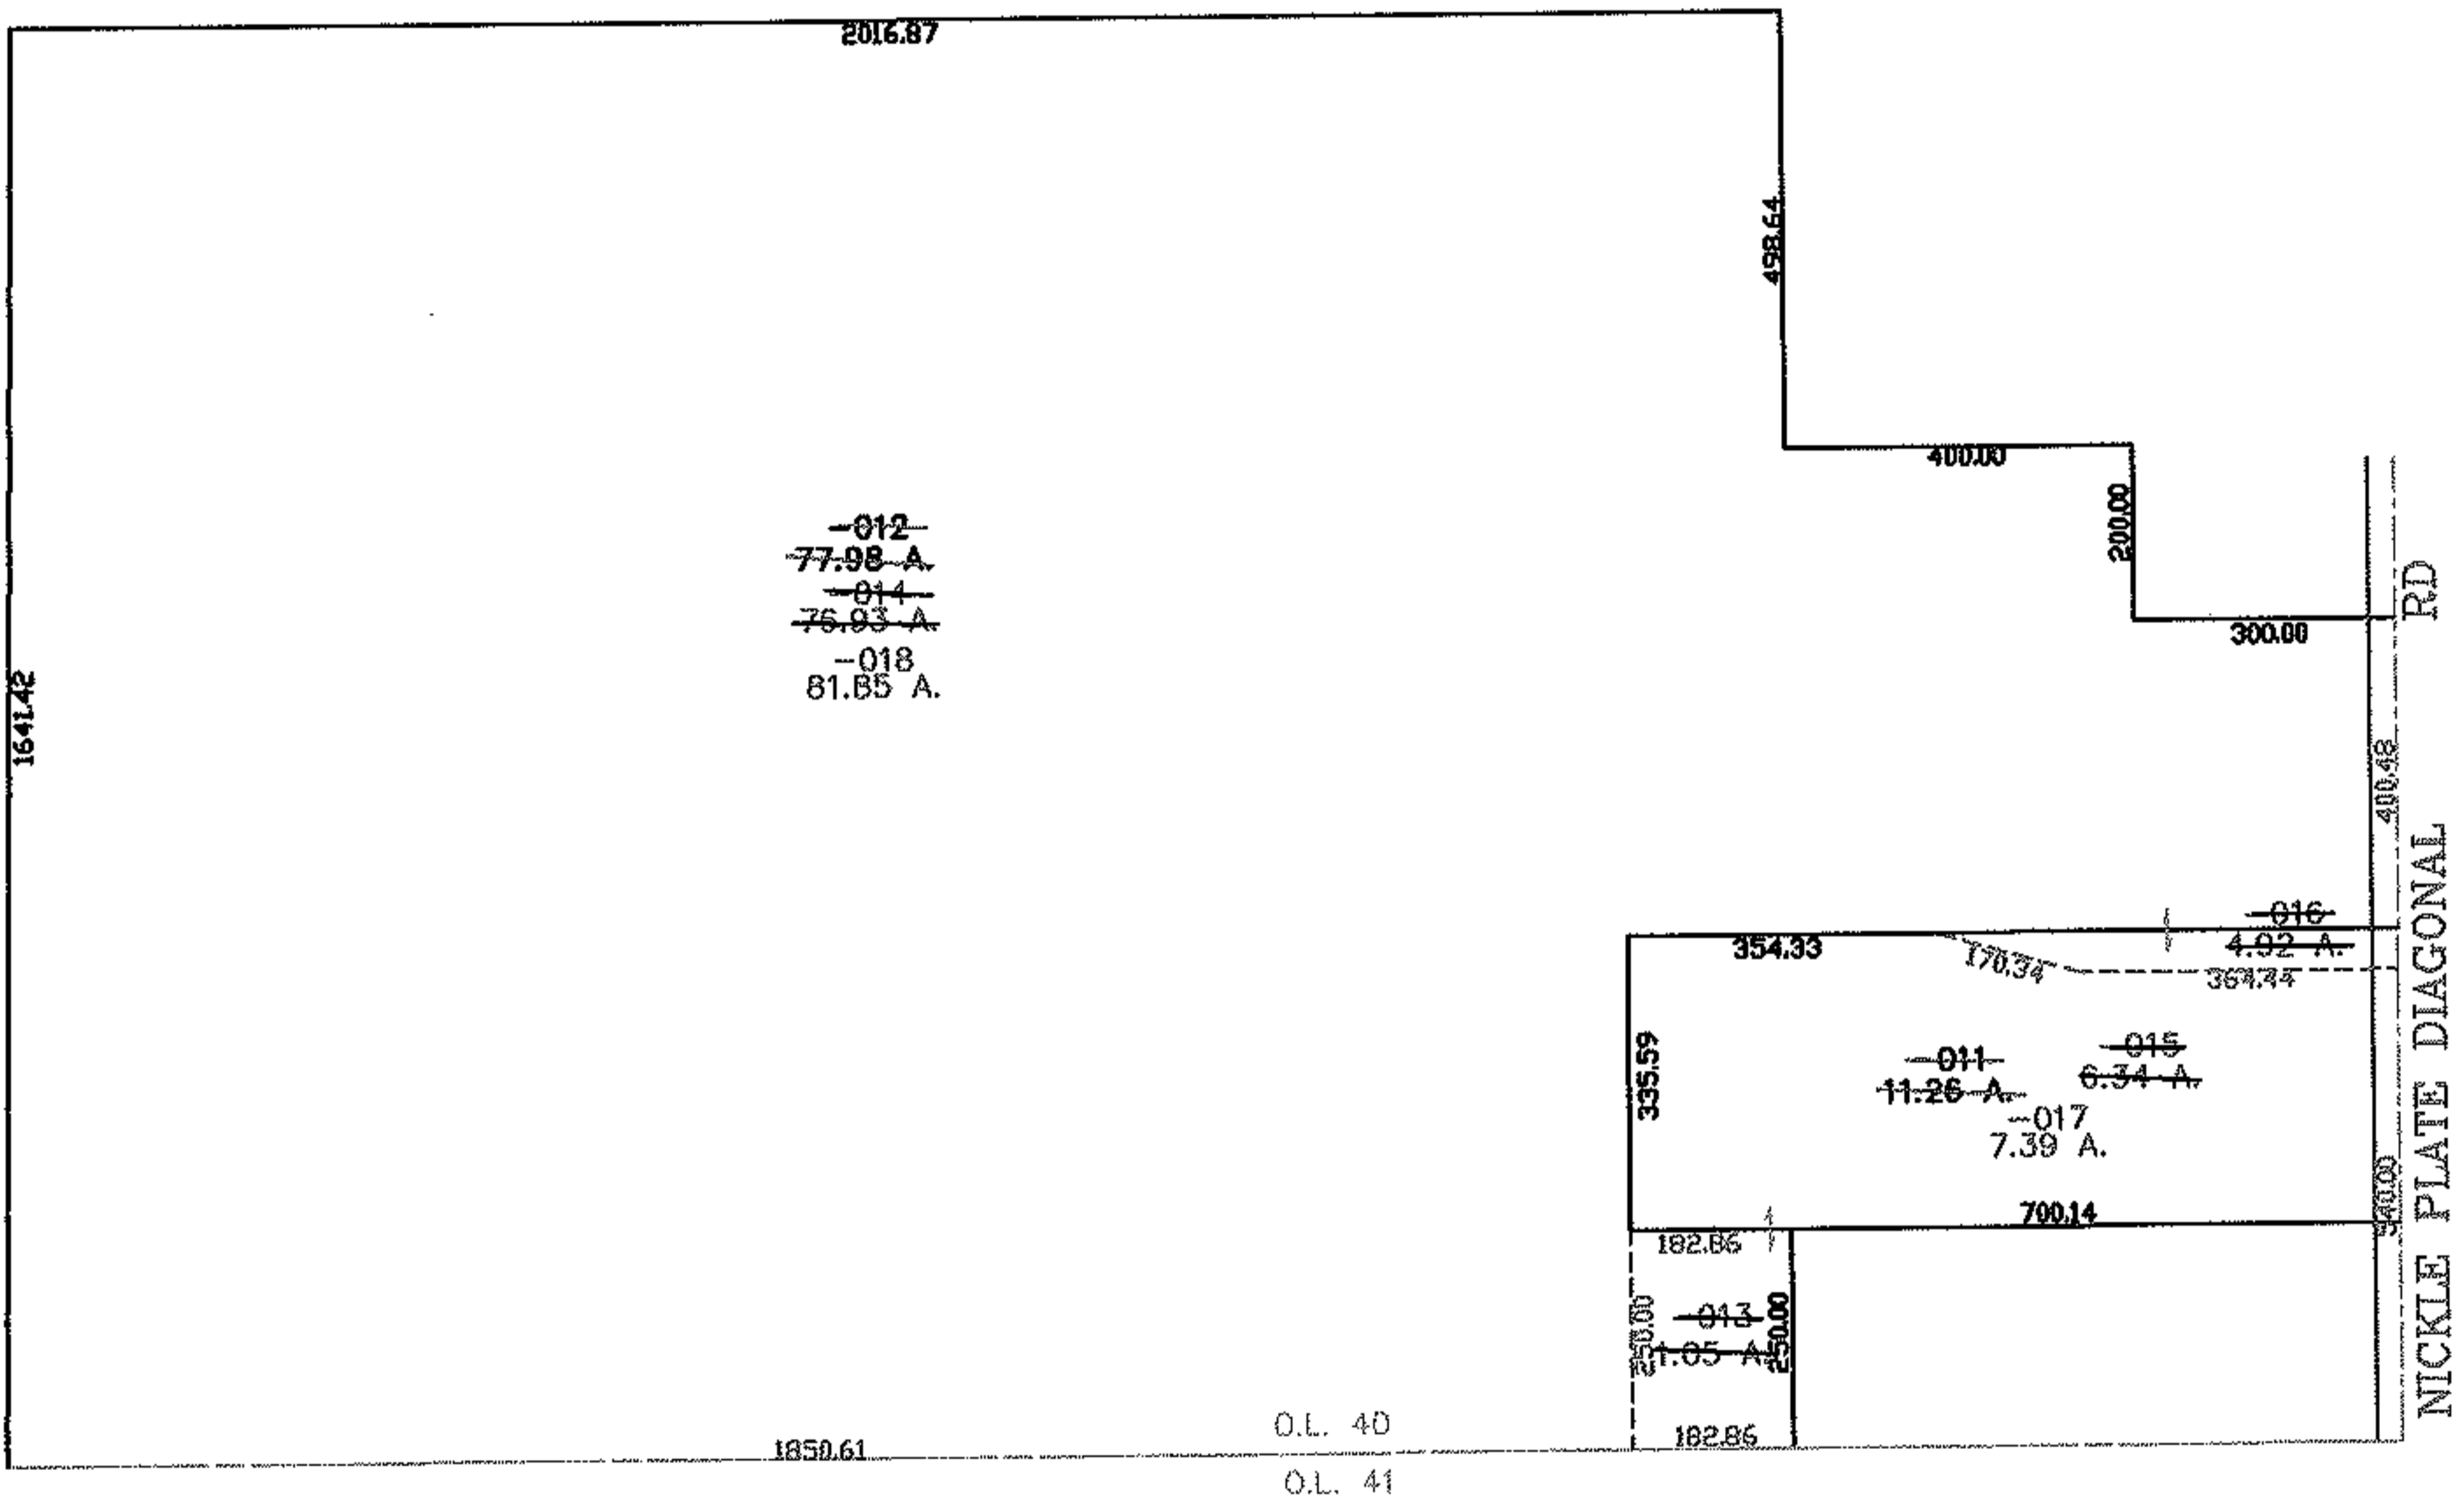


PARENT PARCEL: 15-00-040-000-011, -012

CHILD PARCEL: 15-00-040-000-013 THRU -018

STARTING POINT: CENTERLINE OF NICKLE PLATE DIAGONAL RD & O.L. 40

06-02220

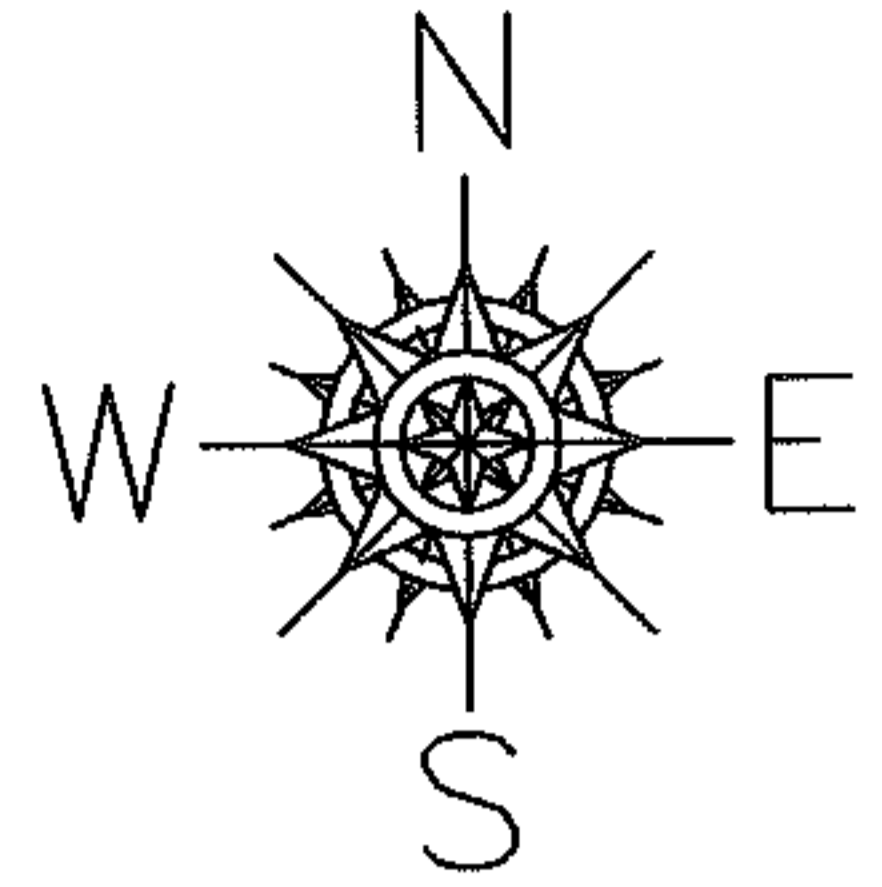

**SPLITS/DEEDS PROCESSED**  
**LORAIN COUNTY TAX MAP DEPARTMENT**  
**226 MIDDLE AVE. ELYRIA, OHIO**

SURVEYED BY: DANE HAPONEK  
 CLOSURE: 0.00 : 10.000  
 MAP PAGE(S): 15-00-040-B  
 APPROVED BY: JAH DATE: 9-12-06  
 SCALE: 1" = 400 PRIOR INSTRUMENT: 20060141202