
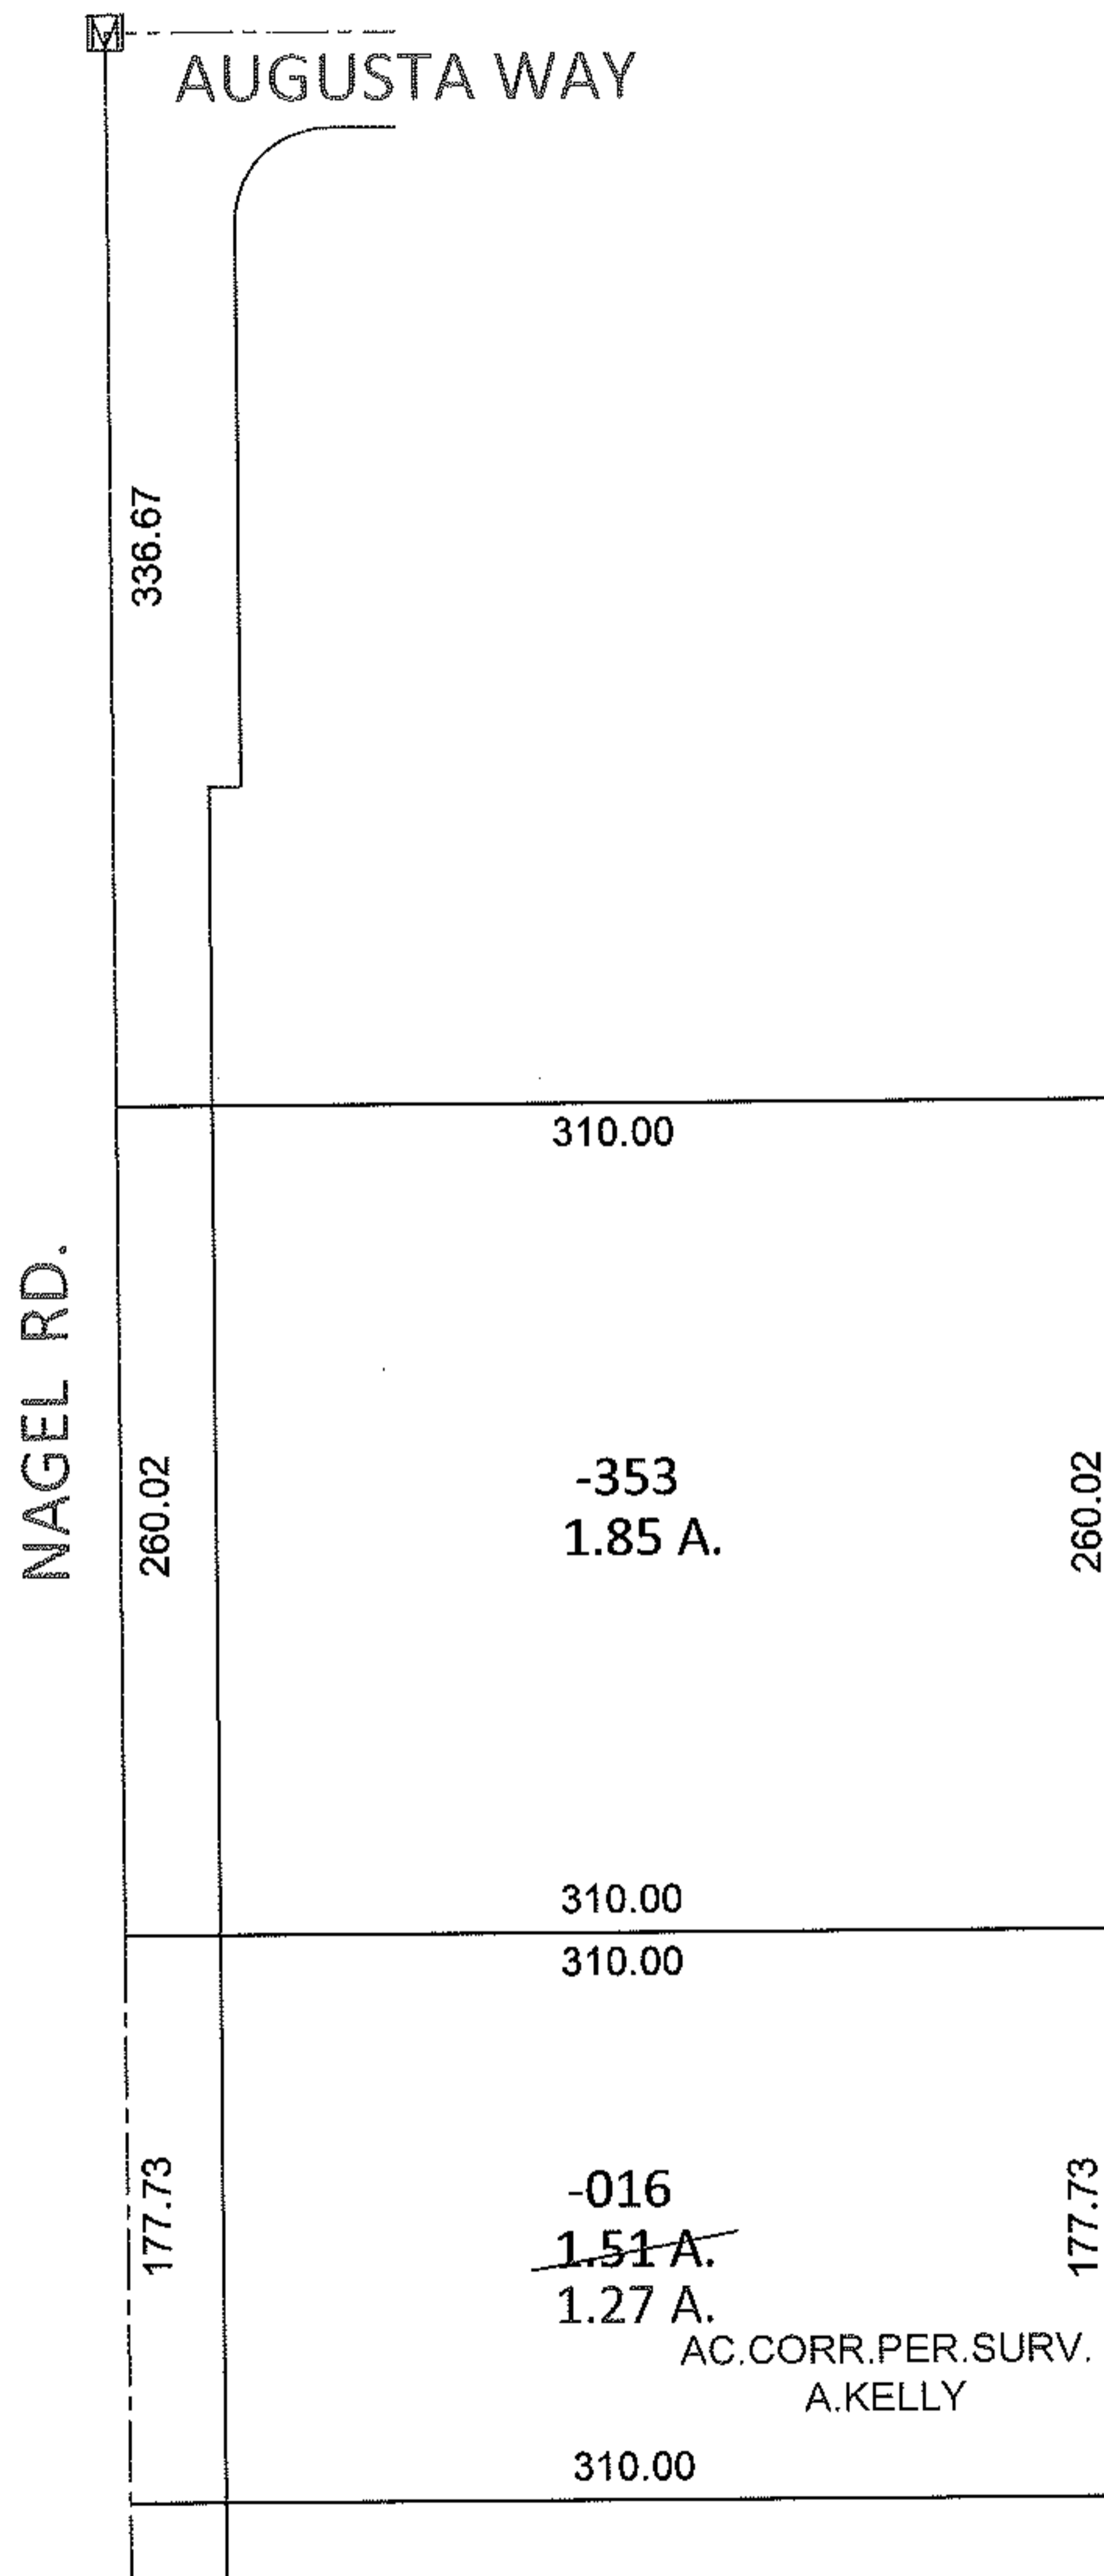


PARENT PARCEL: 04-00-025-000-016, -353


11-02222-D

CHILD PARCEL:

STARTING POINT: INTERSECTION OF C/L OF NAGEL RD. AND C/L OF AUGUSTA WAY

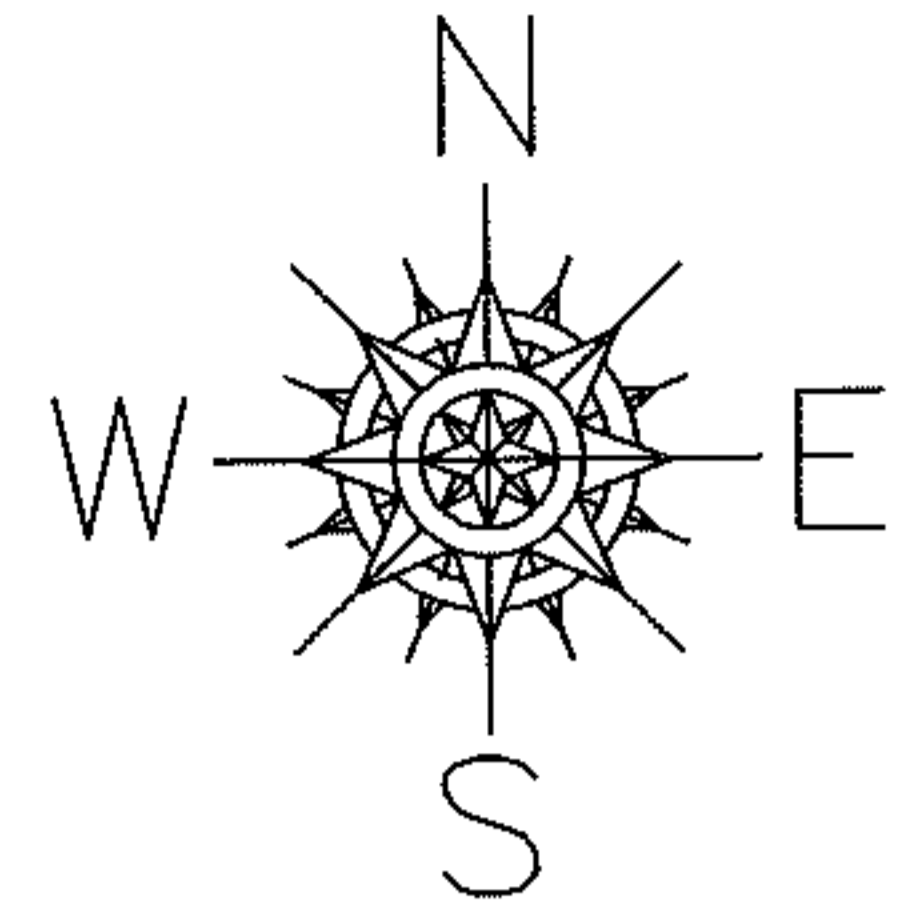

*2005091157
*20090287745

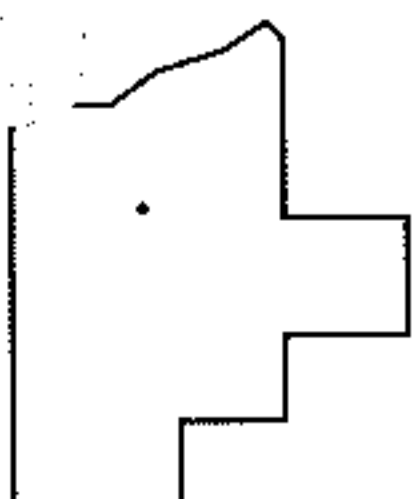

SPLITS/DEEDS PROCESSED

LORAIN COUNTY TAX MAP DEPARTMENT
226 MIDDLE AVE. ELYRIA, OHIO

SURVEYED BY: AMY M. KELLY
CLOSURE: .00:10,000
MAP PAGE(S): 4-00-025-A
APPROVED BY: RRM DATE: 2-3-11
SCALE: 1"= 100 PRIOR INST.: *SEE ABOVE