



RASTER

PARENT PARCEL: 04-00-010-111-173

CHILD PARCEL: 04-00-010-111-210 THRU -213

STARTING POINT: CENTERLINE OF HARVEST DR & CANDLEWOOD DR

06-02224

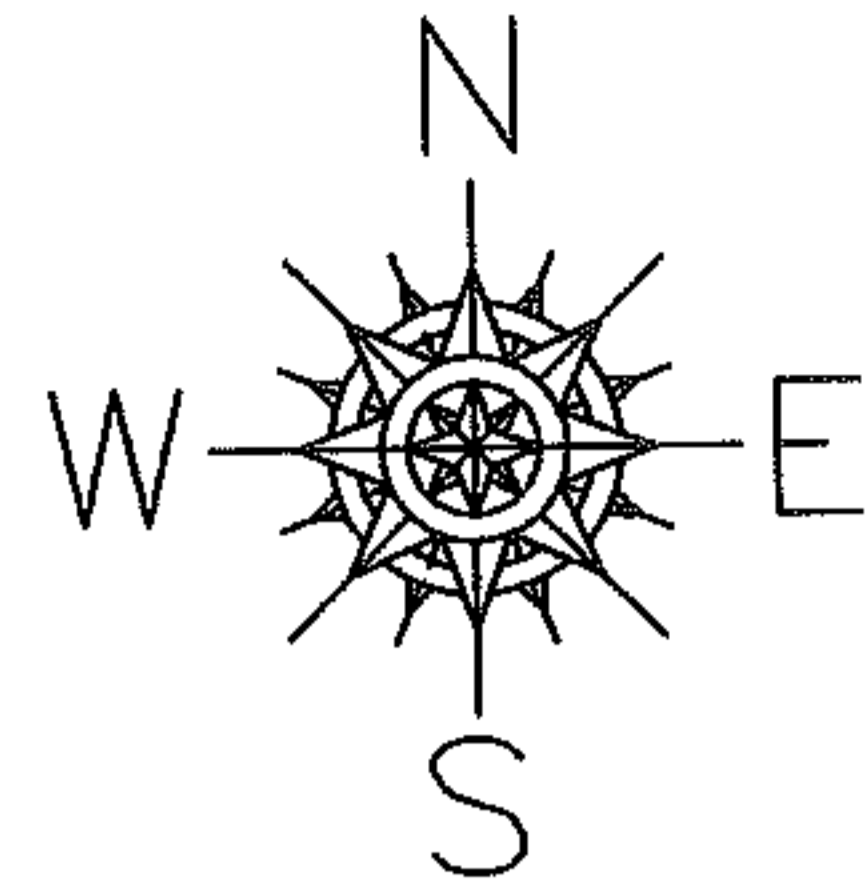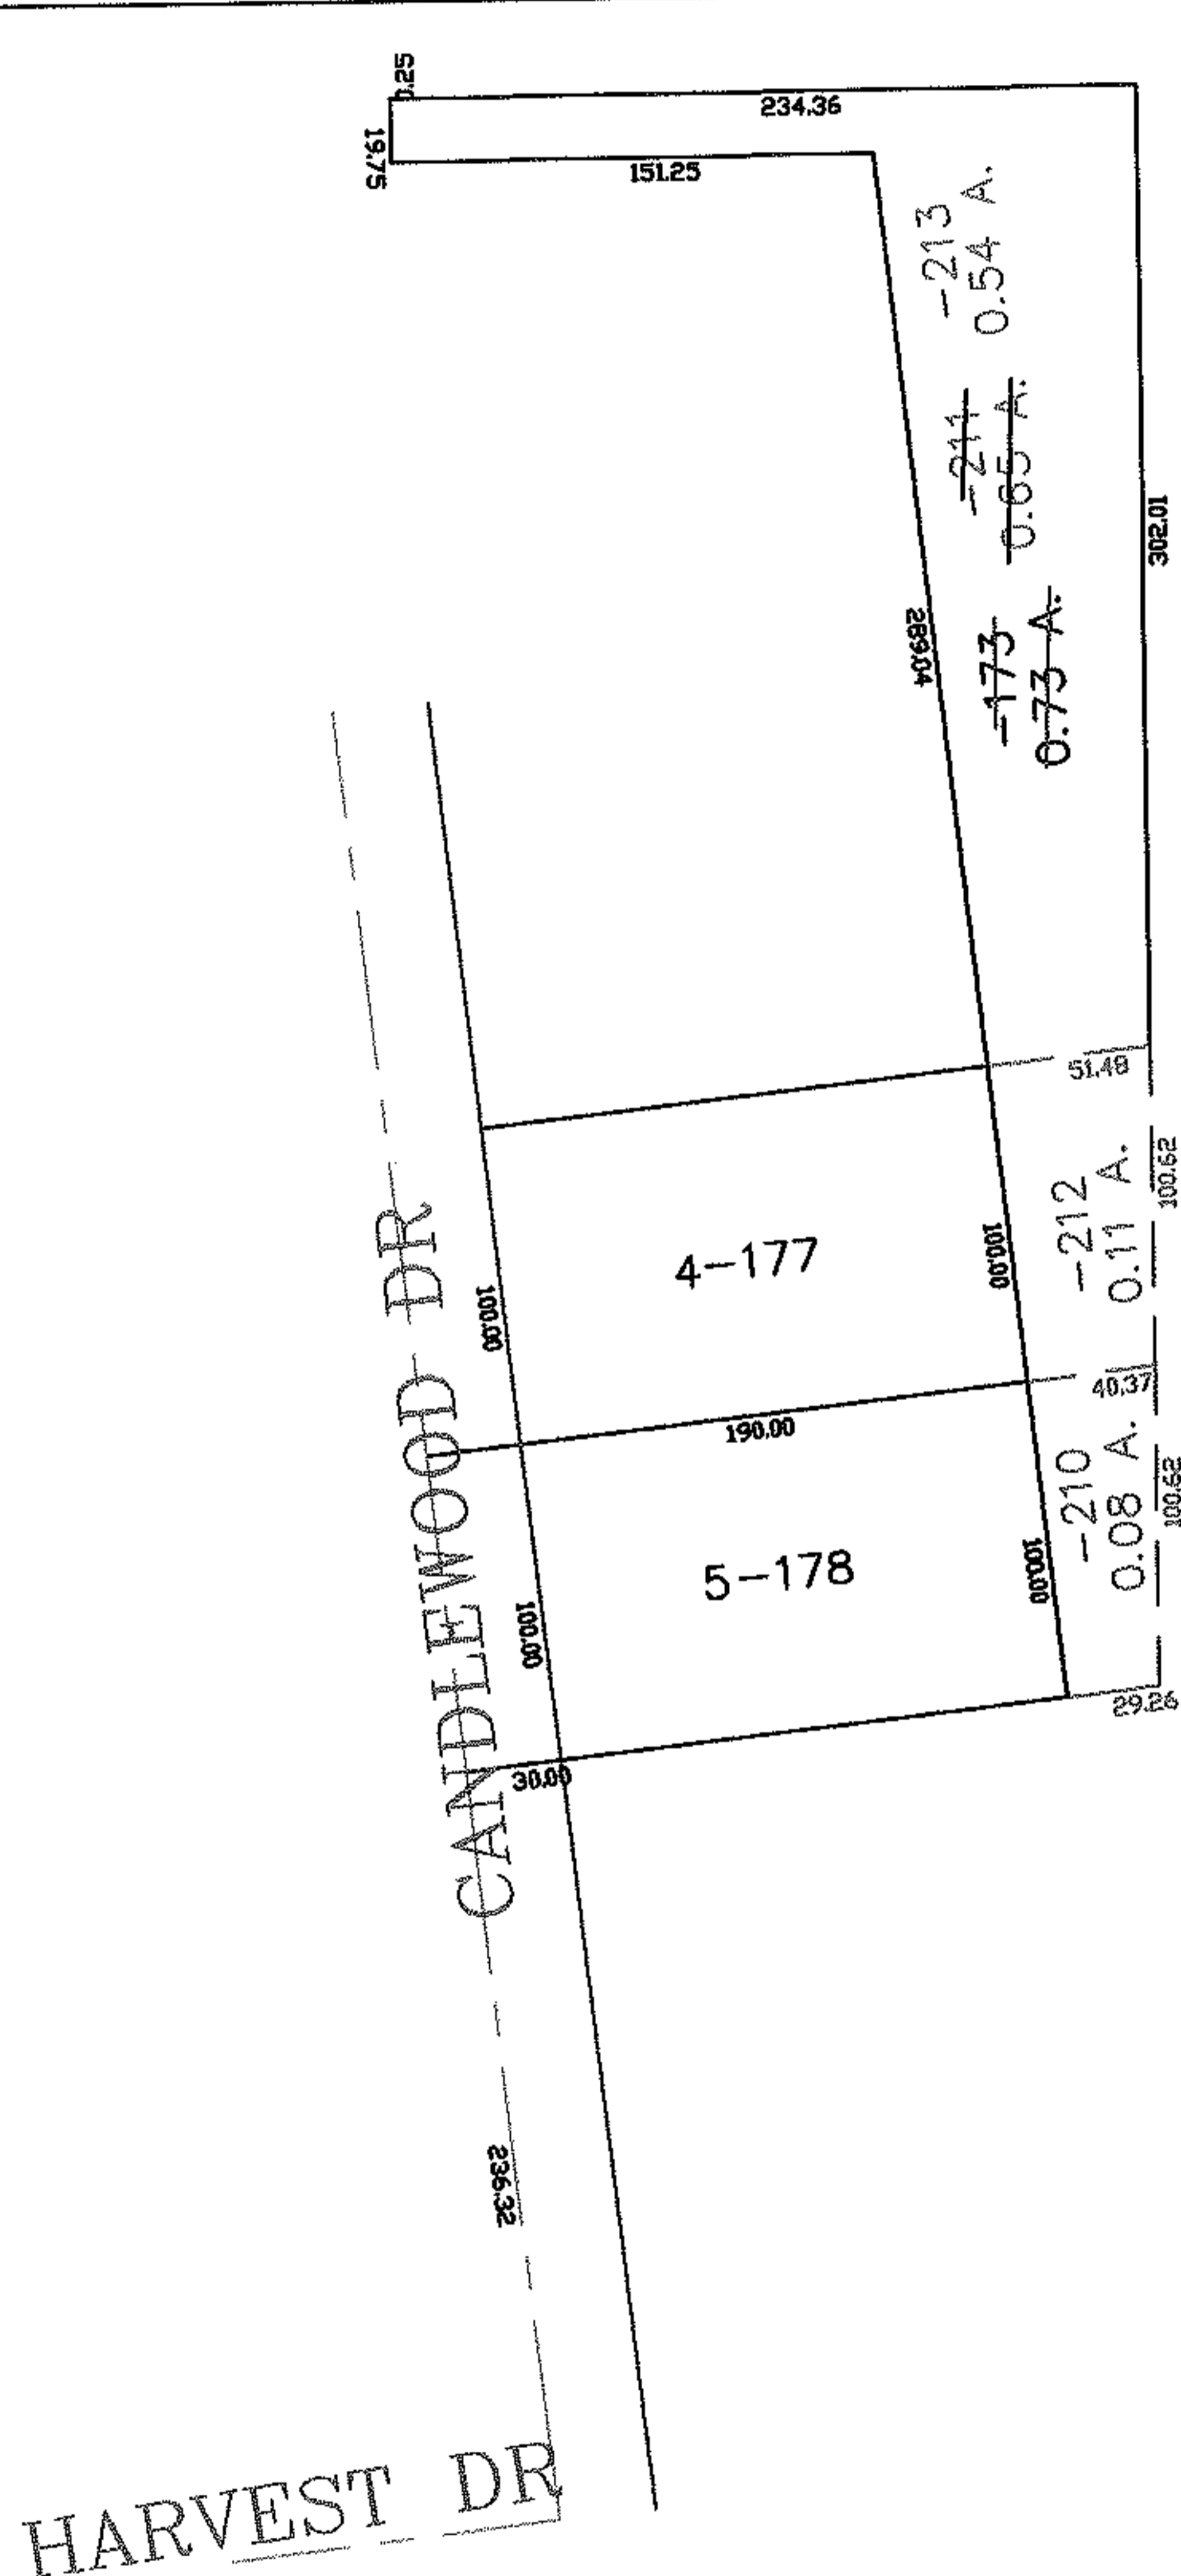

SPLITS/DEEDS PROCESSED

LORAIN COUNTY TAX MAP DEPARTMENT
226 MIDDLE AVE. ELYRIA, OHIO

SURVEYED BY: THOMAS SIMON

CLOSURE: 0.00 : 10.000

MAP PAGE(S): 04-00-010-G

APPROVED BY: JAH DATE: 9-19-06

SCALE: 1"= 100 PRIOR INSTRUMENT: 19970483296