
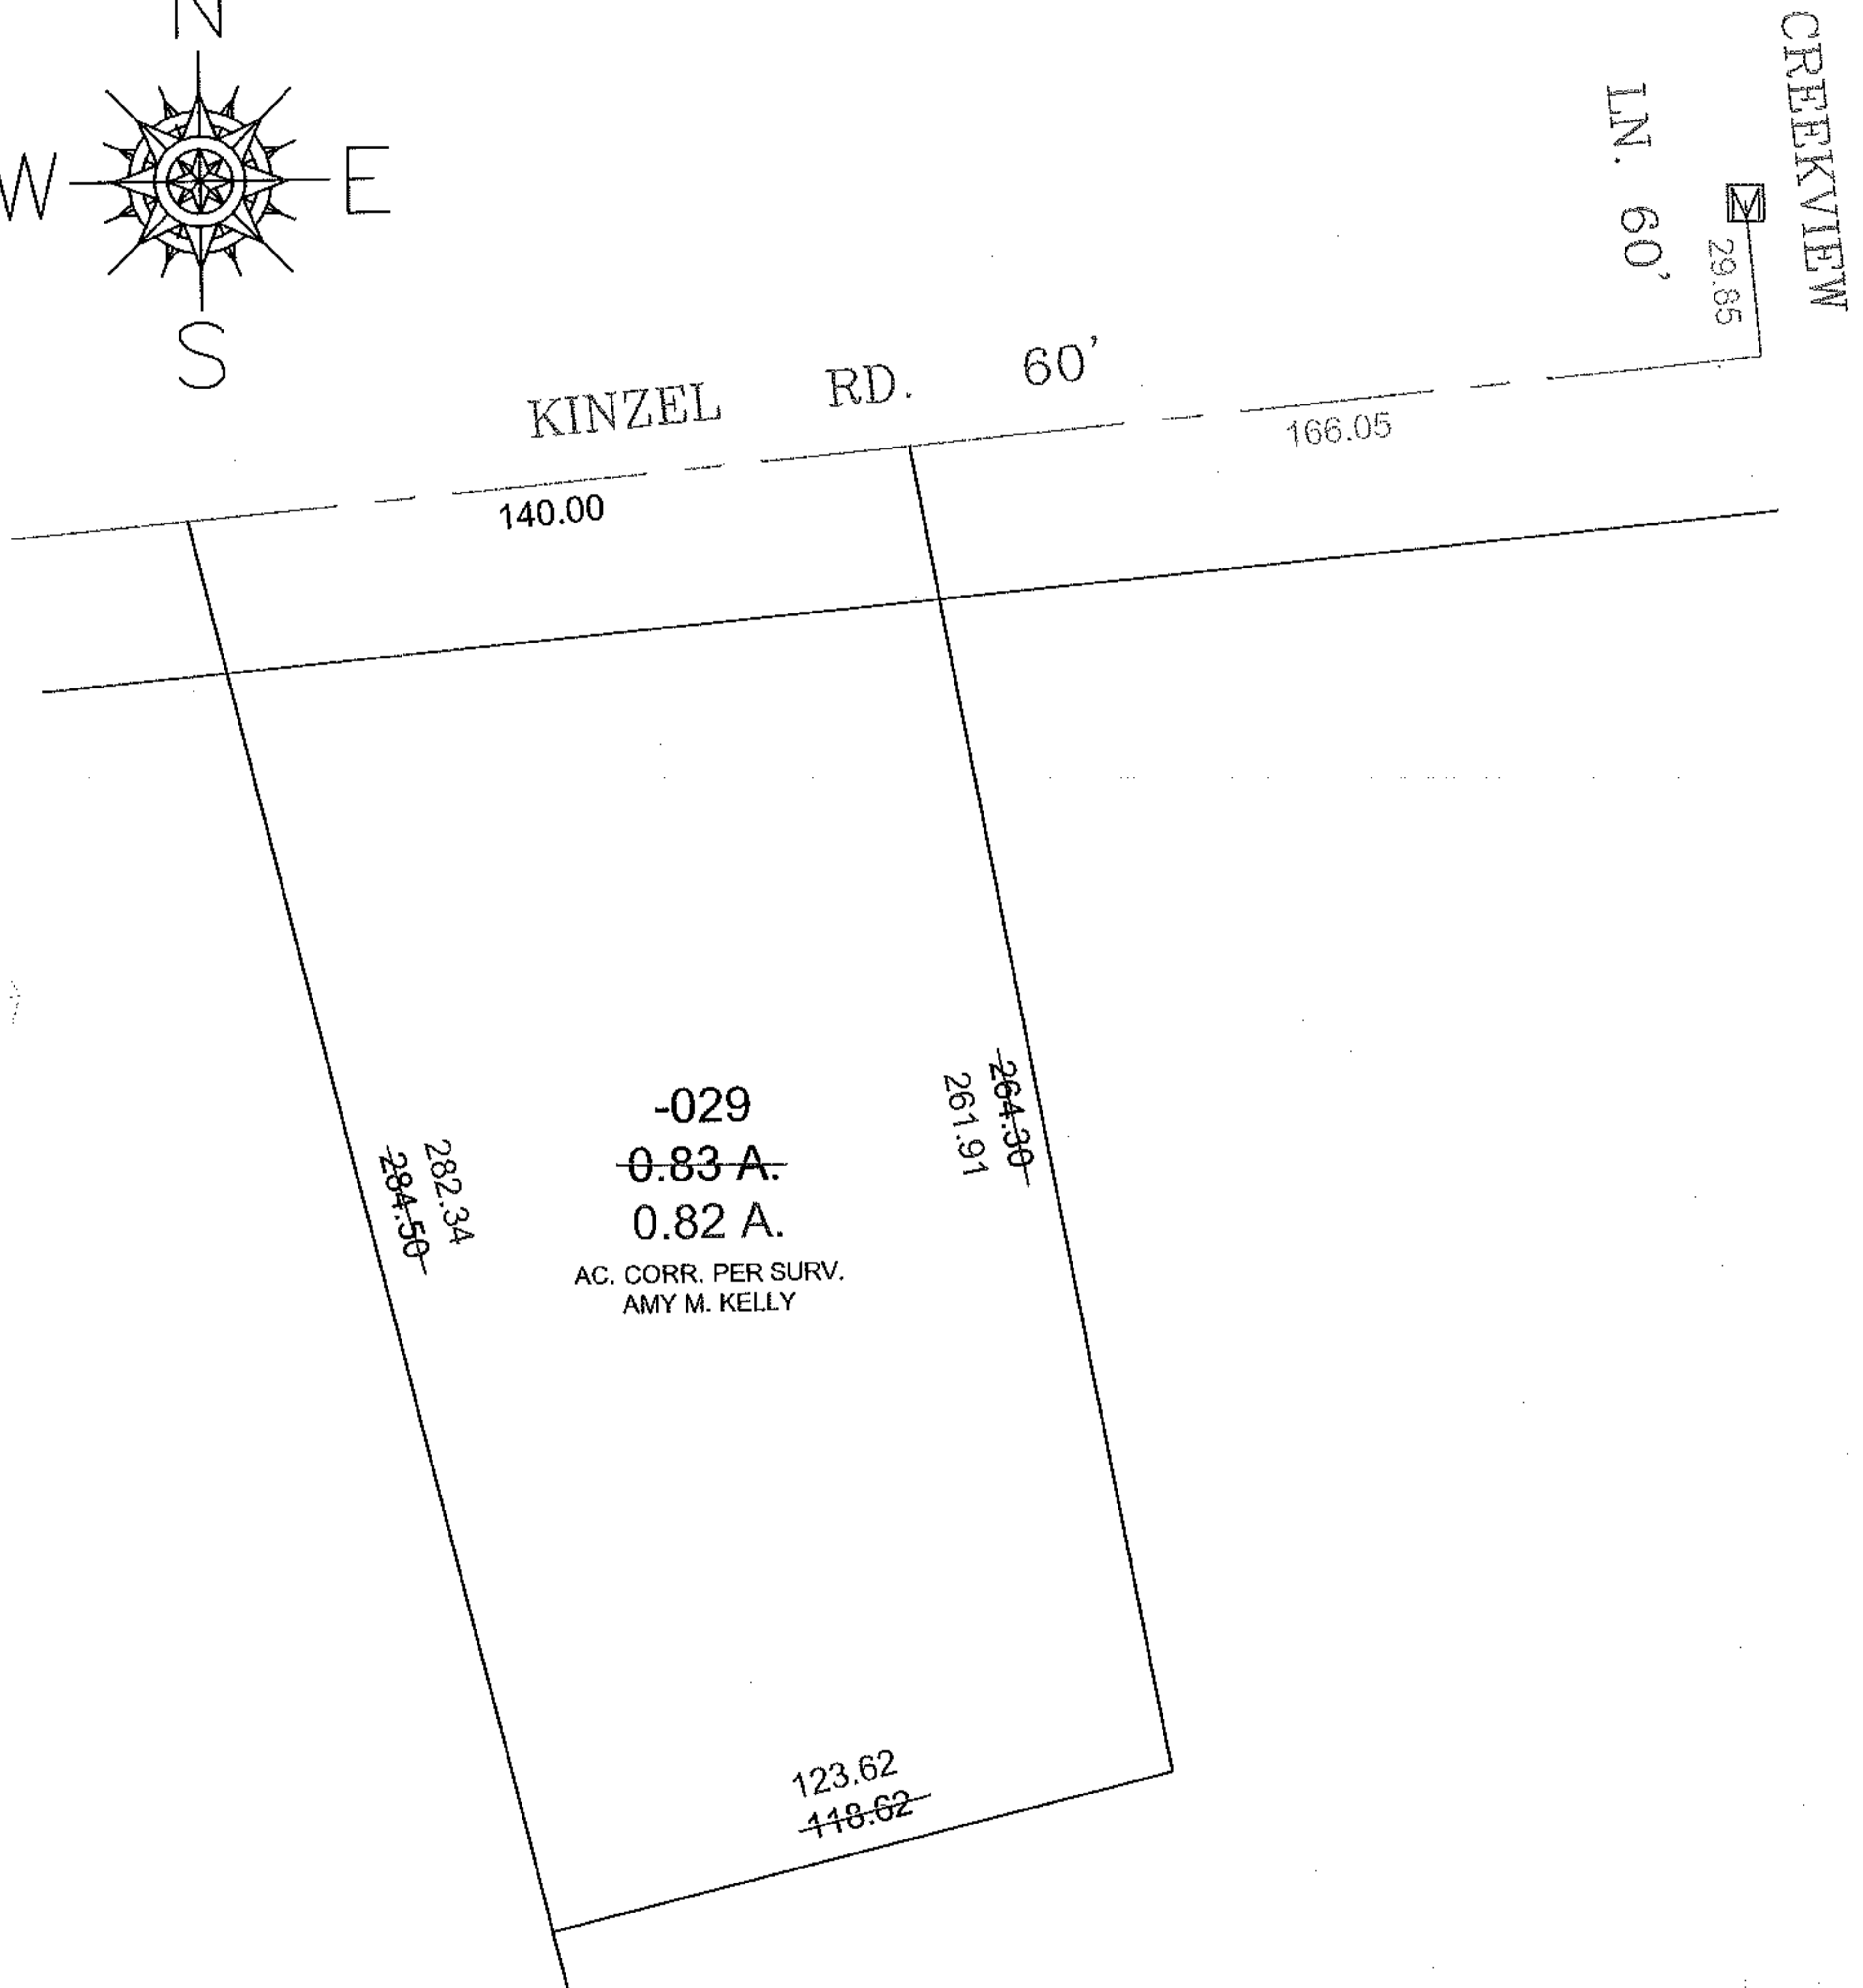


PARENT PARCEL: 04-00-014-105-029

CHILD PARCEL: XX-XX-XXX-XXX-XXX

STARTING POINT: MON. BOX, CL OF CREEKVIEW LN.

11-02225-A

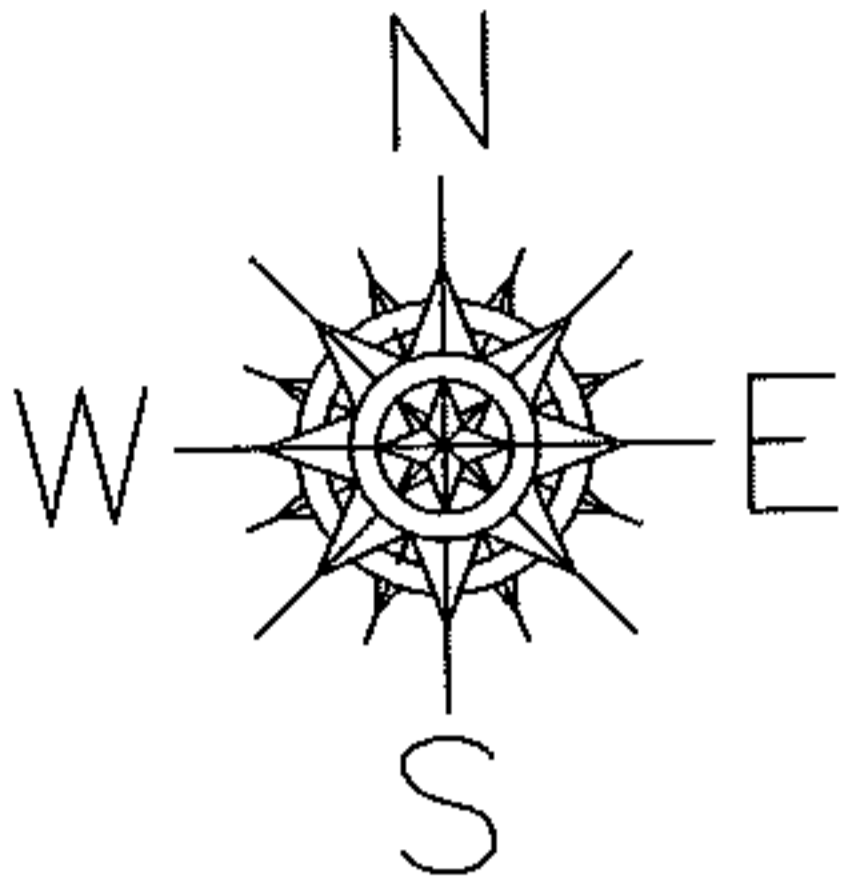

SPLITS/DEEDS PROCESSED

LORAIN COUNTY TAX MAP DEPARTMENT
226 MIDDLE AVE. ELYRIA, OHIO

SURVEYED BY: AMY M. KELLY

CLOSURE: 0.01 : 10,000

MAP PAGE(S): 4-00-014-E

APPROVED BY: TJS DATE: 3/10/11

SCALE: 1" = 50' PRIOR INST.: 20030889981