

PARENT PARCEL: 05-00-042-106-013

CHILD PARCEL: 05-00-042-106-014 & -015

STARTING POINT: CL OF DEWEY RD. & OLD CL OF NORTH RIDGE

11-02230-C

ADD TO DUPLICATE

DROP FROM DUPLICATE

05-00-042-106-014

0.04 A.

&

05-00-042-106-015

0.39 A.


CORR. PER DEEDS

DV 530/357

OR 235/203

~~05-00-042-106-013~~

~~0.43 A.~~

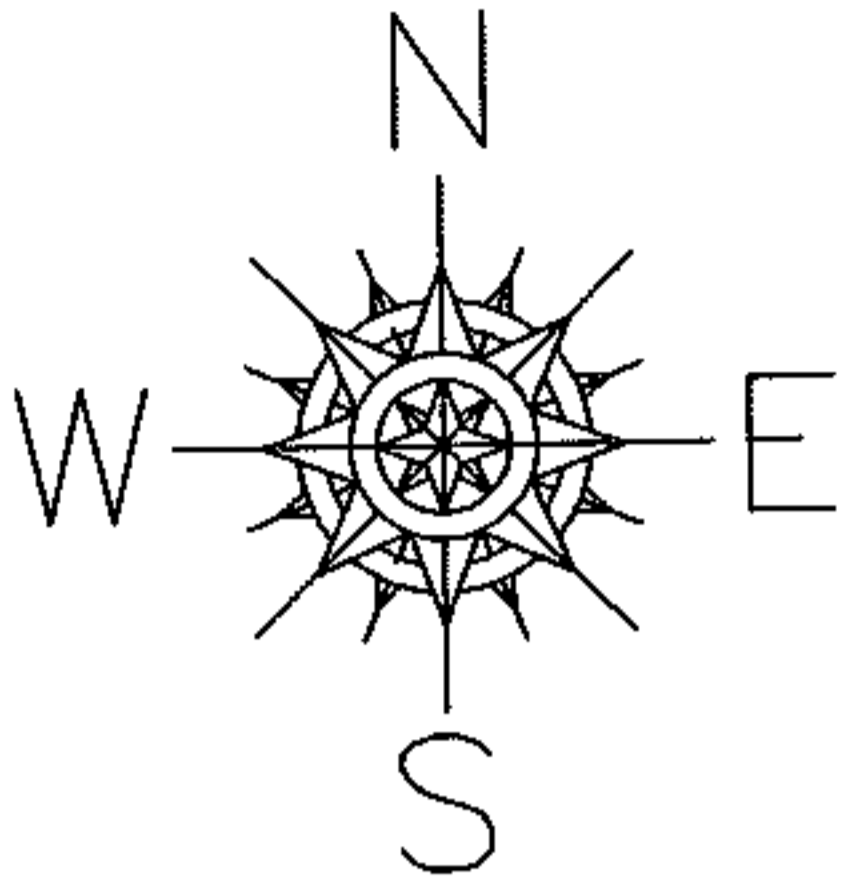

SURVEY BEFORE NEXT TRANSFER


05-00-042-106-015

0.39 A.

2 DESCRIPTIONS, 1 PARCEL NUMBER
VAGUE LEGAL & BAD CLOSURE
MISSING EXCEPTION

NORTH RIDGE RD. 66'
OLD CENTERLINE
NEW CENTERLINE

66' R.O.W. ESTABLISHED
OFF OLD CENTERLINE

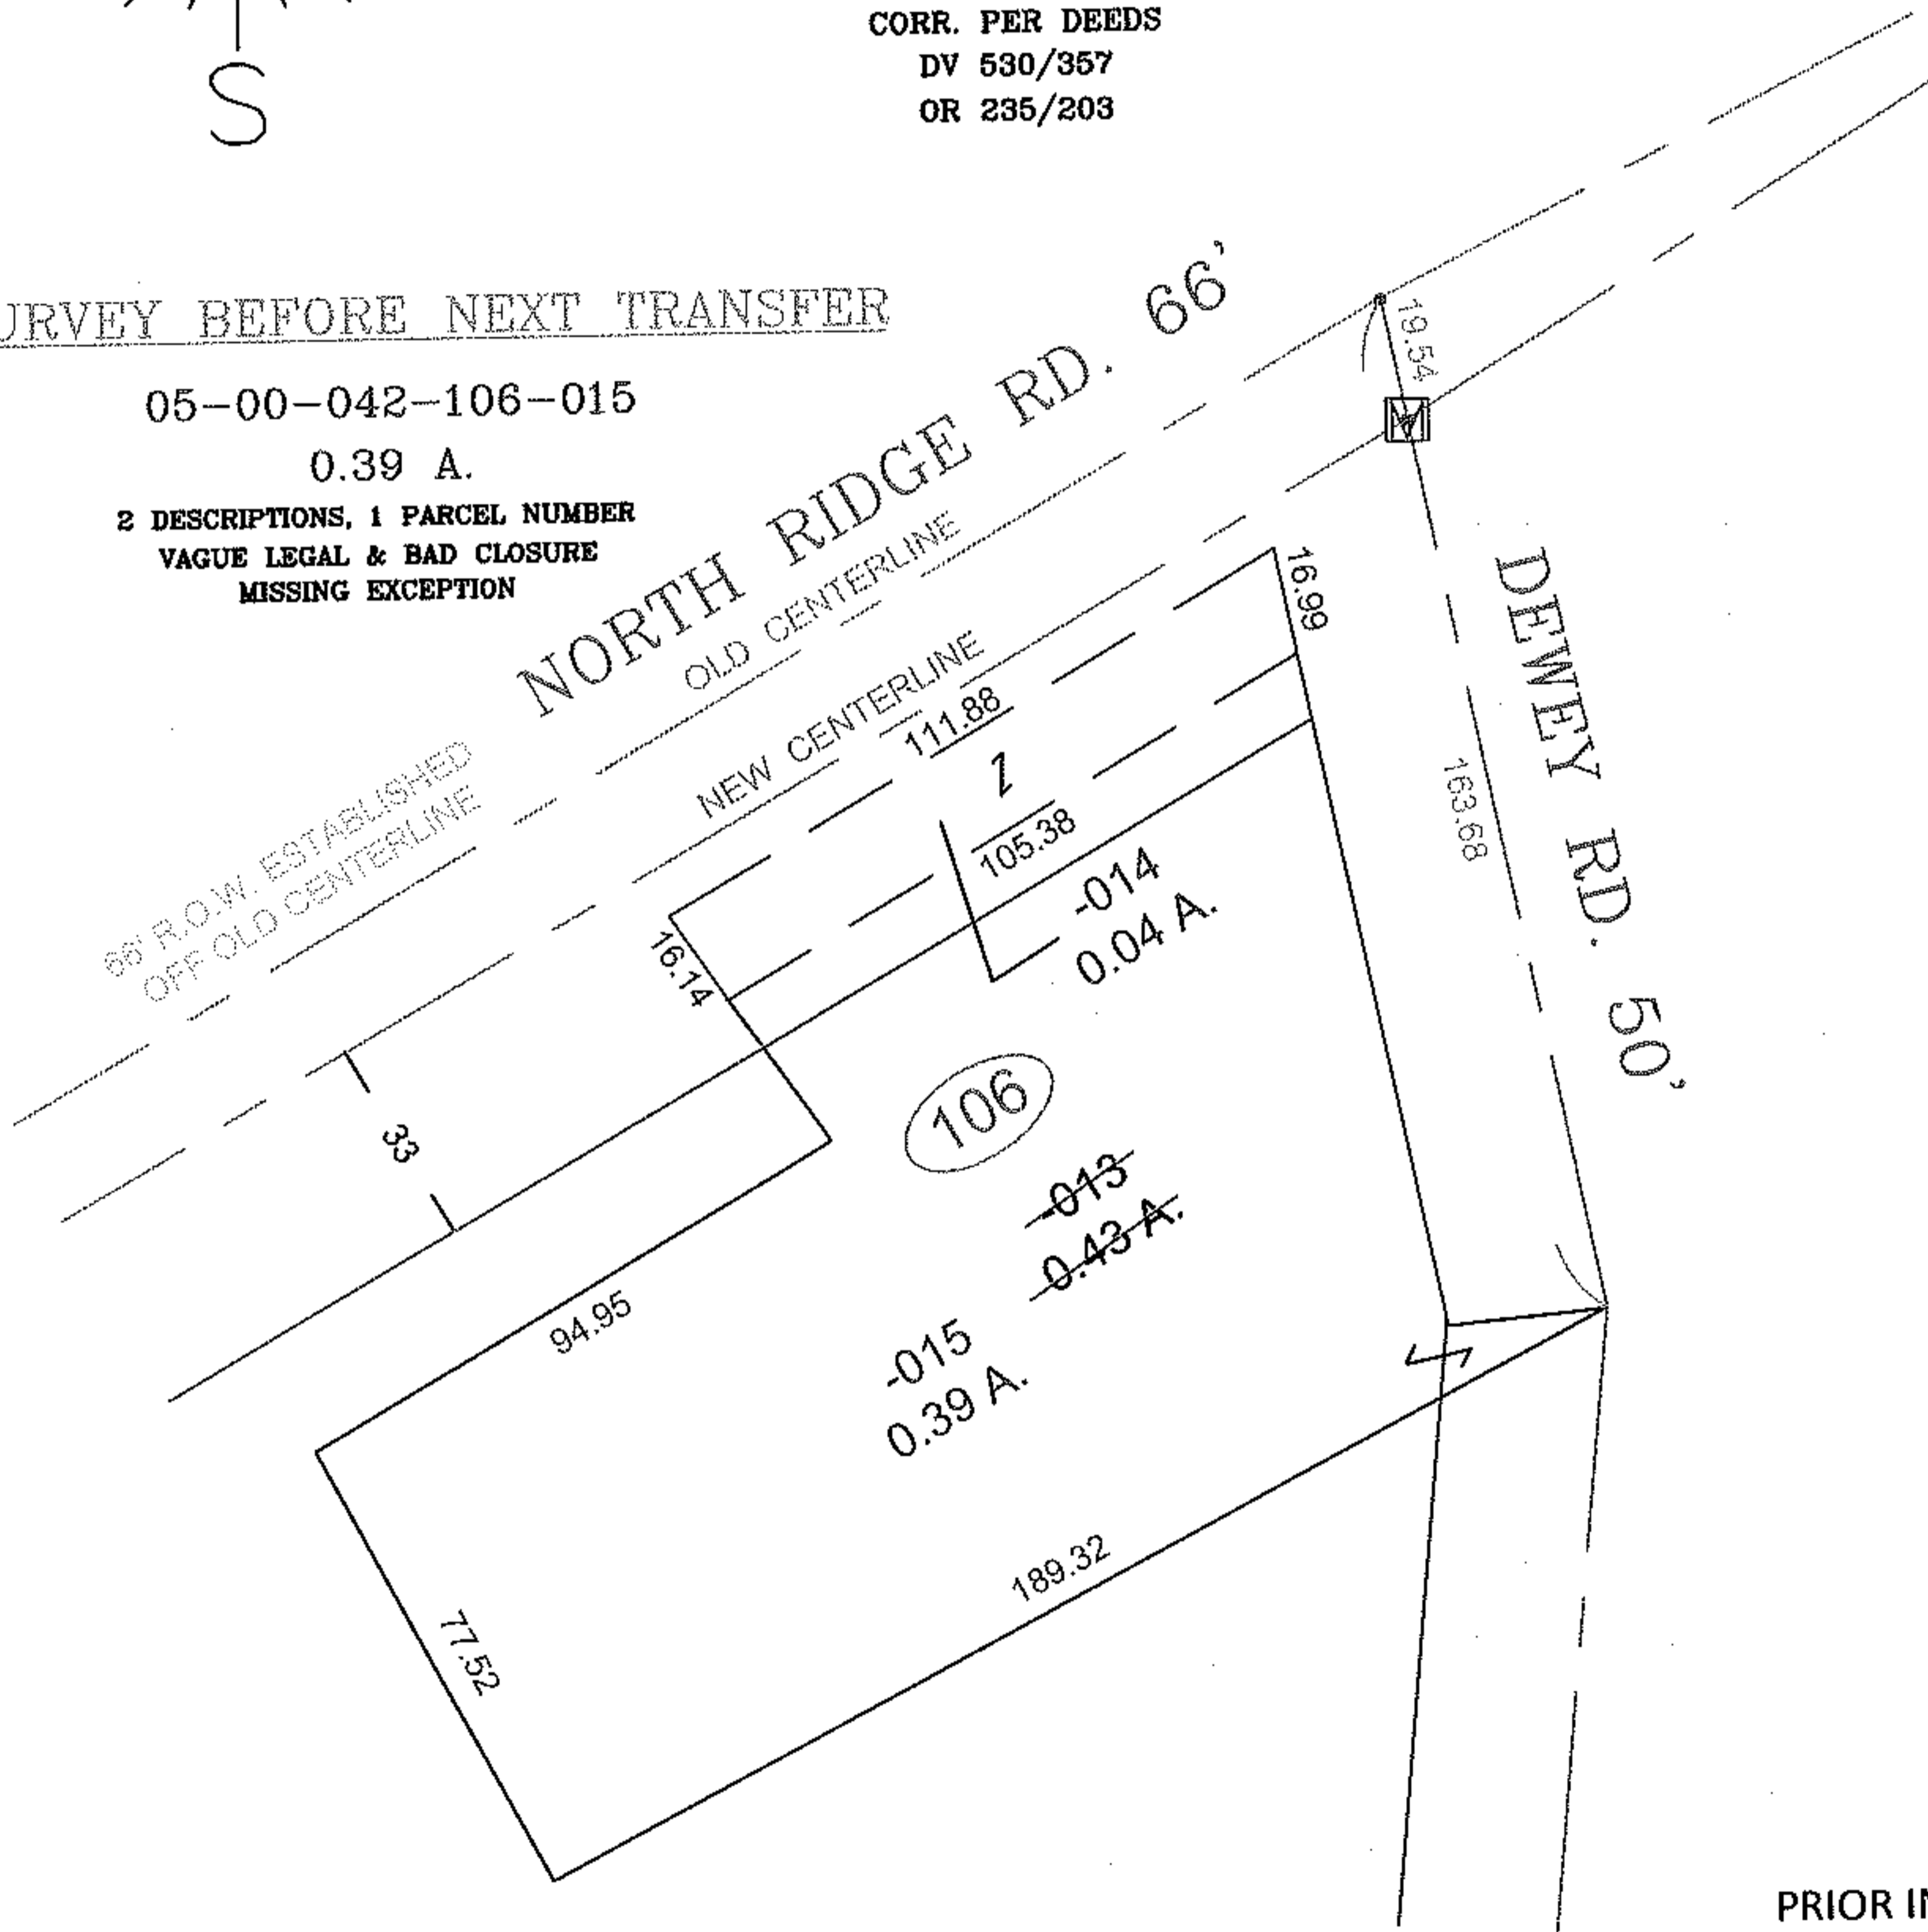

PRIOR INST.: DV 250/336

PRIOR INST.: DV 957/490

SPLITS/DEEDS PROCESSED

LORAIN COUNTY TAX MAP DEPARTMENT
226 MIDDLE AVE. ELYRIA, OHIO

SURVEYED BY: NONE

CLOSURE: 1: 1500 BAD CLOSURE

MAP PAGE(S): 5-00-042-B

APPROVED BY: TJS DATE: 2/10/11

SCALE: 1"= 50' PRIOR INST.: DV 549/545