


PARENT PARCEL: 04-00-025-000-272

CHILD PARCEL: 04-00-025-000-484, -485

STARTING POINT: CENTERLINE OF LEAR NAGLE RD & ST FRANCIS DR

06-02230

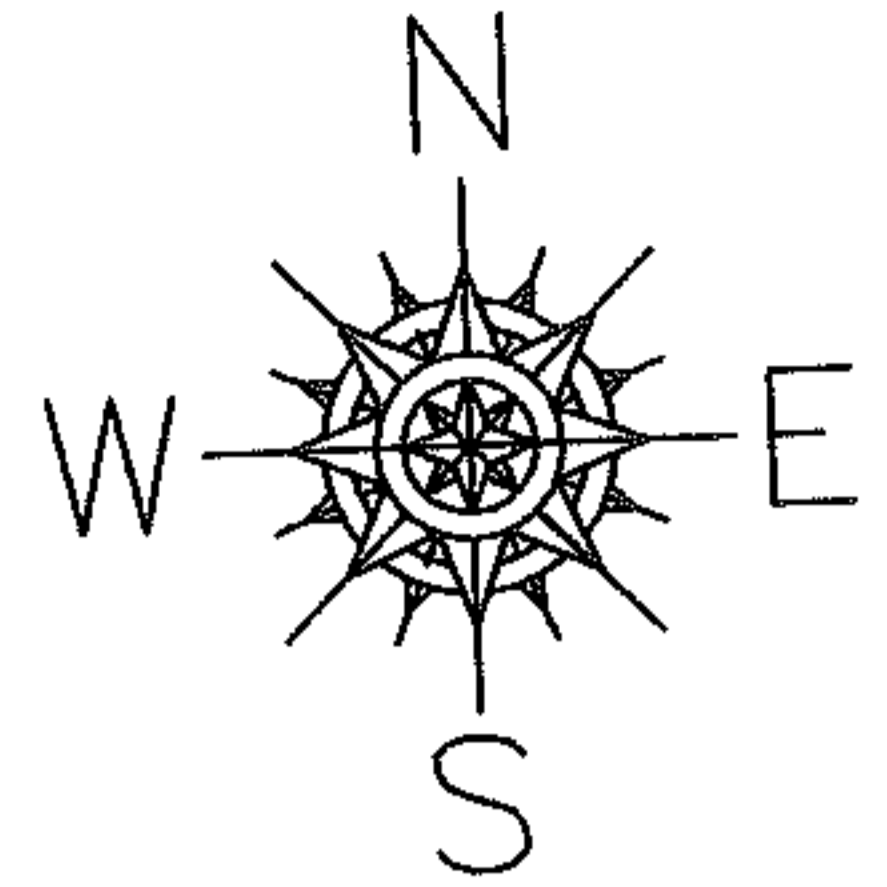

ST FRANCIS DR

RD

673.12

319.22

LEAR NAGLE

365.01

596.70

-484
4.37 A.

319.08


~~-272~~
~~9.37 A.~~

596.70

-485
5.00 A.

365.01

596.70

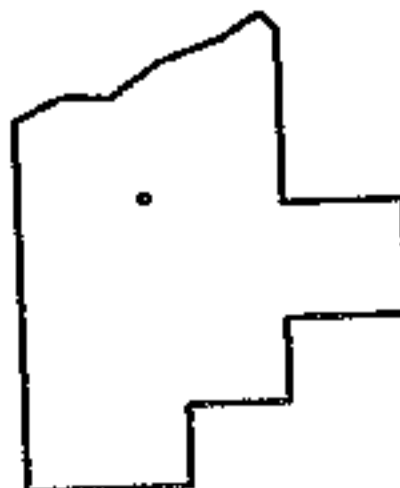

SPLITS/DEEDS PROCESSED

LORAIN COUNTY TAX MAP DEPARTMENT
226 MIDDLE AVE. ELYRIA, OHIO

SURVEYED BY: JOHN POZYWAK

CLOSURE: 0.00 : 10.000

MAP PAGE(S): 04-00-025-E

APPROVED BY: JAH DATE: 10-3-06

SCALE: 1" = 200 PRIOR INSTRUMENT: 20030882571