




RASVER

PARENT PARCEL: 06-24-004-000-018

11-02231-A

CHILD PARCEL:

STARTING POINT: INTERSECTION OF C/L OF MURRAY RIDGE RD. AND NORTH LINE OF O.L.4

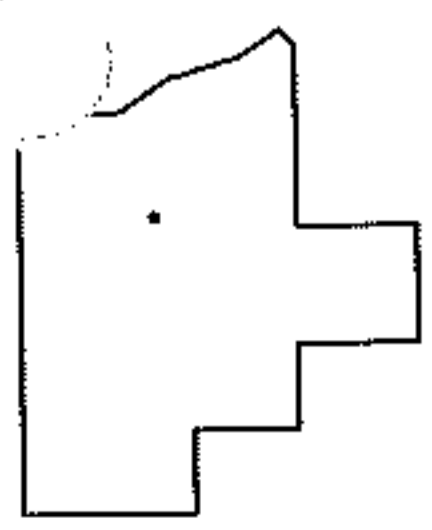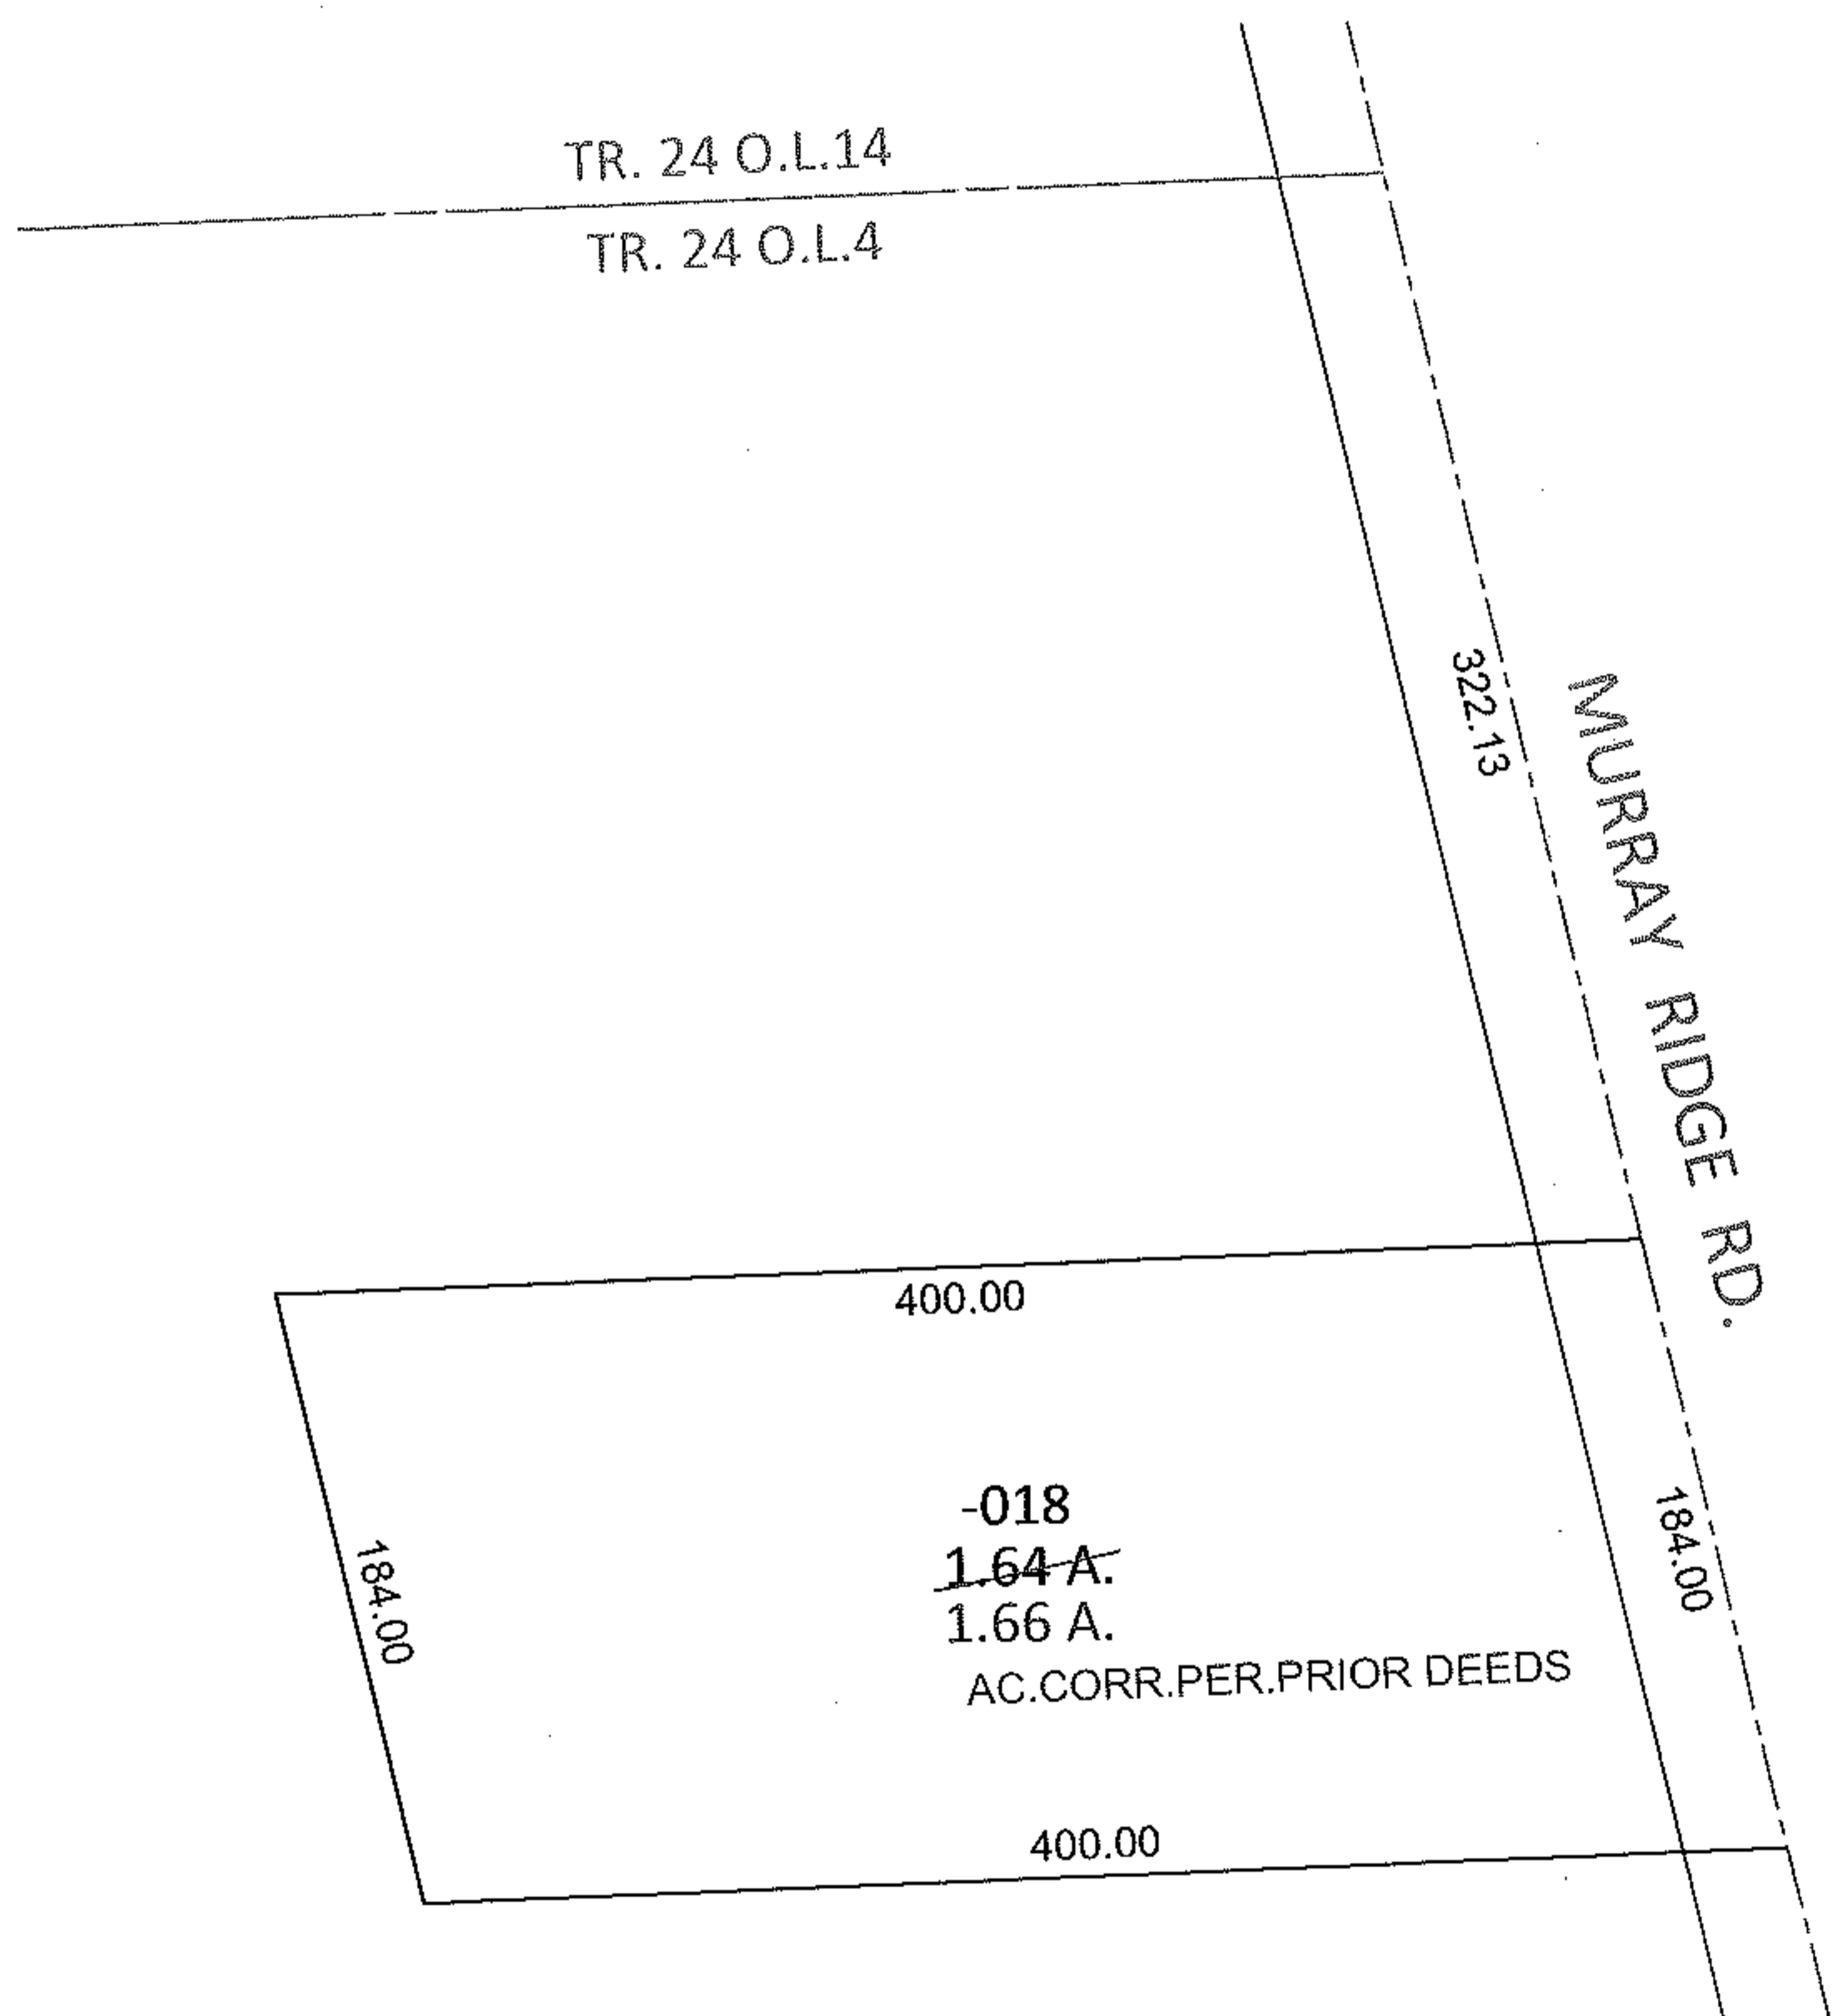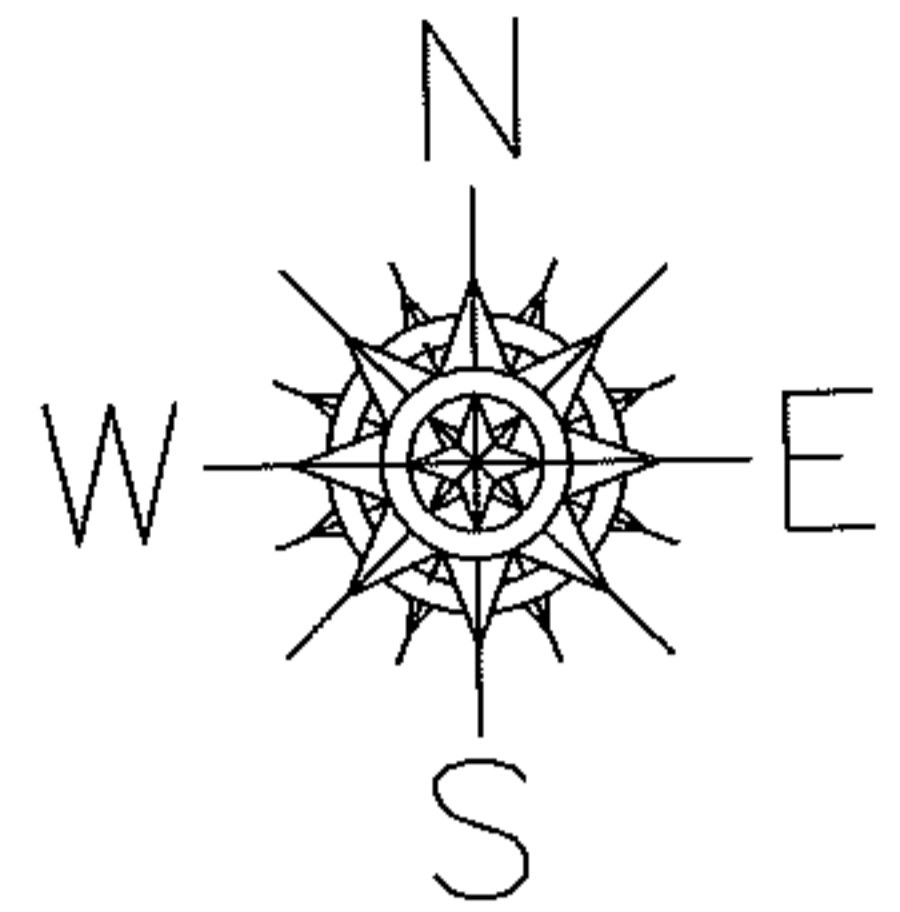

SPLITS/DEEDS PROCESSED

LORAIN COUNTY TAX MAP DEPARTMENT
226 MIDDLE AVE. ELYRIA, OHIO

SURVEYED BY: N/A

CLOSURE: .00:10,000

MAP PAGE(S): 6-112

APPROVED BY: RRM DATE: 3-16-11

SCALE: 1"= 100 PRIOR INST.: 20030881548