




RASTER

PARENT PARCEL: 21-05-003-000-004

06-02231

CHILD PARCEL: 21-05-003-000-011 THRU -013

STARTING POINT: CENTERLINE OF BURSLEY RD & ASHLAND-OBERLIN RD

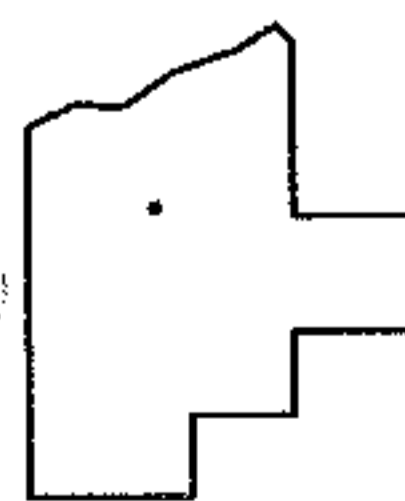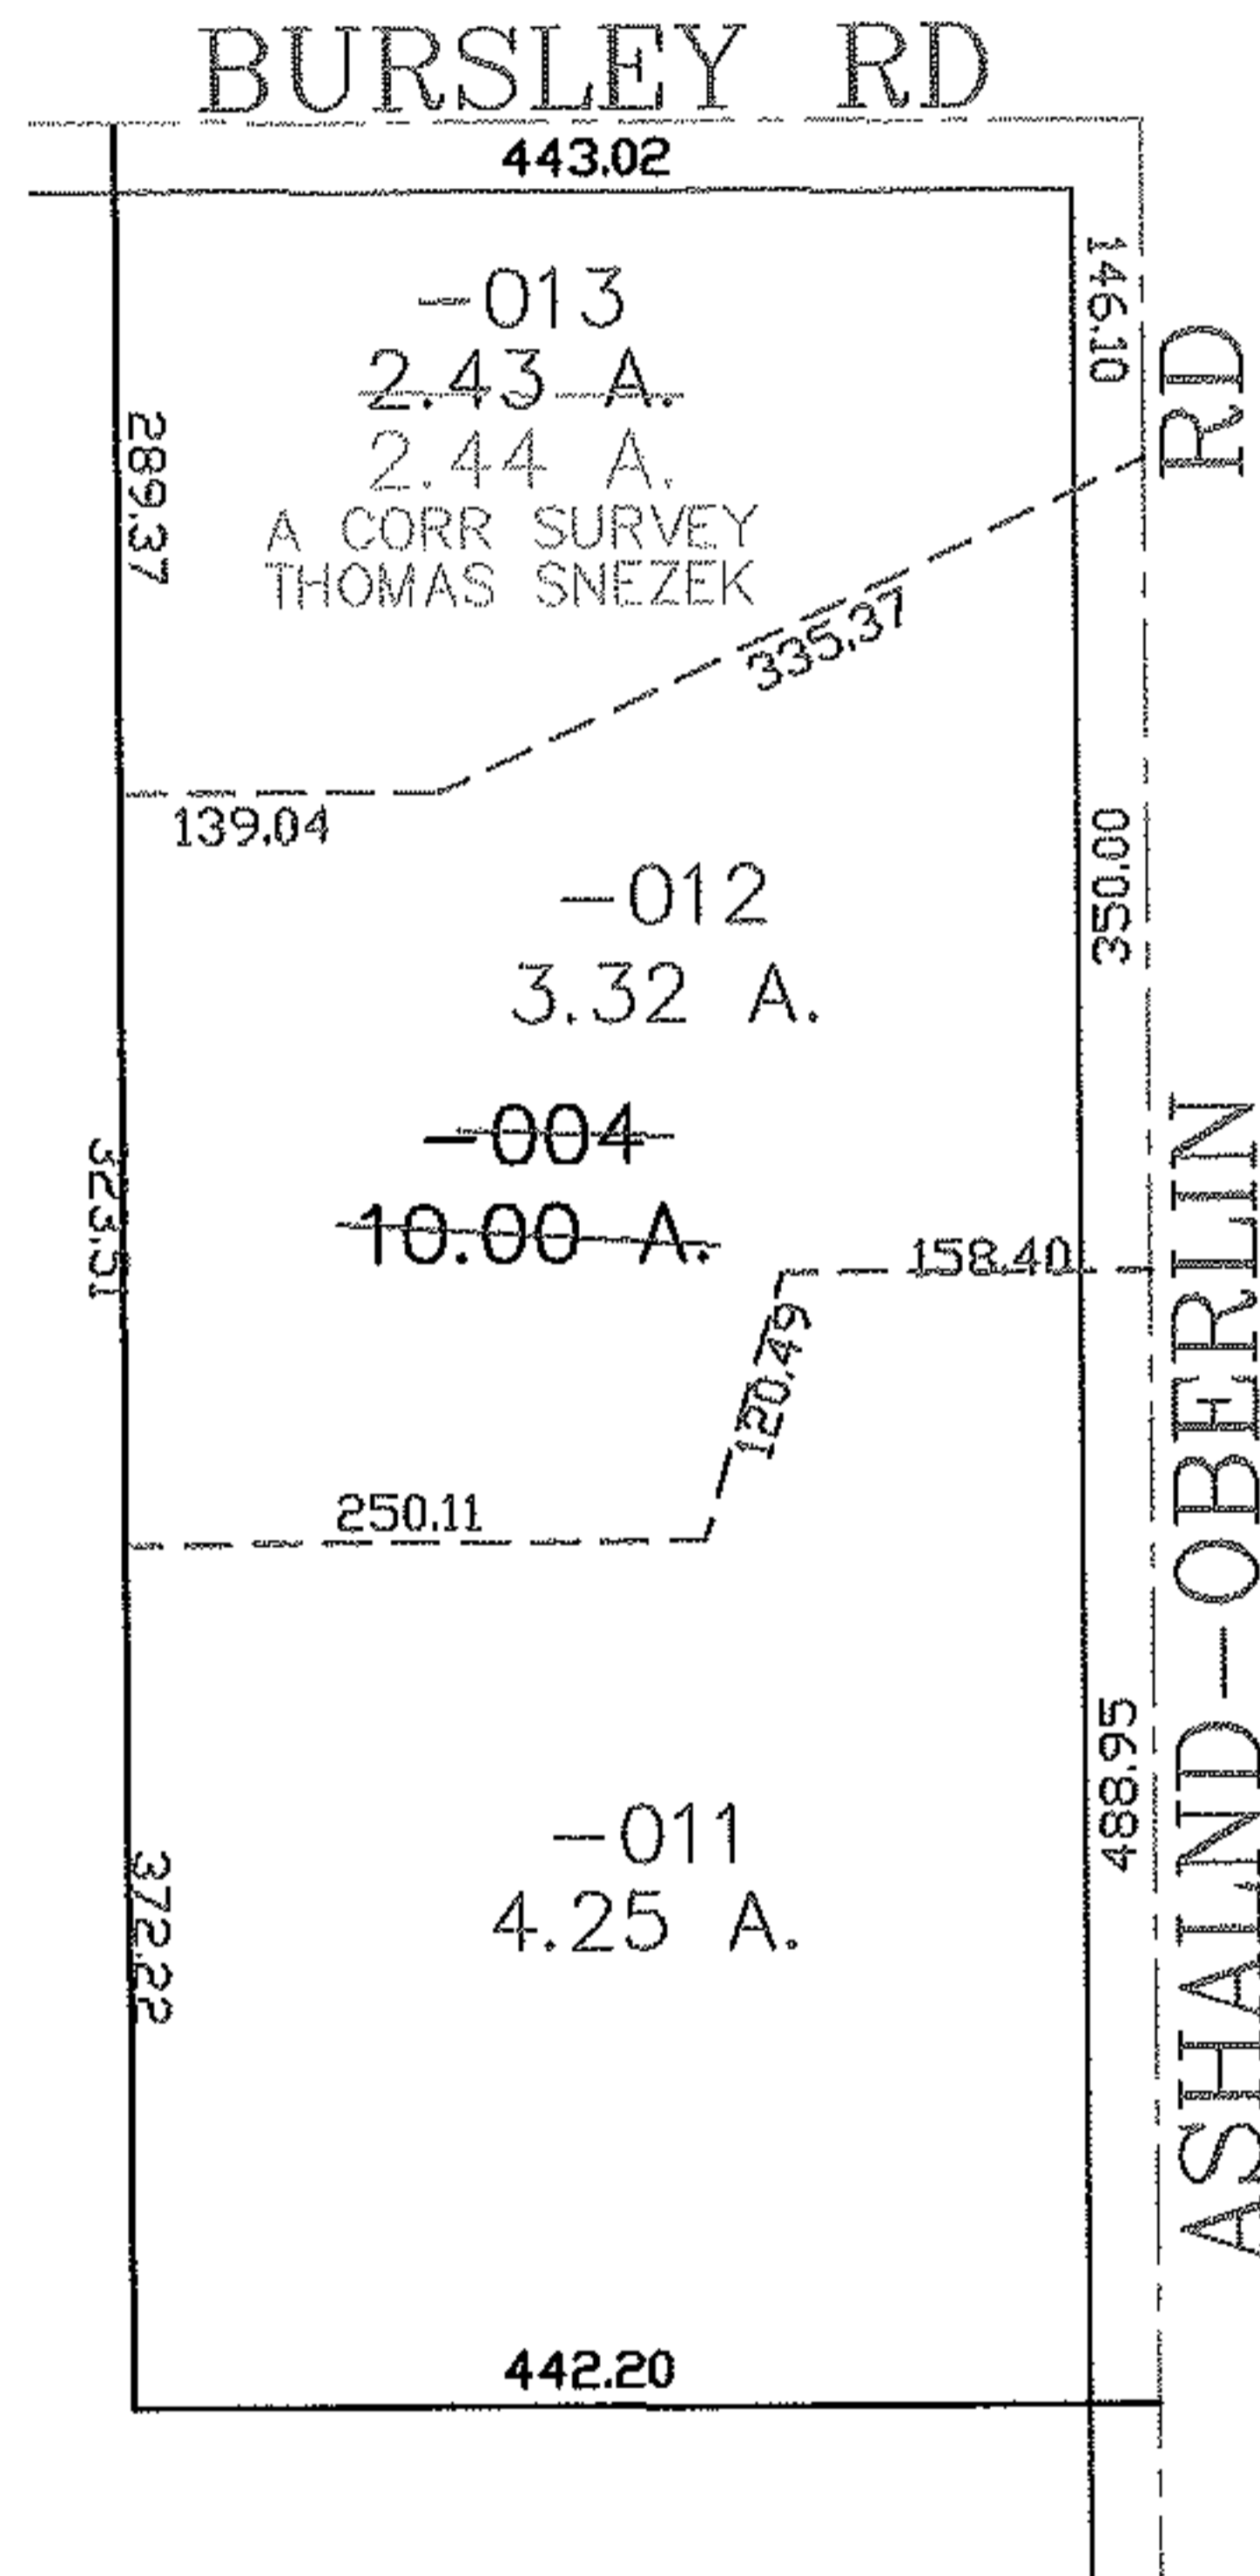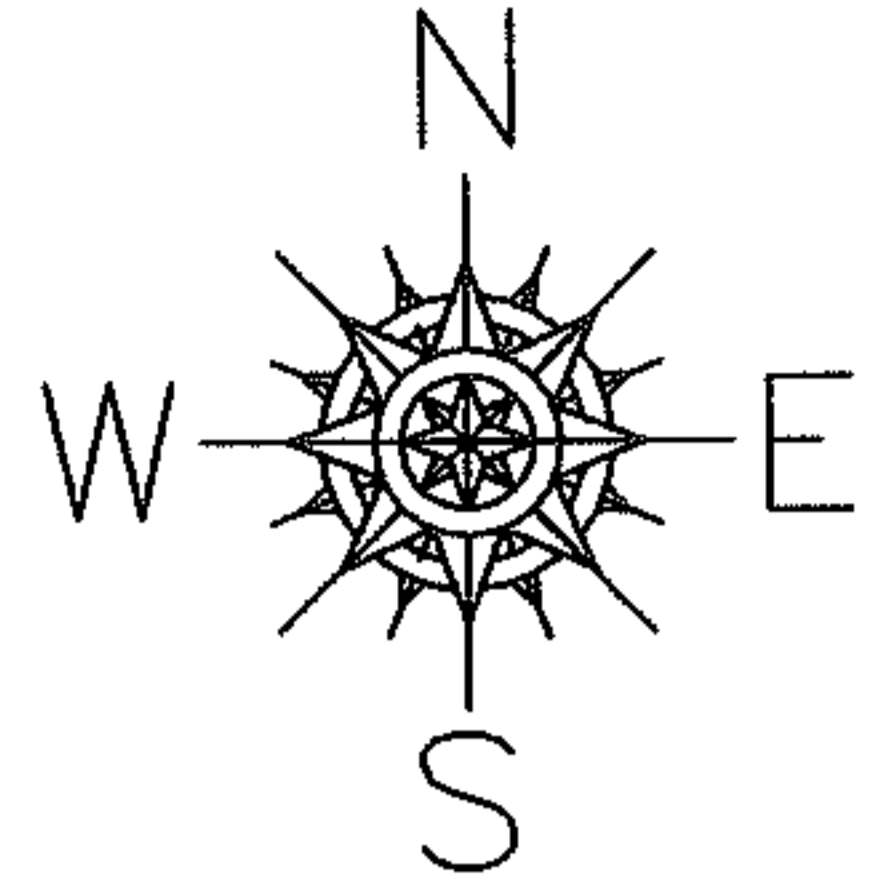

**SPLITS/DEEDS PROCESSED**  
**LORAIN COUNTY TAX MAP DEPARTMENT**  
 226 MIDDLE AVE. ELYRIA, OHIO

SURVEYED BY: THOMAS SNEZEK  
 CLOSURE: 0.00 : 10.000  
 MAP PAGE(S): 21-05-003-B  
 APPROVED BY: JAH DATE: 10-04-06  
 SCALE: 1" = 200 PRIOR INSTRUMENT: 2004098612