
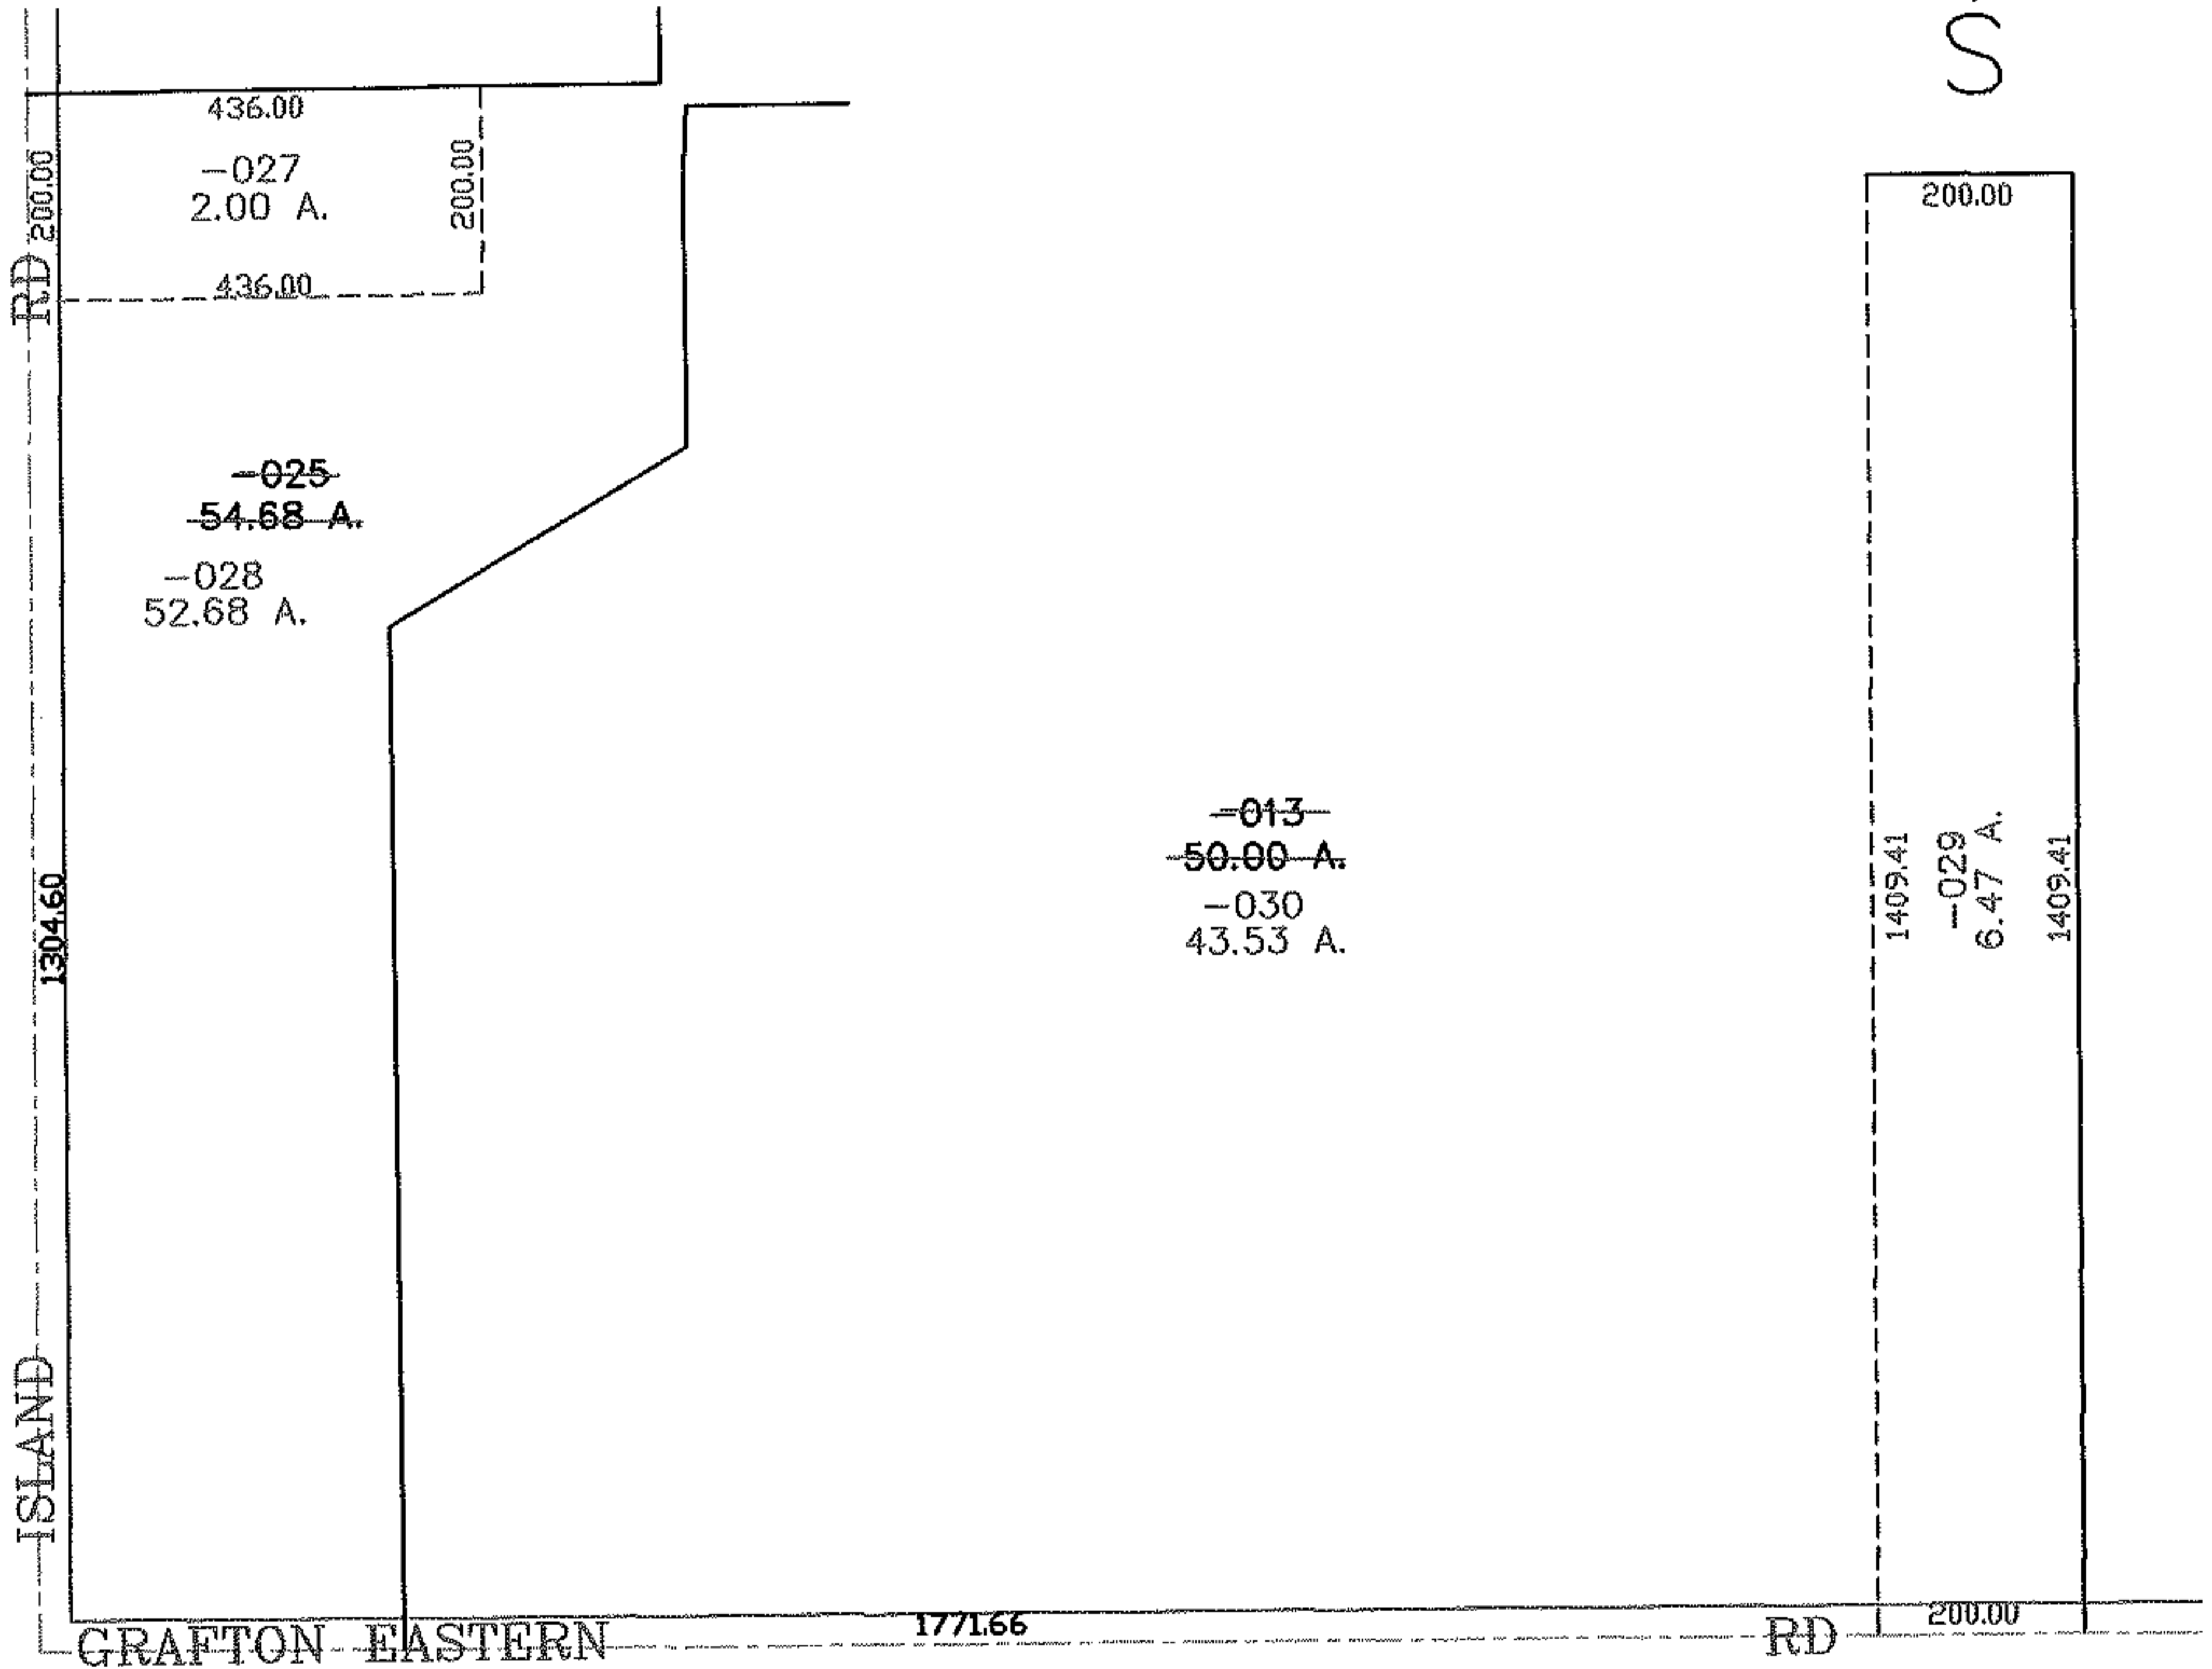


PARENT PARCEL: 16-00-013-000-025, -013

CHILD PARCEL: 16-00-013-000-027 THRU -030

STARTING POINT: CENTERLINE OF ISLAND RD & GRAFTO EASTERN RD

06-02235

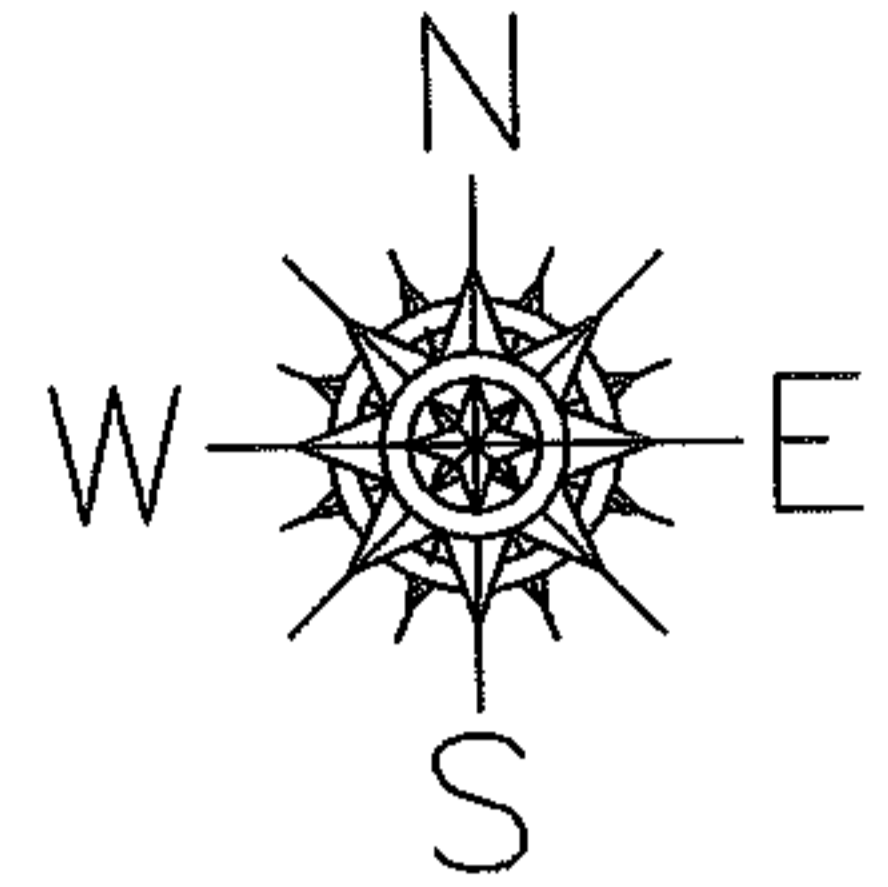

SPLITS/DEEDS PROCESSED

LORAIN COUNTY TAX MAP DEPARTMENT
226 MIDDLE AVE. ELYRIA, OHIO

SURVEYED BY: RICHARD CARLSON

CLOSURE: 0.00 : 10,000

MAP PAGE(S): 16-B

APPROVED BY: JAH DATE: 10-12-06

SCALE: 1" = 100 PRIOR INSTRUMENT: OR 807/943