



RASTER

PARENT PARCEL: 06-23-011-101-062, -038

CHILD PARCEL: 06-23-011-101-078 THRU -080

STARTING POINT: CENTERLINE OF GREENFIELD DR & LAKE AVE

06-02236

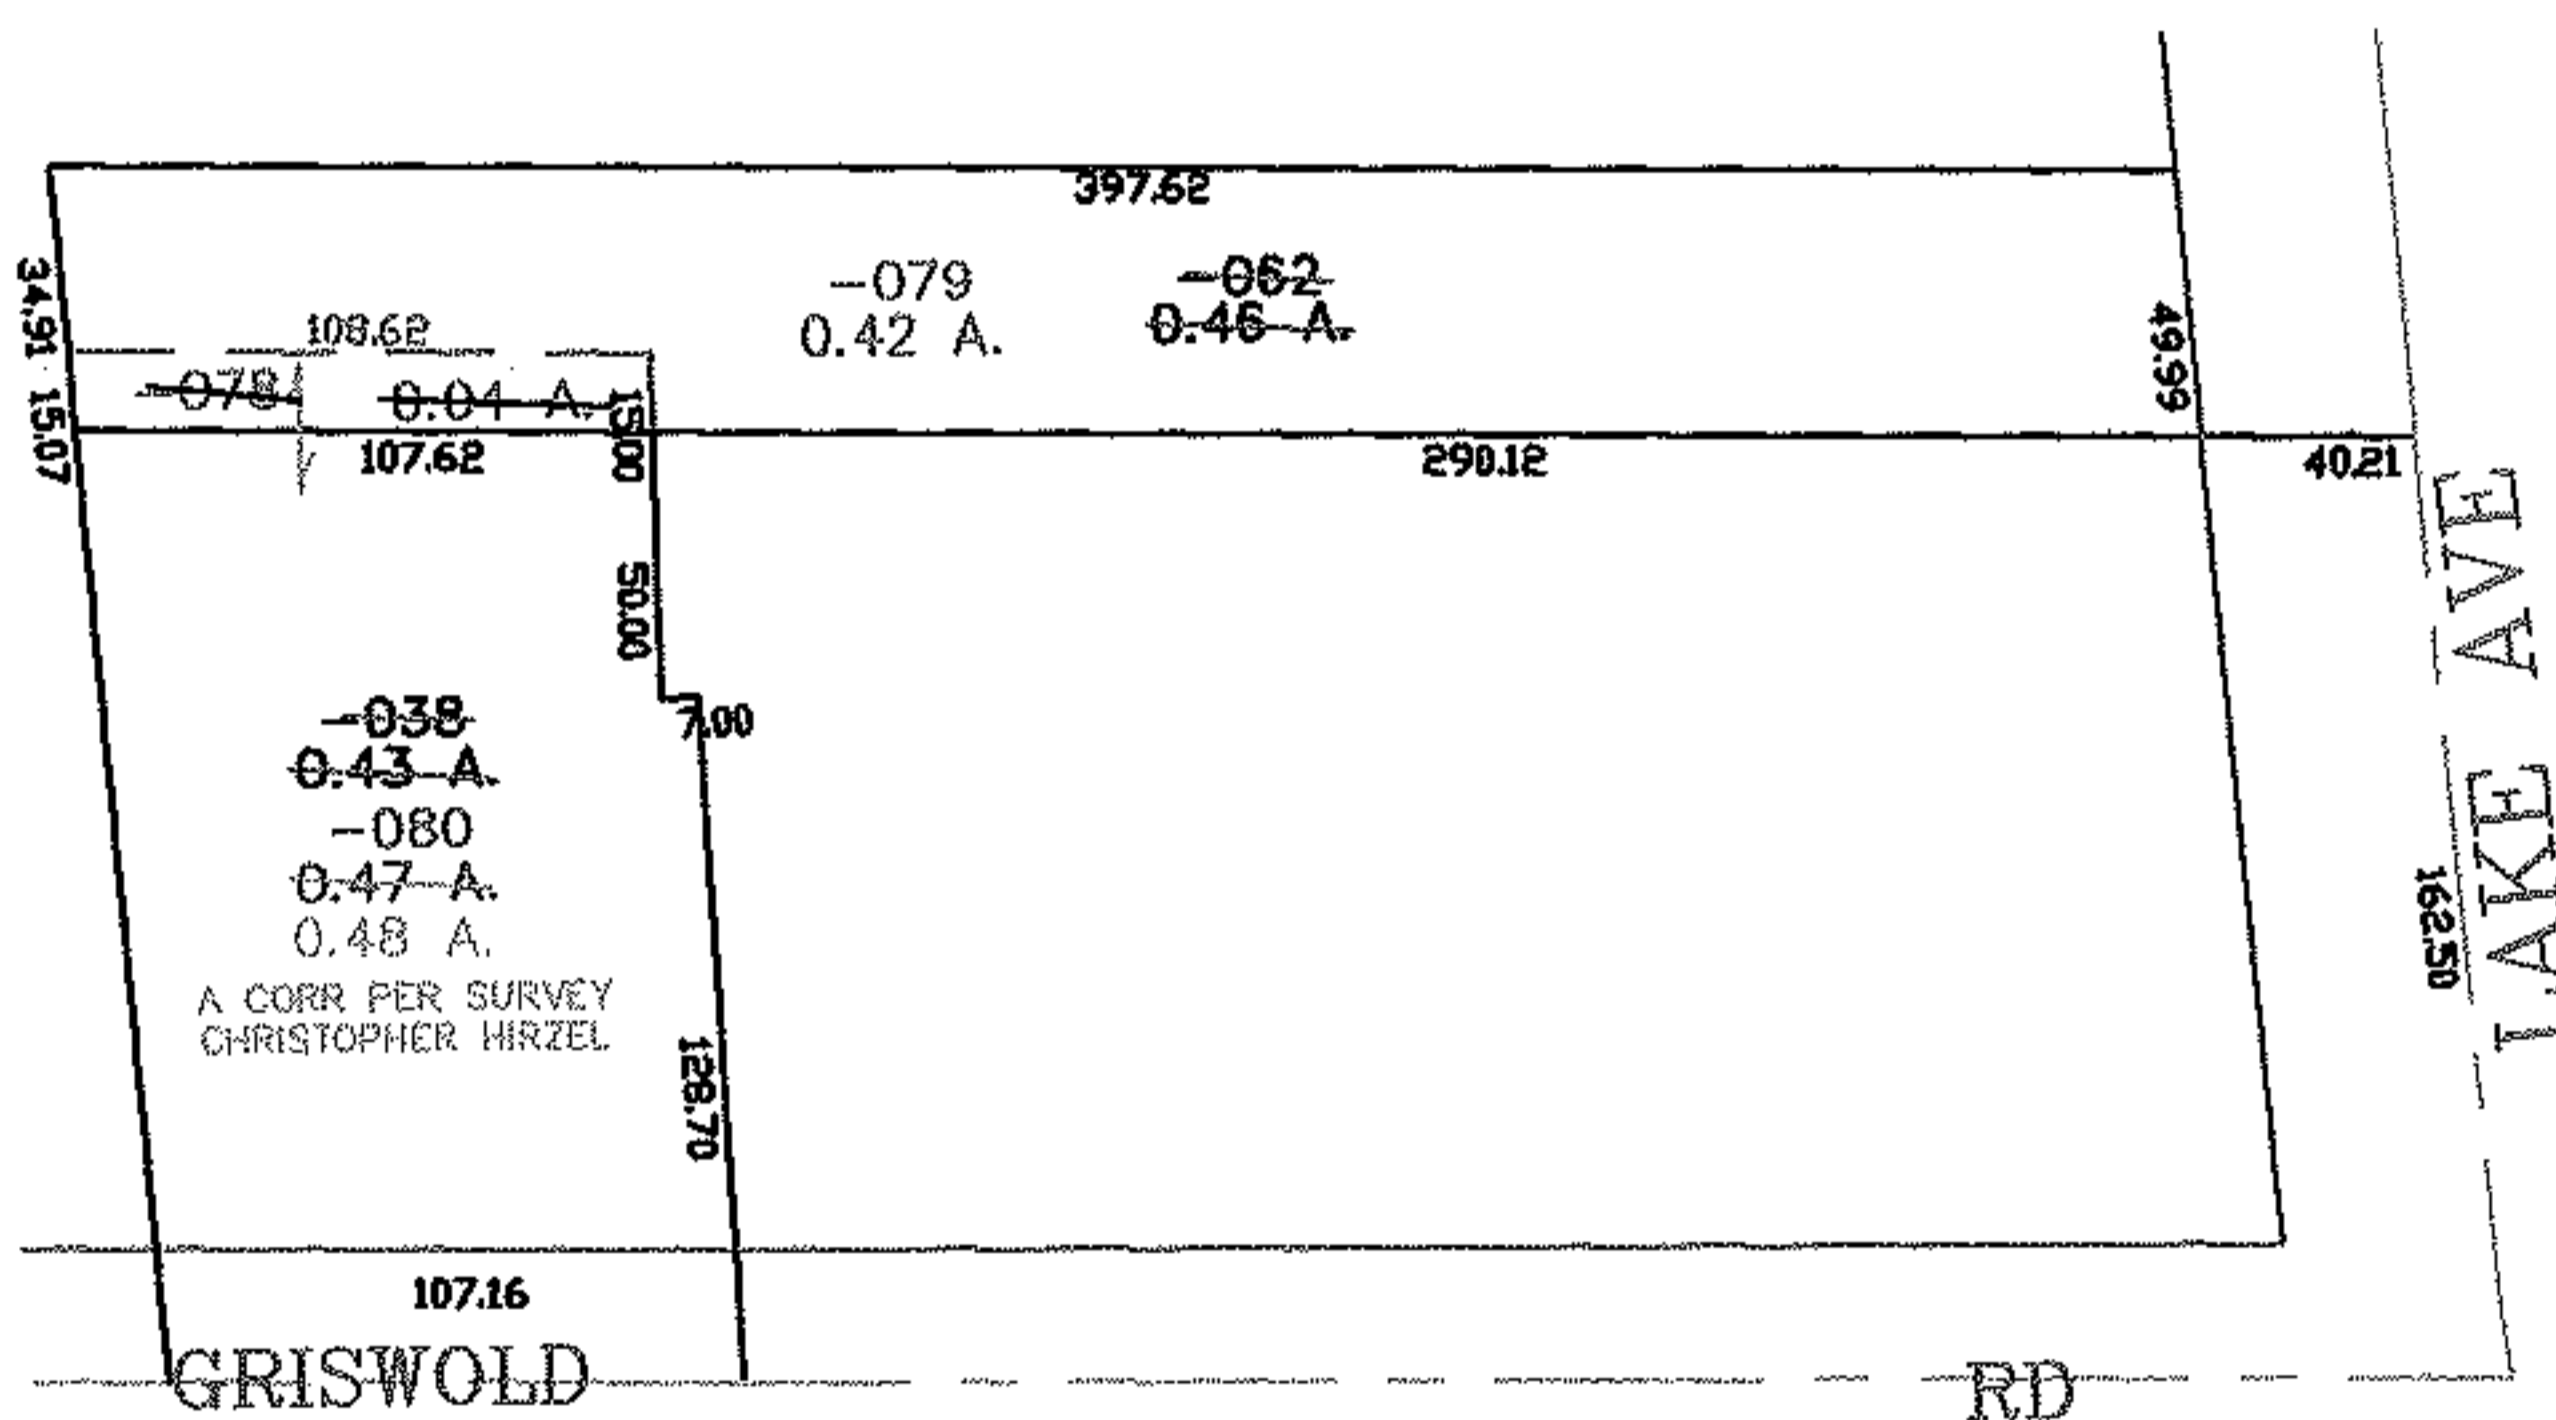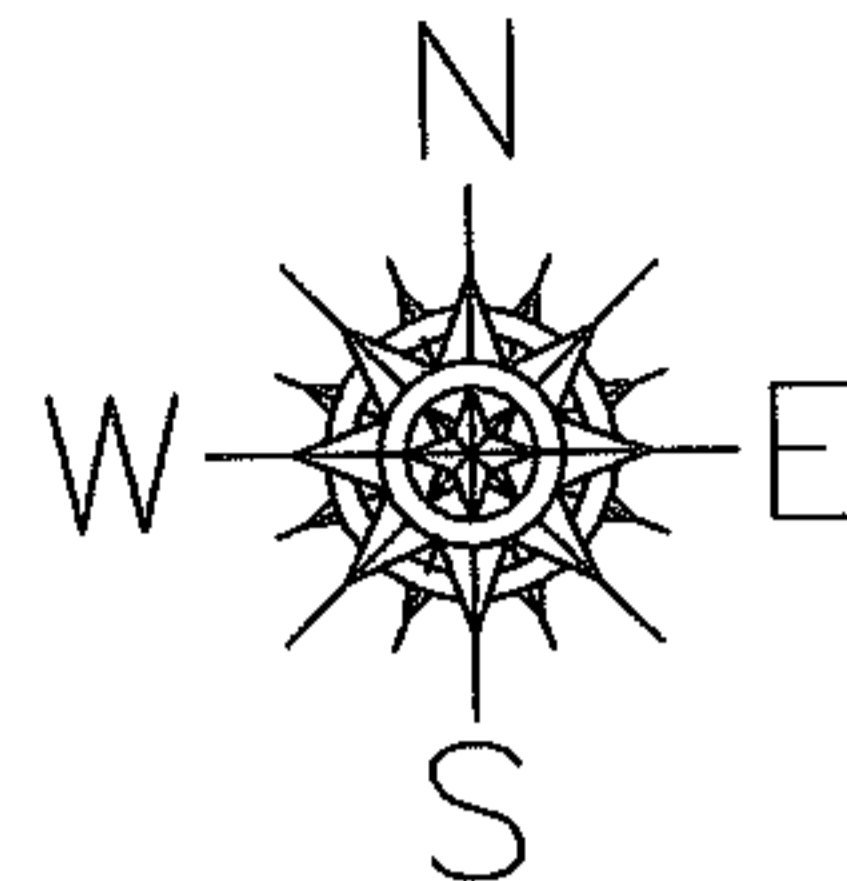

SPLITS/DEEDS PROCESSED

LORAIN COUNTY TAX MAP DEPARTMENT
226 MIDDLE AVE. ELYRIA, OHIO

SURVEYED BY: CHRISTOPHER HIRZEL

CLOSURE: 0.00 : 10.000

MAP PAGE(S): 6-42

APPROVED BY: JAH DATE: 10-12-06

SCALE: 1" = 100 PRIOR INSTRUMENT: 20060126397