




RASTER

PARENT PARCEL: 15-00-012-000-022, -021

CHILD PARCEL: 15-00-012-000-023 THRU -025 15-00-011-000-040, -041

STARTING POINT: CENTERLINE OF INDIAN HOLLOW RD & CROOK ST

06-02237

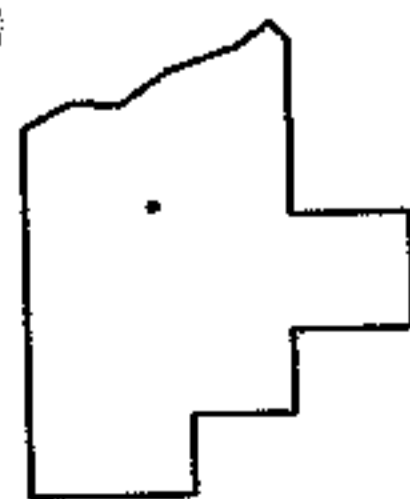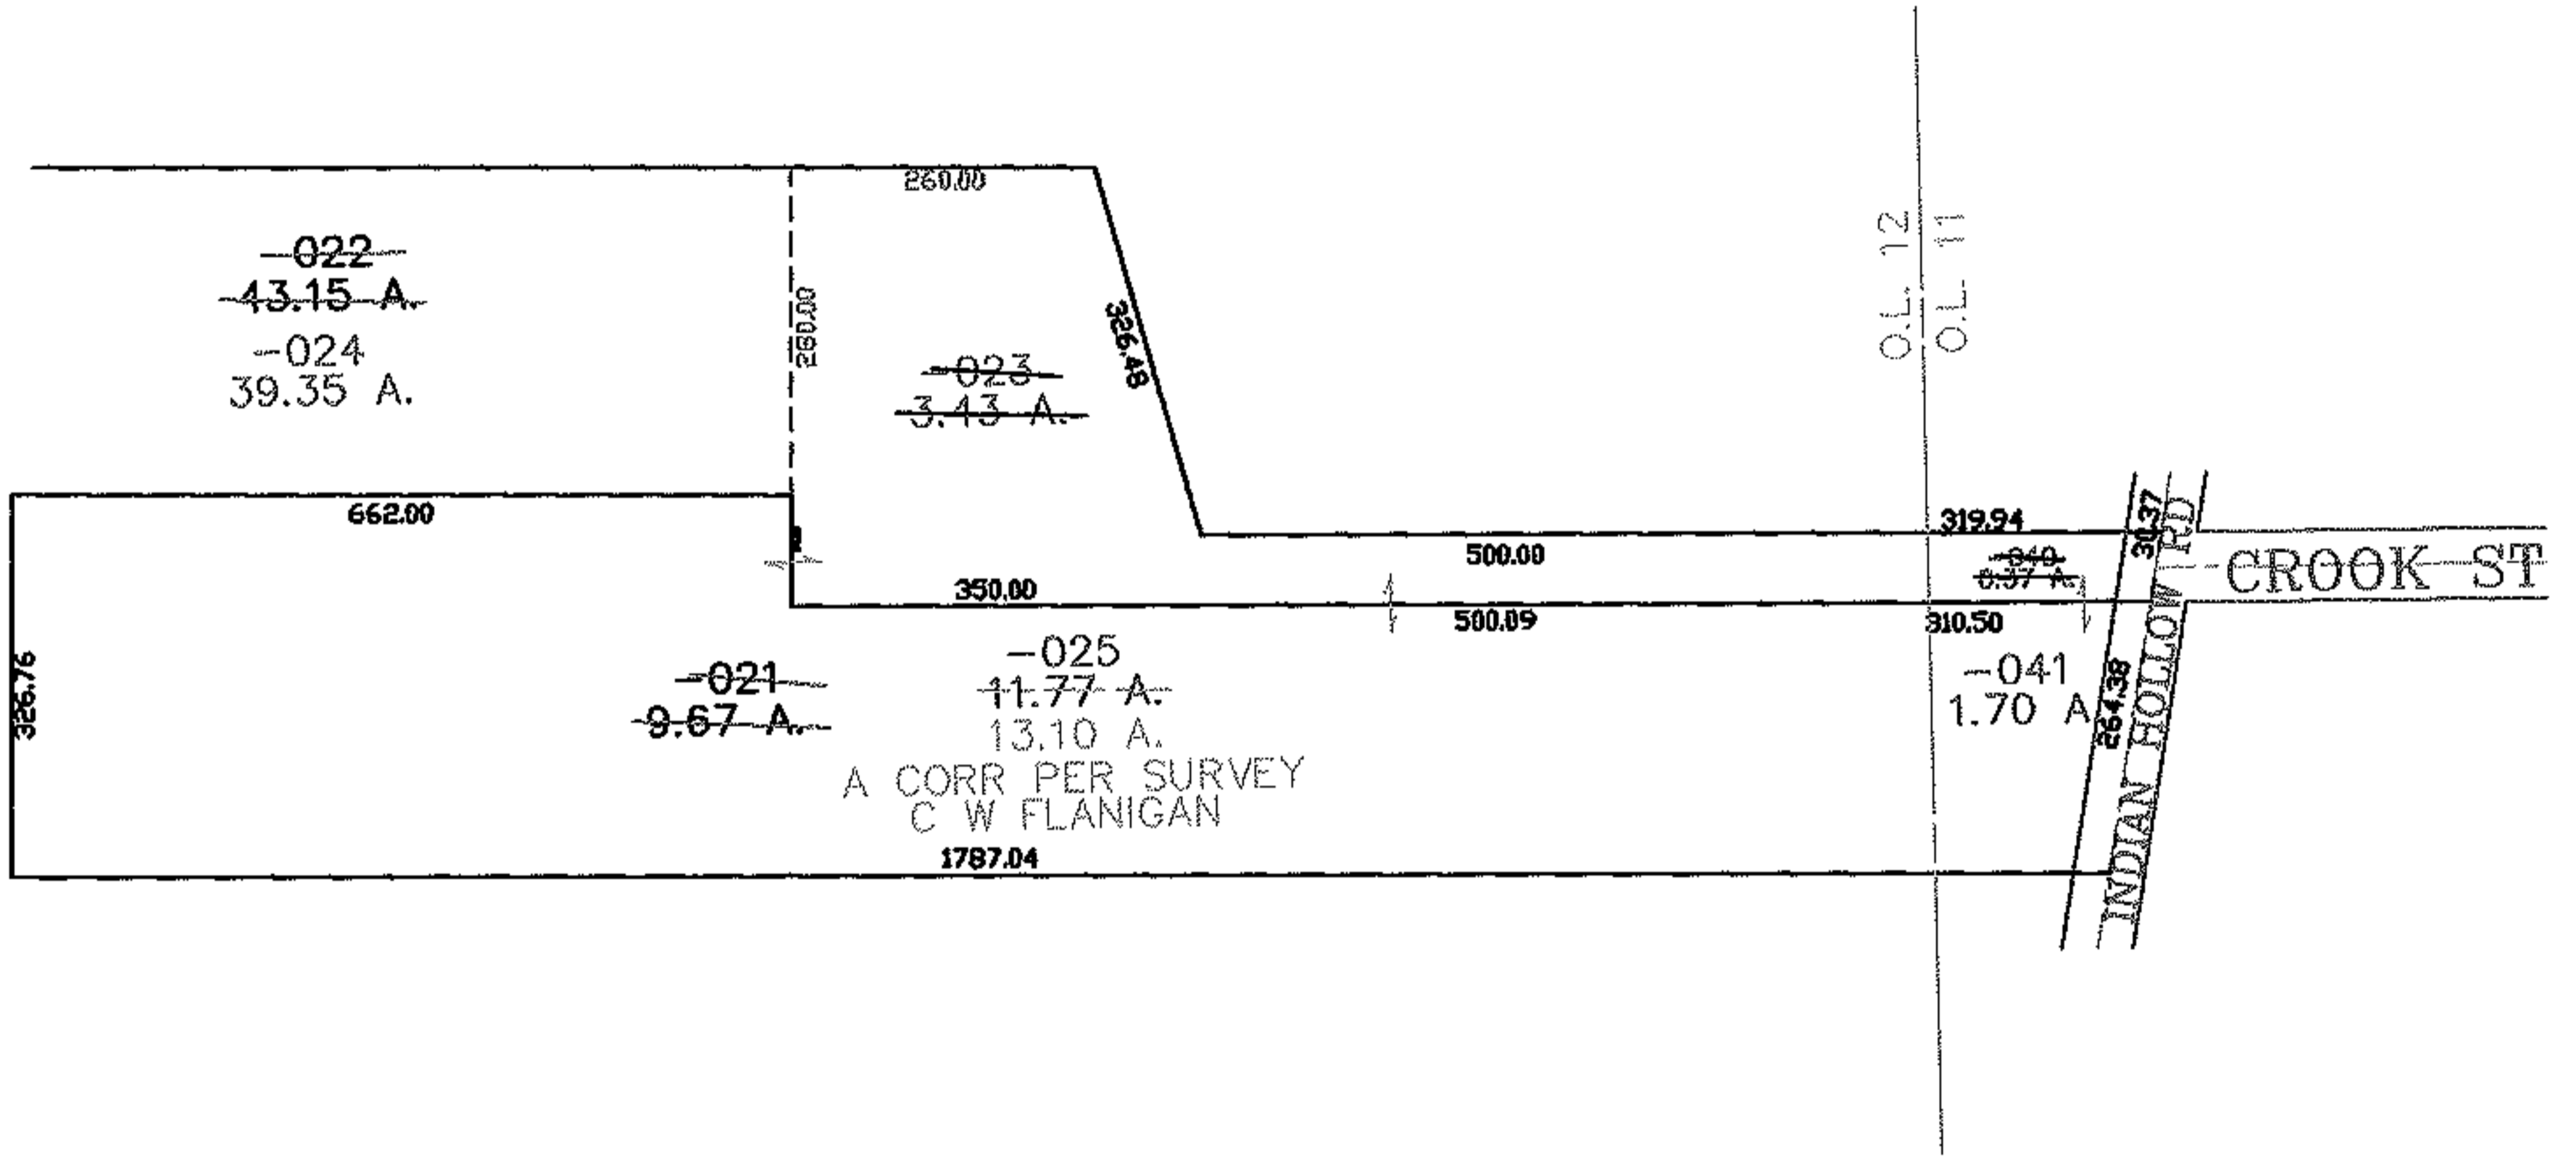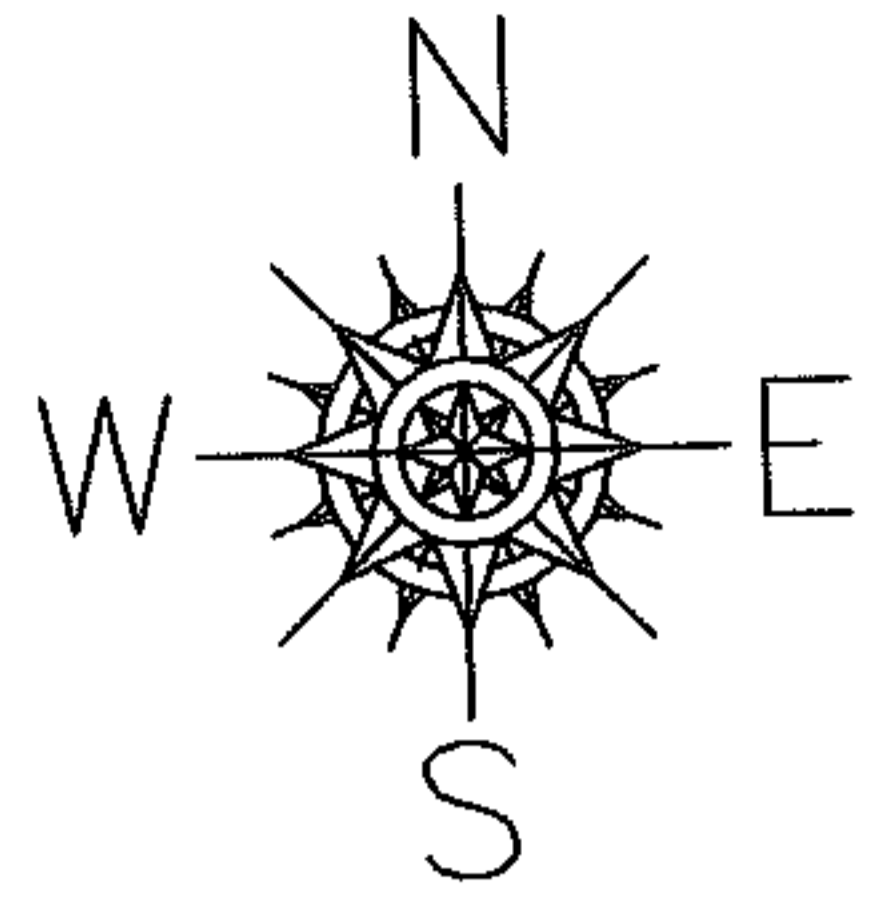

SPLITS/DEEDS PROCESSED
LORAIN COUNTY TAX MAP DEPARTMENT
226 MIDDLE AVE. ELYRIA, OHIO

SURVEYED BY: CW FLANIGAN
CLOSURE: 0.00 : 10.000
MAP PAGE(S): 15-A
APPROVED BY: JAH DATE: 10-23-06
SCALE: 1" = 300 PRIOR INSTRUMENT: 20060139405