


PARENT PARCEL: 03-00-001-700-003

CHILD PARCEL: 03-00-001-000-170, & 03-00-001-700-004


STARTING POINT: MON. BOX, CL OF N. RIDGE RD. & CL OF ABBE RD.

NO. 06-02241

N. RIDGE RD. (DETROIT RD. - S.R. 254)

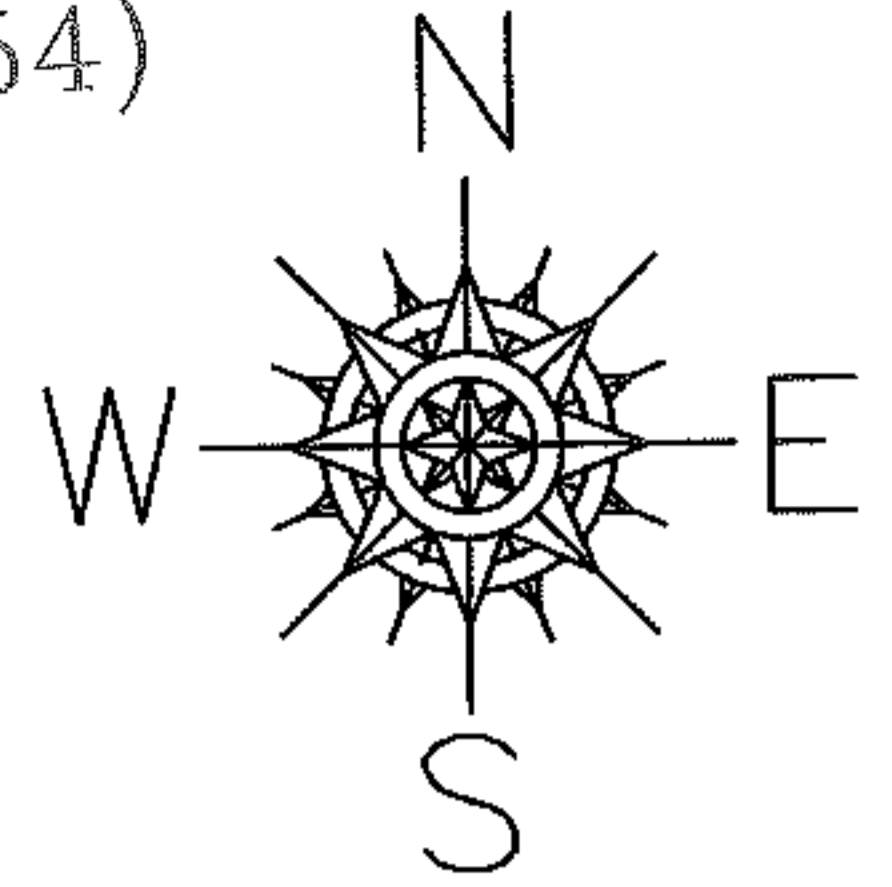

N. ABBE RD. (S.R. 301)

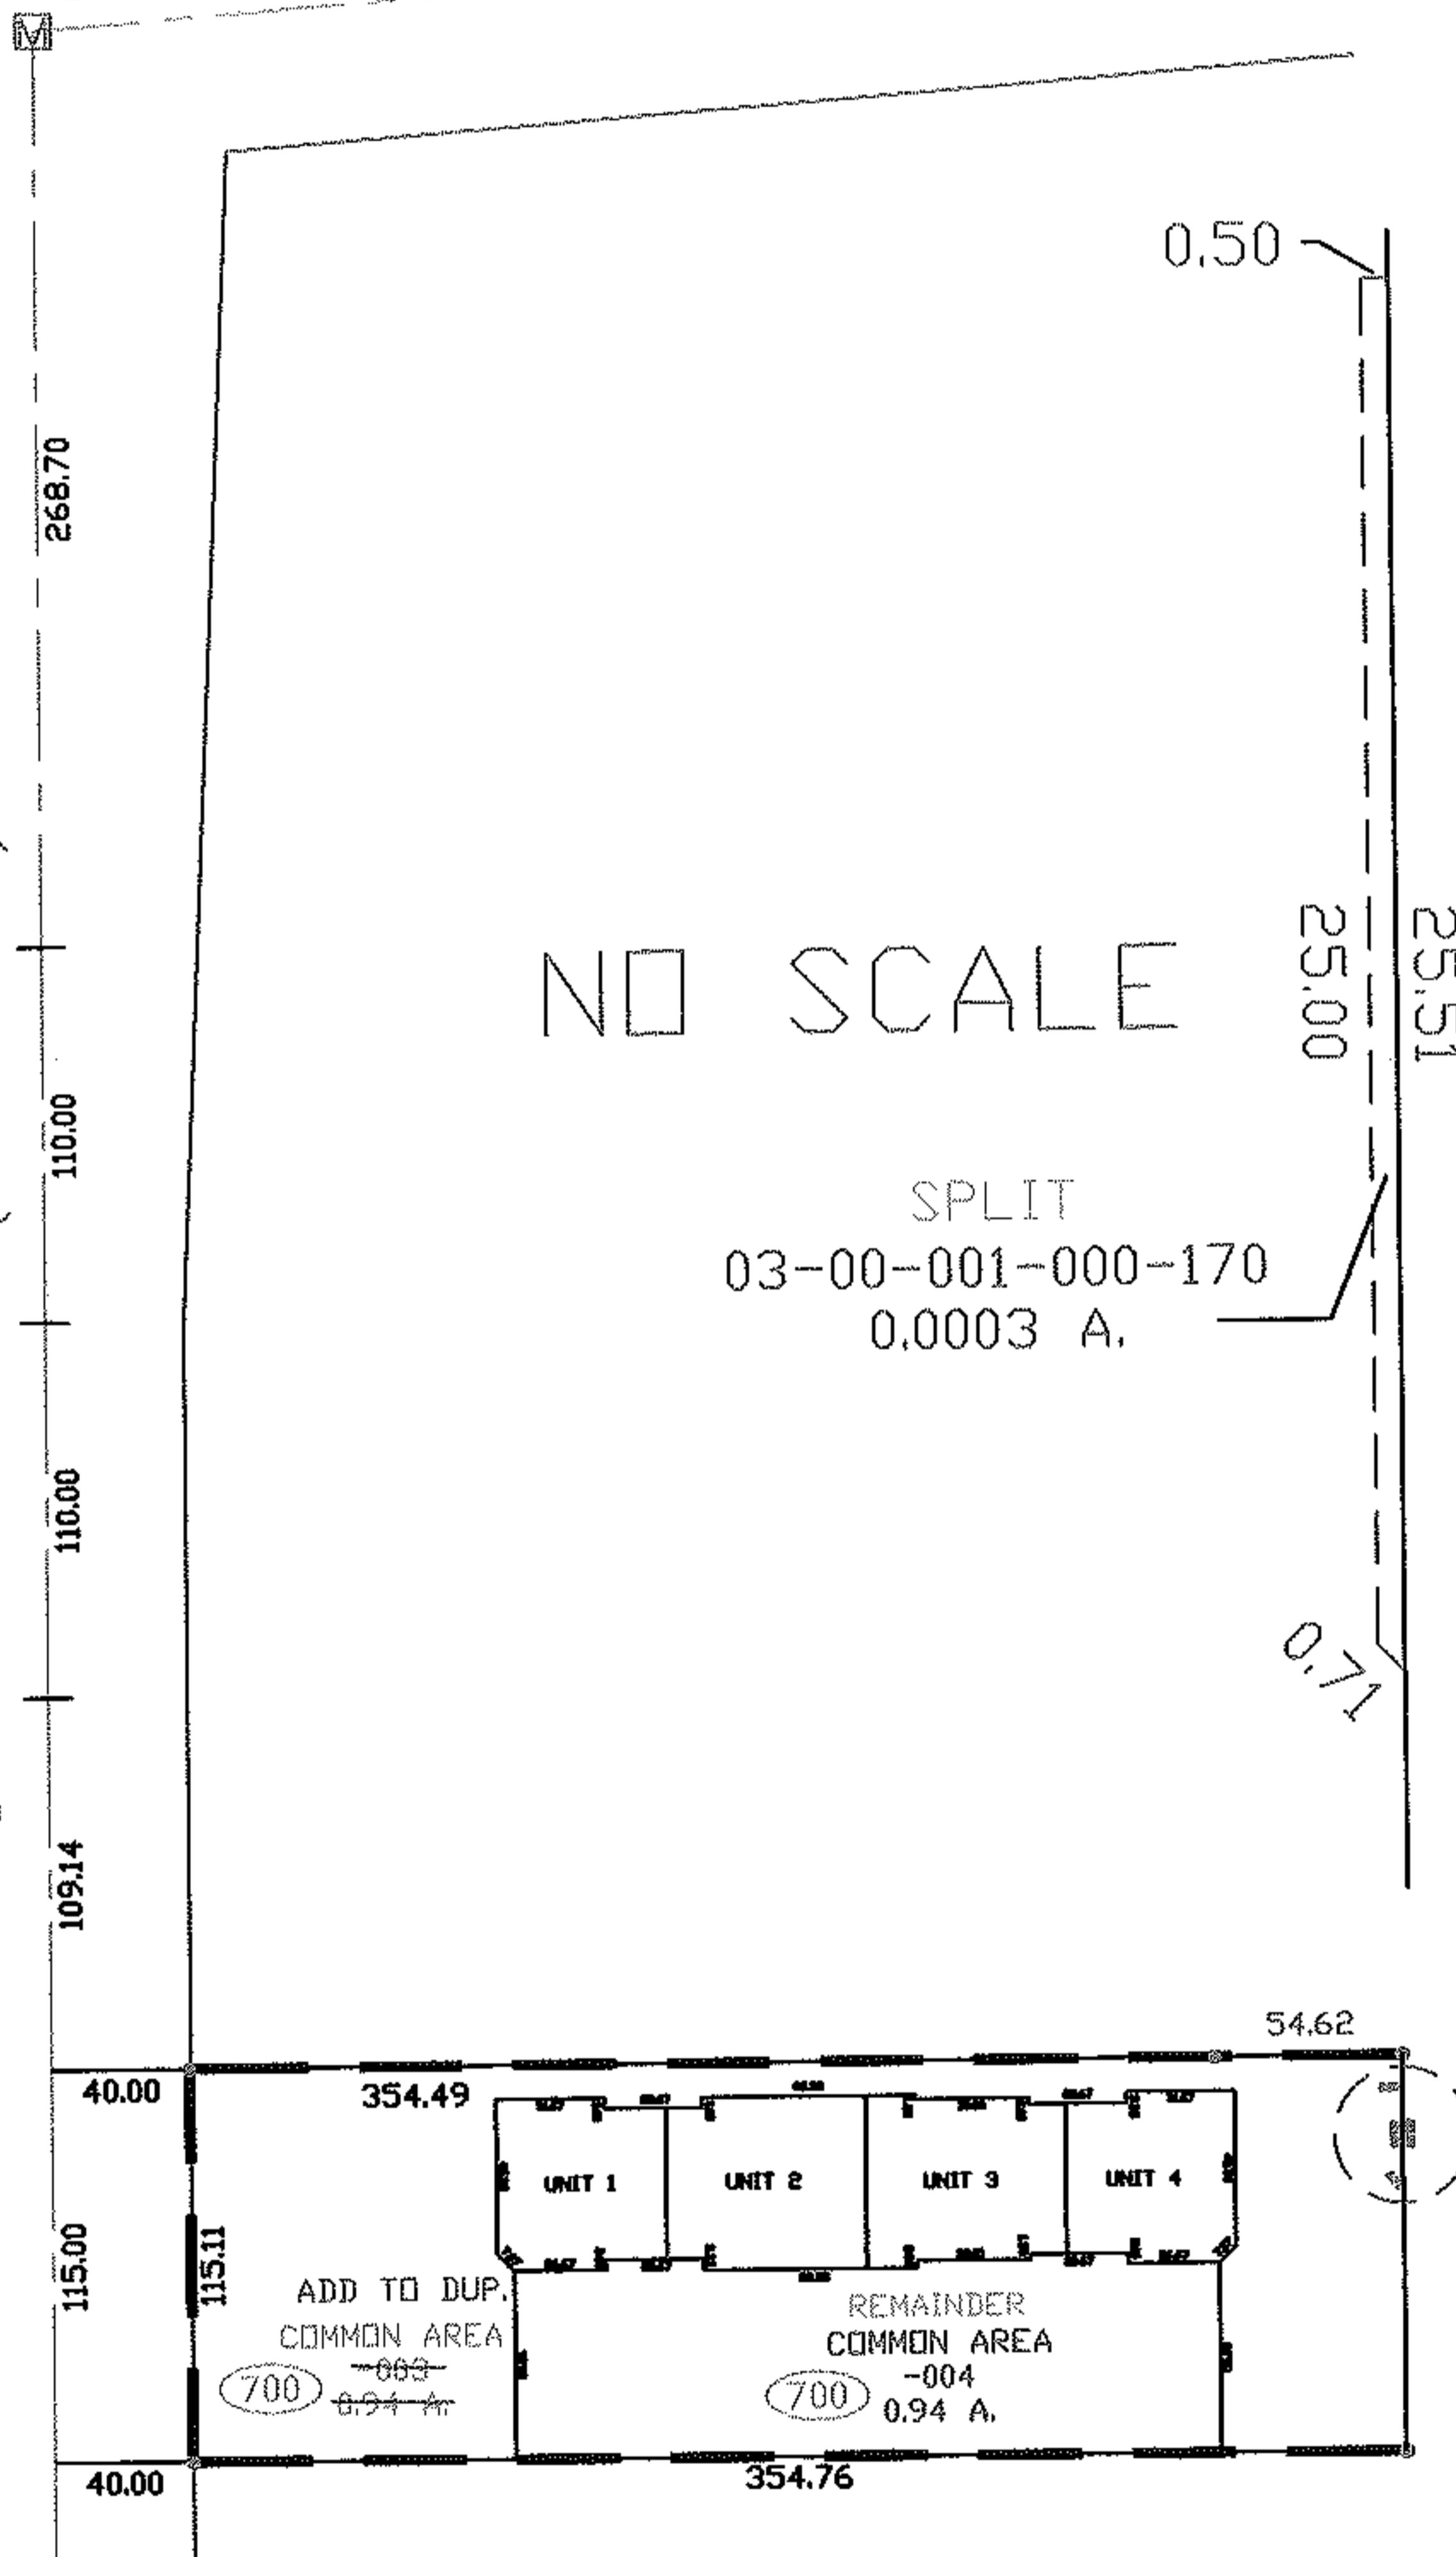

NO SCALE

SPLIT
03-00-001-000-170
0.0003 A.


ADD TO DUP.
COMMON AREA
03-00-001-700-003
0.94 A.

SPLIT
03-00-001-000-170
0.0003 A.

REMAINDER
COMMON AREA
-004
0.94 A.

ADD TO DUP.
COMMON AREA
-003
0.94 A.

REMAINDER
COMMON AREA
-004
0.94 A.

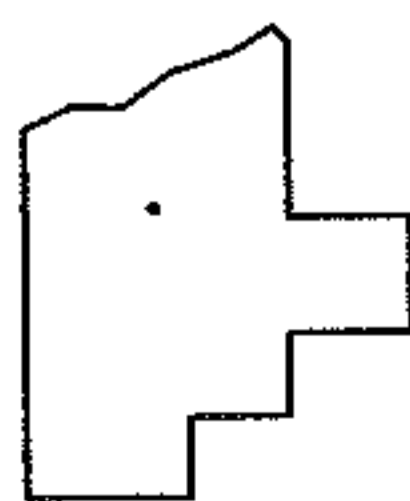

SPLITS/DEEDS PROCESSED
LORAIN COUNTY TAX MAP DEPARTMENT
226 MIDDLE AVE. ELYRIA, OHIO

SURVEYED BY: DAVID L. ELWELL
CLOSURE: 0.01 : 10.000
MAP PAGE(S): 3-00-001-A
APPROVED BY: TJS DATE: 10/18/06
SCALE: 1" = 100 PRIOR INSTRUMENT: PV 73 P. 61-63