
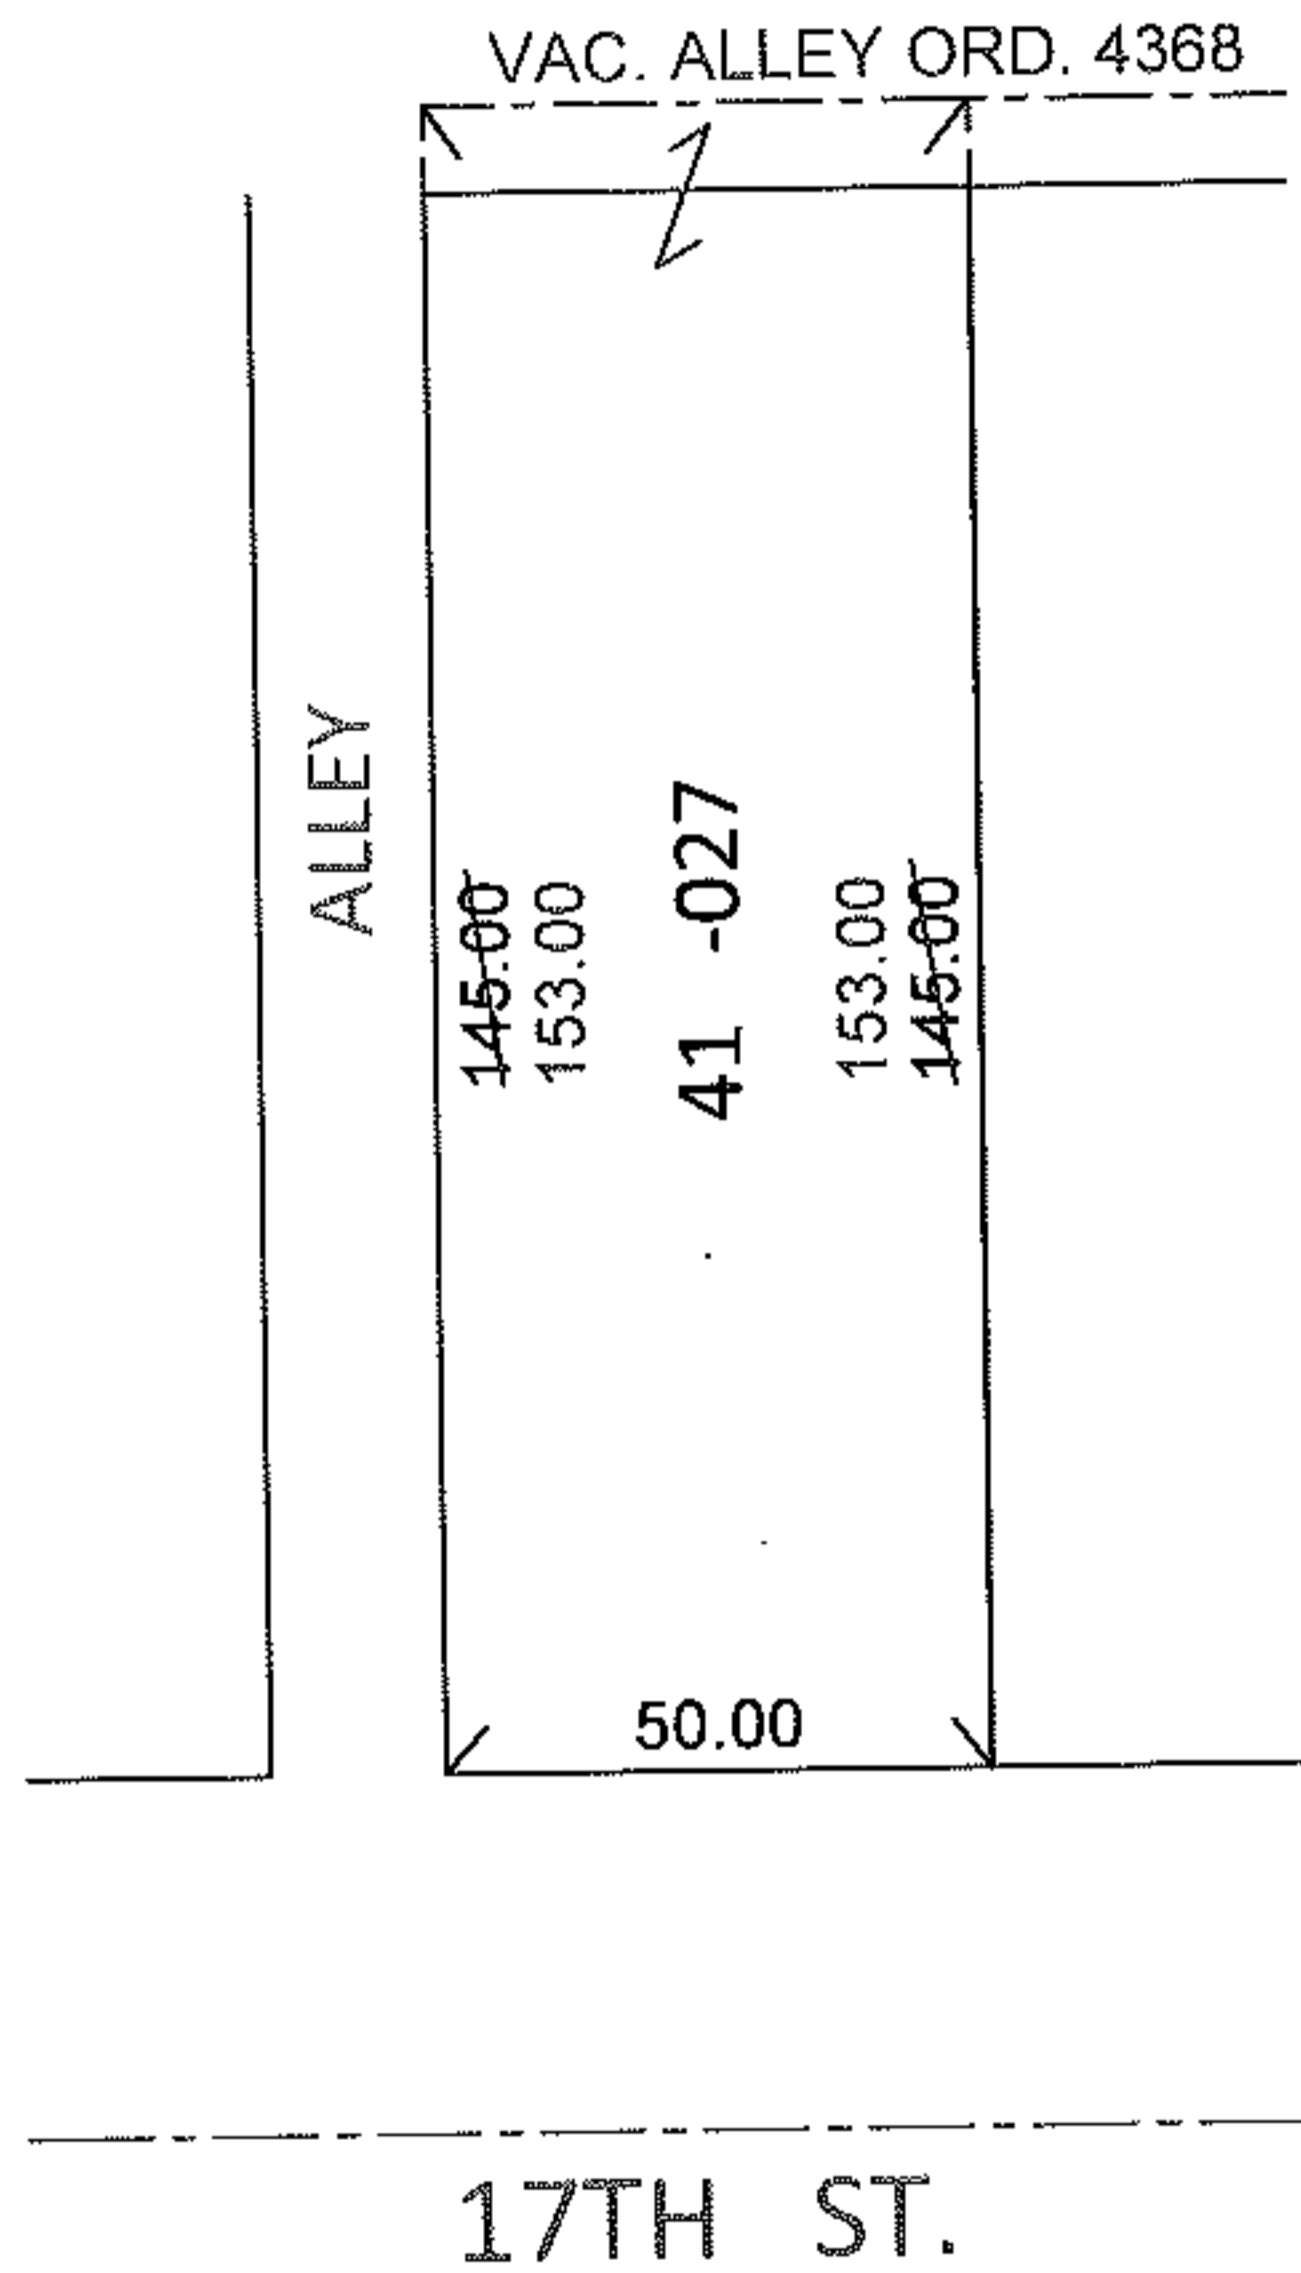


PARENT PARCEL: 02-01-006-130-027

CHILD PARCEL:

STARTING POINT: S/L 41 IN W.S. STREATOR TR. SUB. NO.1(VOL.5 PG.11)

11-02242-C

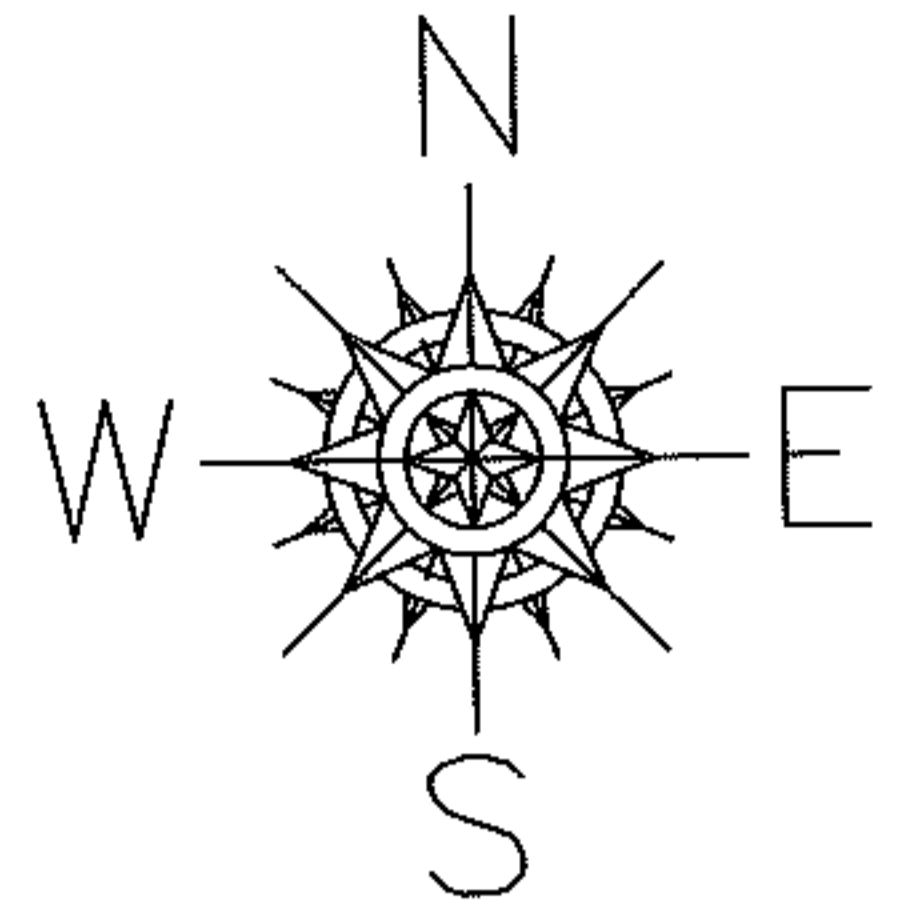


DEPTH CORRECTION

02-01-006-130-027

153
50 X ~~145~~

PER DEED & VAC. ORD. 4368

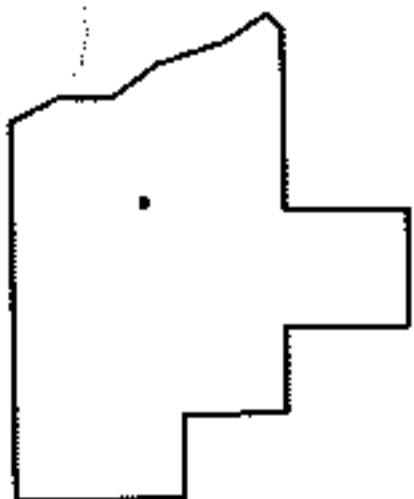

SPLITS/DEEDS PROCESSED

LORAIN COUNTY TAX MAP DEPARTMENT
226 MIDDLE AVE. ELYRIA, OHIO

SURVEYED BY: N/A

CLOSURE: N/A

MAP PAGE(S): 2-01-006-D

APPROVED BY: RRM DATE: 3-30-11

SCALE: 1"= 50' PRIOR INST.: DV 1306/420