
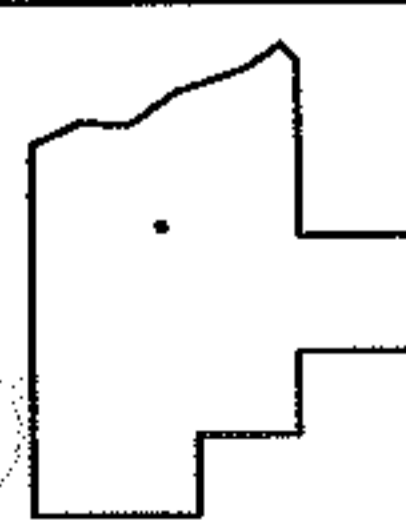
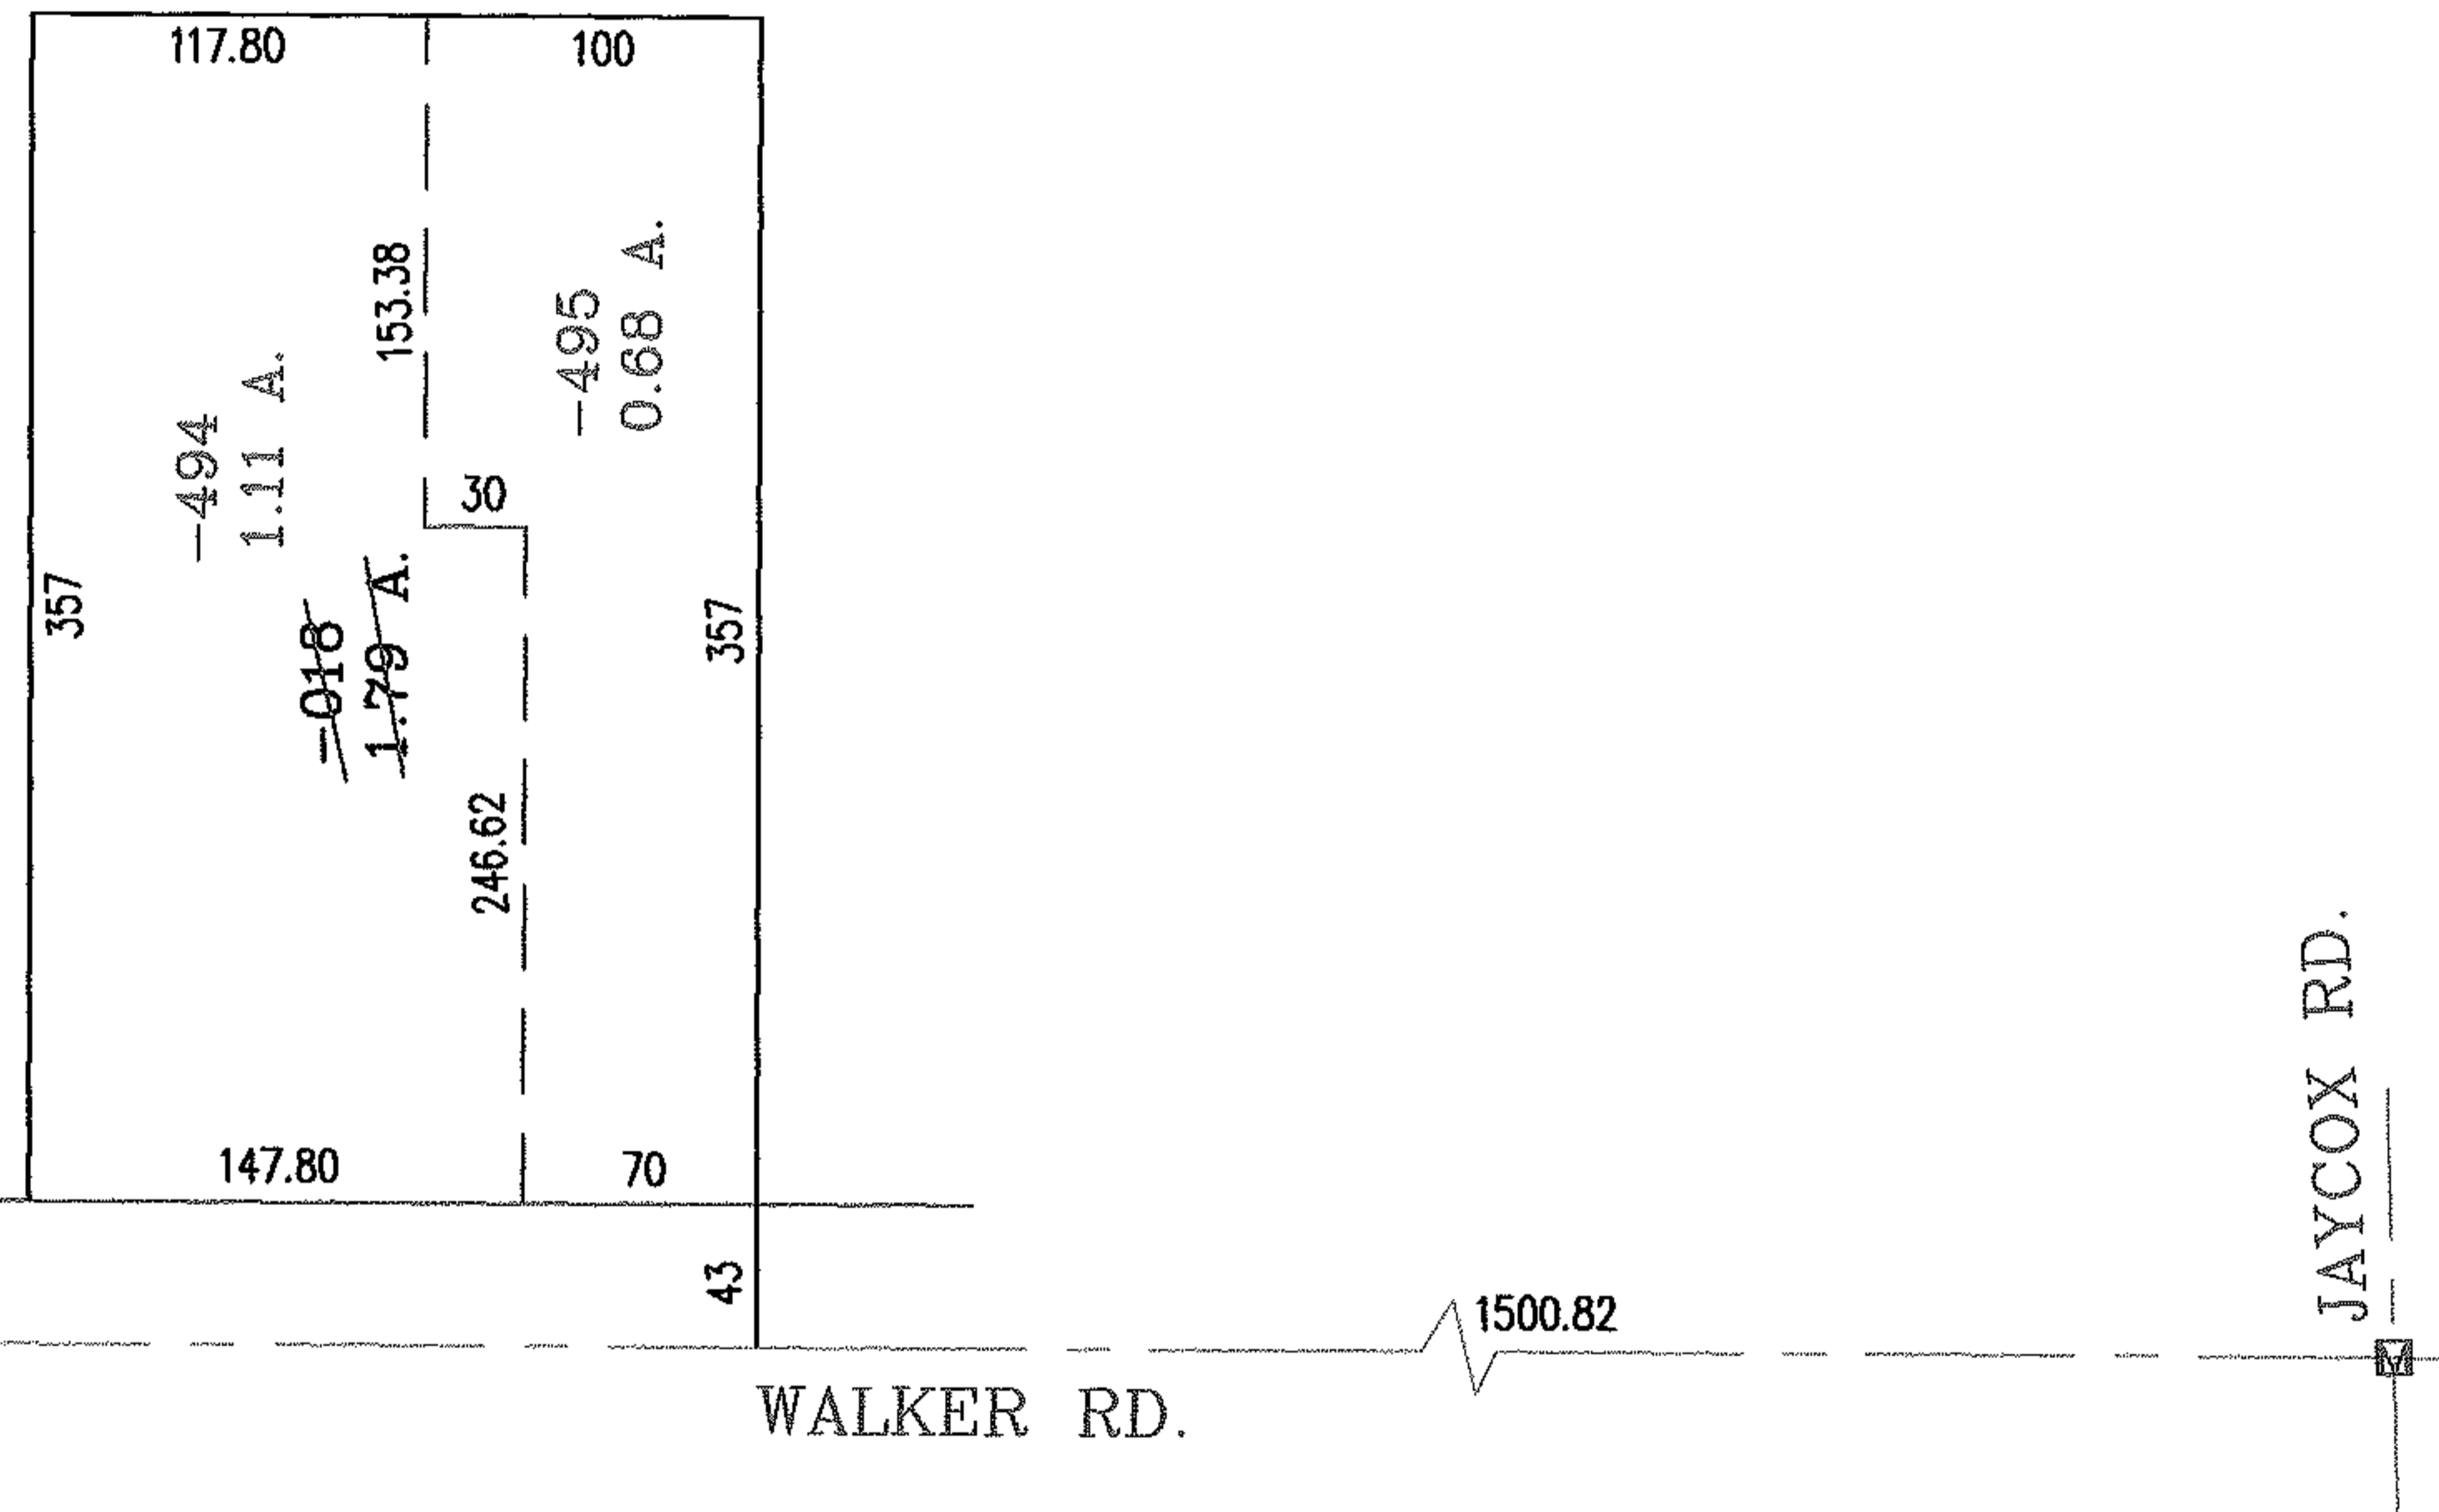


PARENT PARCEL: 04-00-019-143-018

CHILD PARCEL: 04-00-019-143-494,-495

STARTING POINT: MON BOX AT INTERSECTION OF C/L OF WALKER RD. AND C/L OF JAYCOX RD.

06-02243

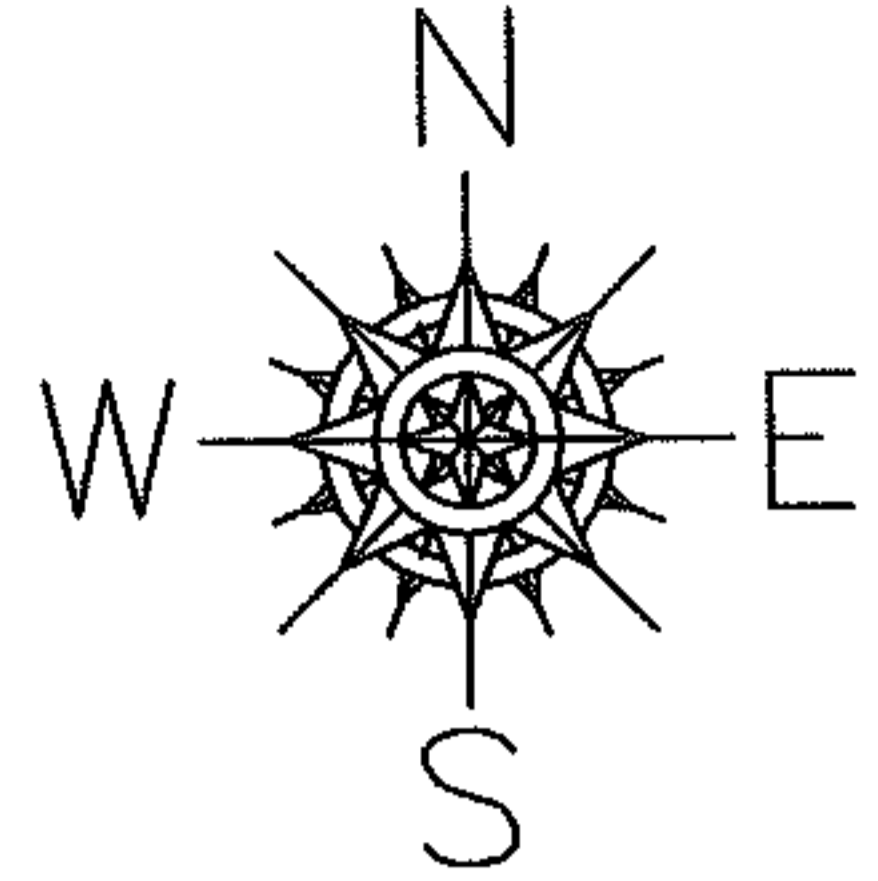

SPLITS/DEEDS PROCESSED

LORAIN COUNTY TAX MAP DEPARTMENT  
226 MIDDLE AVE. ELYRIA, OHIO

SURVEYED BY: JAMES T. SAYLER  
 CLOSURE: .00:10.000  
 MAP PAGE(S): 4-00-019-D  
 APPROVED BY: RRM DATE: 10-19-06  
 SCALE: 1"=100 PRIOR INSTRUMENT: 19970486233