

PARENT PARCEL: 01-00-002-107-072

CHILD PARCEL: 01-00-002-107-082 THRU -084

STARTING POINT: S/L DESCRIPTIONS

11-02244-U



UNCOMBIANTION

~~01-00-002-107-072~~  
~~82 X 97~~

S/L 1320 01-00-002-107-082  
35.00 X 97.00

PT. S/L 1321 01-00-002-107-083  
12.00 X 97.00

S/L 1319 01-00-002-107-084  
35.00 X 97.00

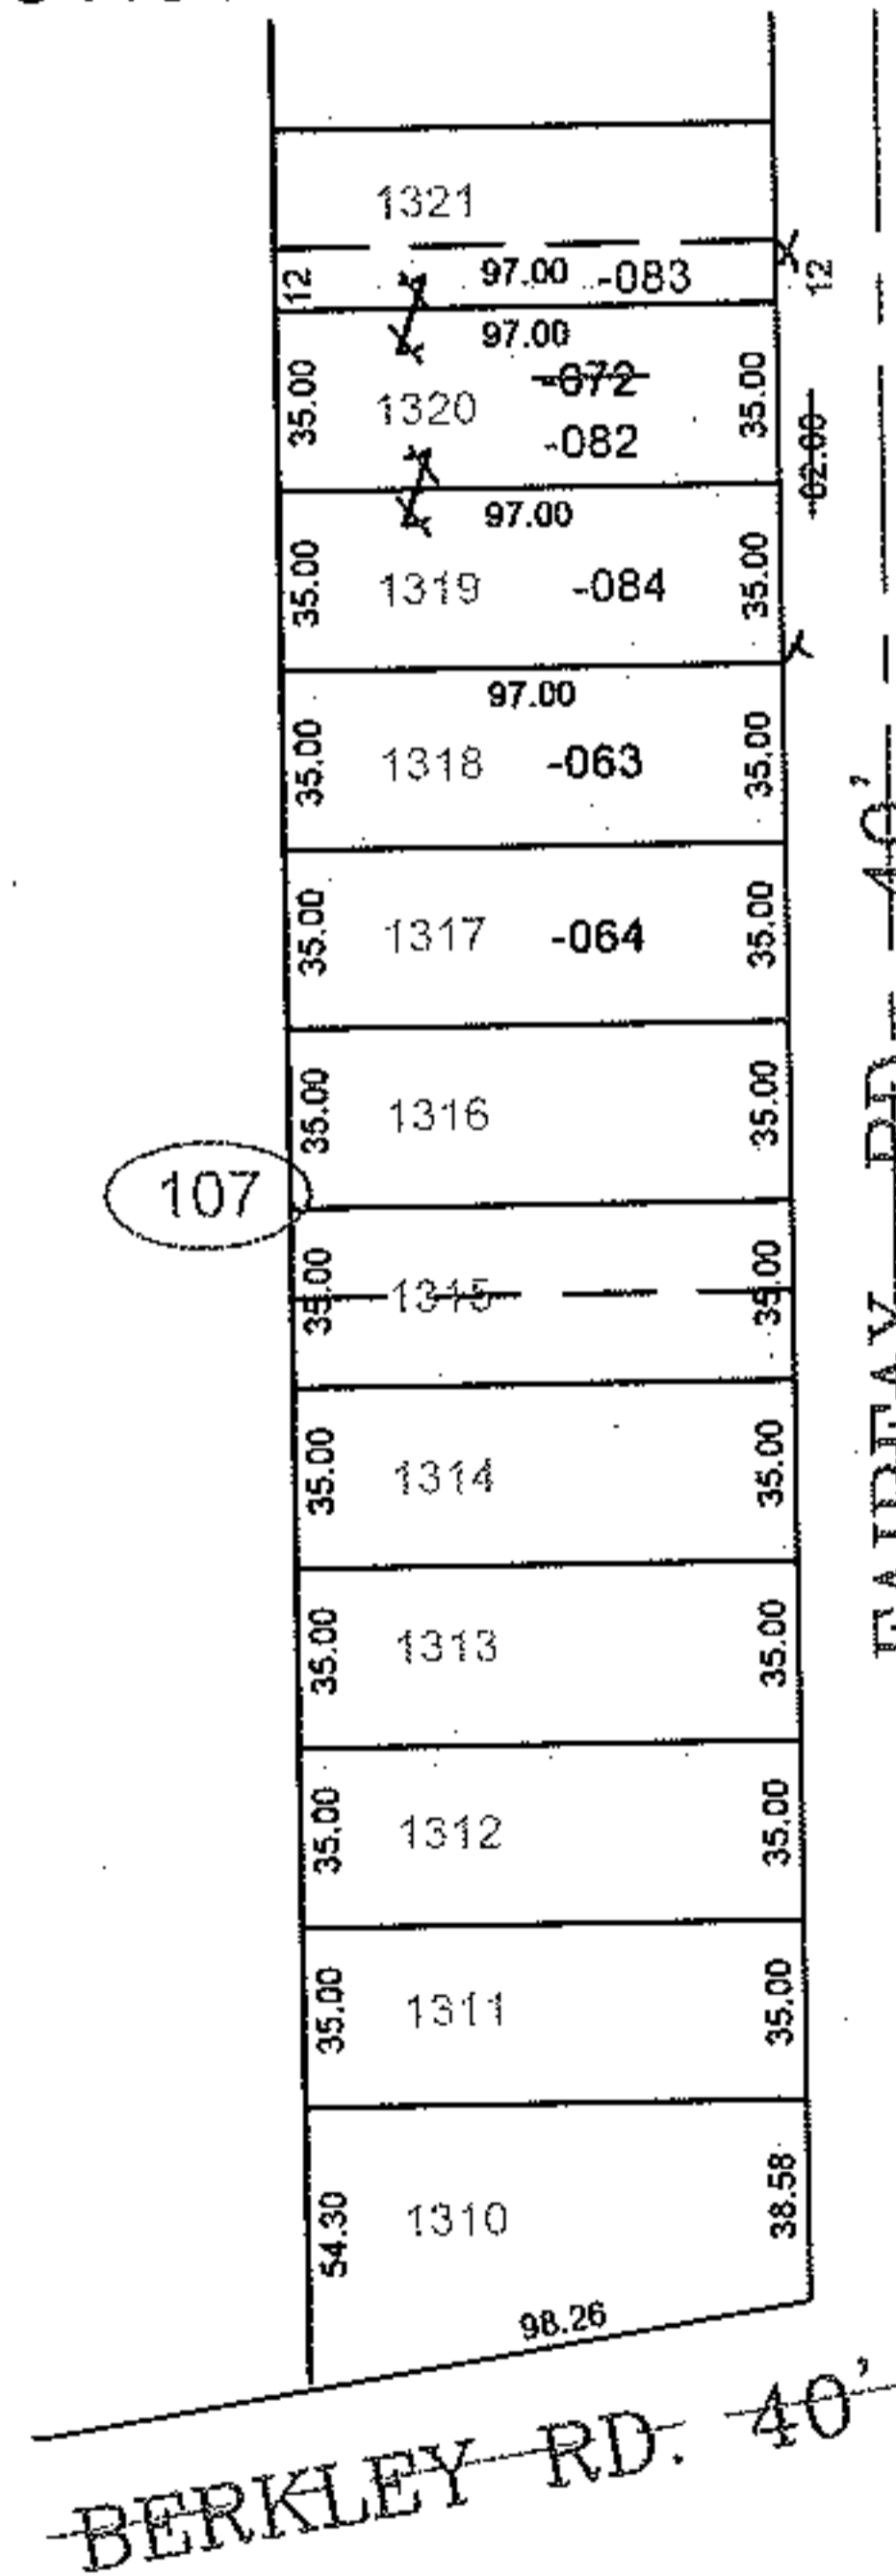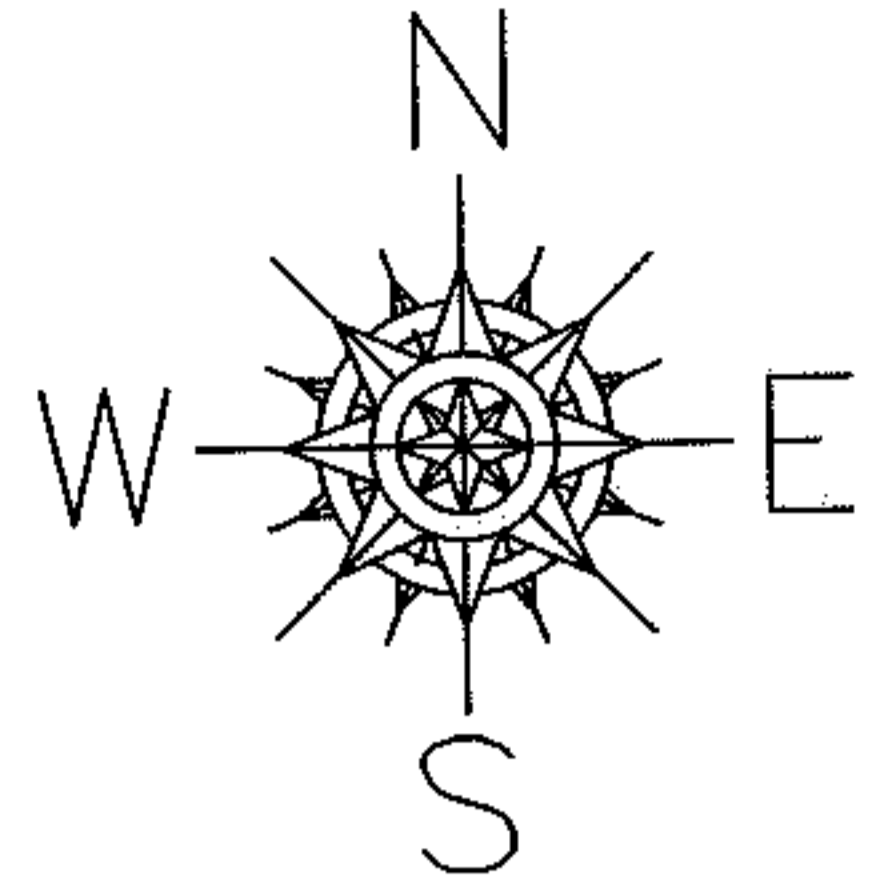

SPLITS/DEEDS PROCESSED

LORAIN COUNTY TAX MAP DEPARTMENT  
226 MIDDLE AVE. ELYRIA, OHIO

SURVEYED BY: NONE

CLOSURE: 0.00 : 10.000

MAP PAGE(S): 01-00-002-B

APPROVED BY: TJS DATE: 2/23/11

SCALE: 1"= 100 PRIOR INST.: 19960432713