
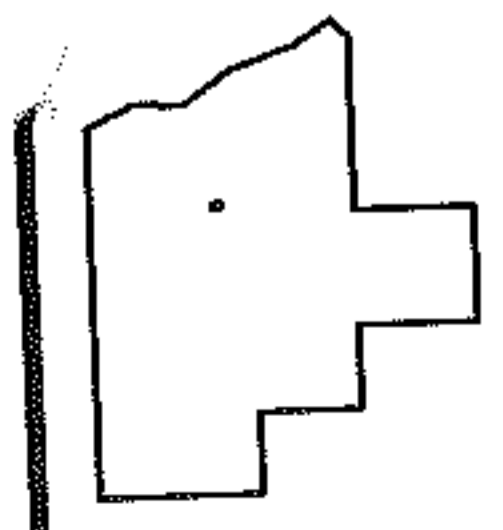
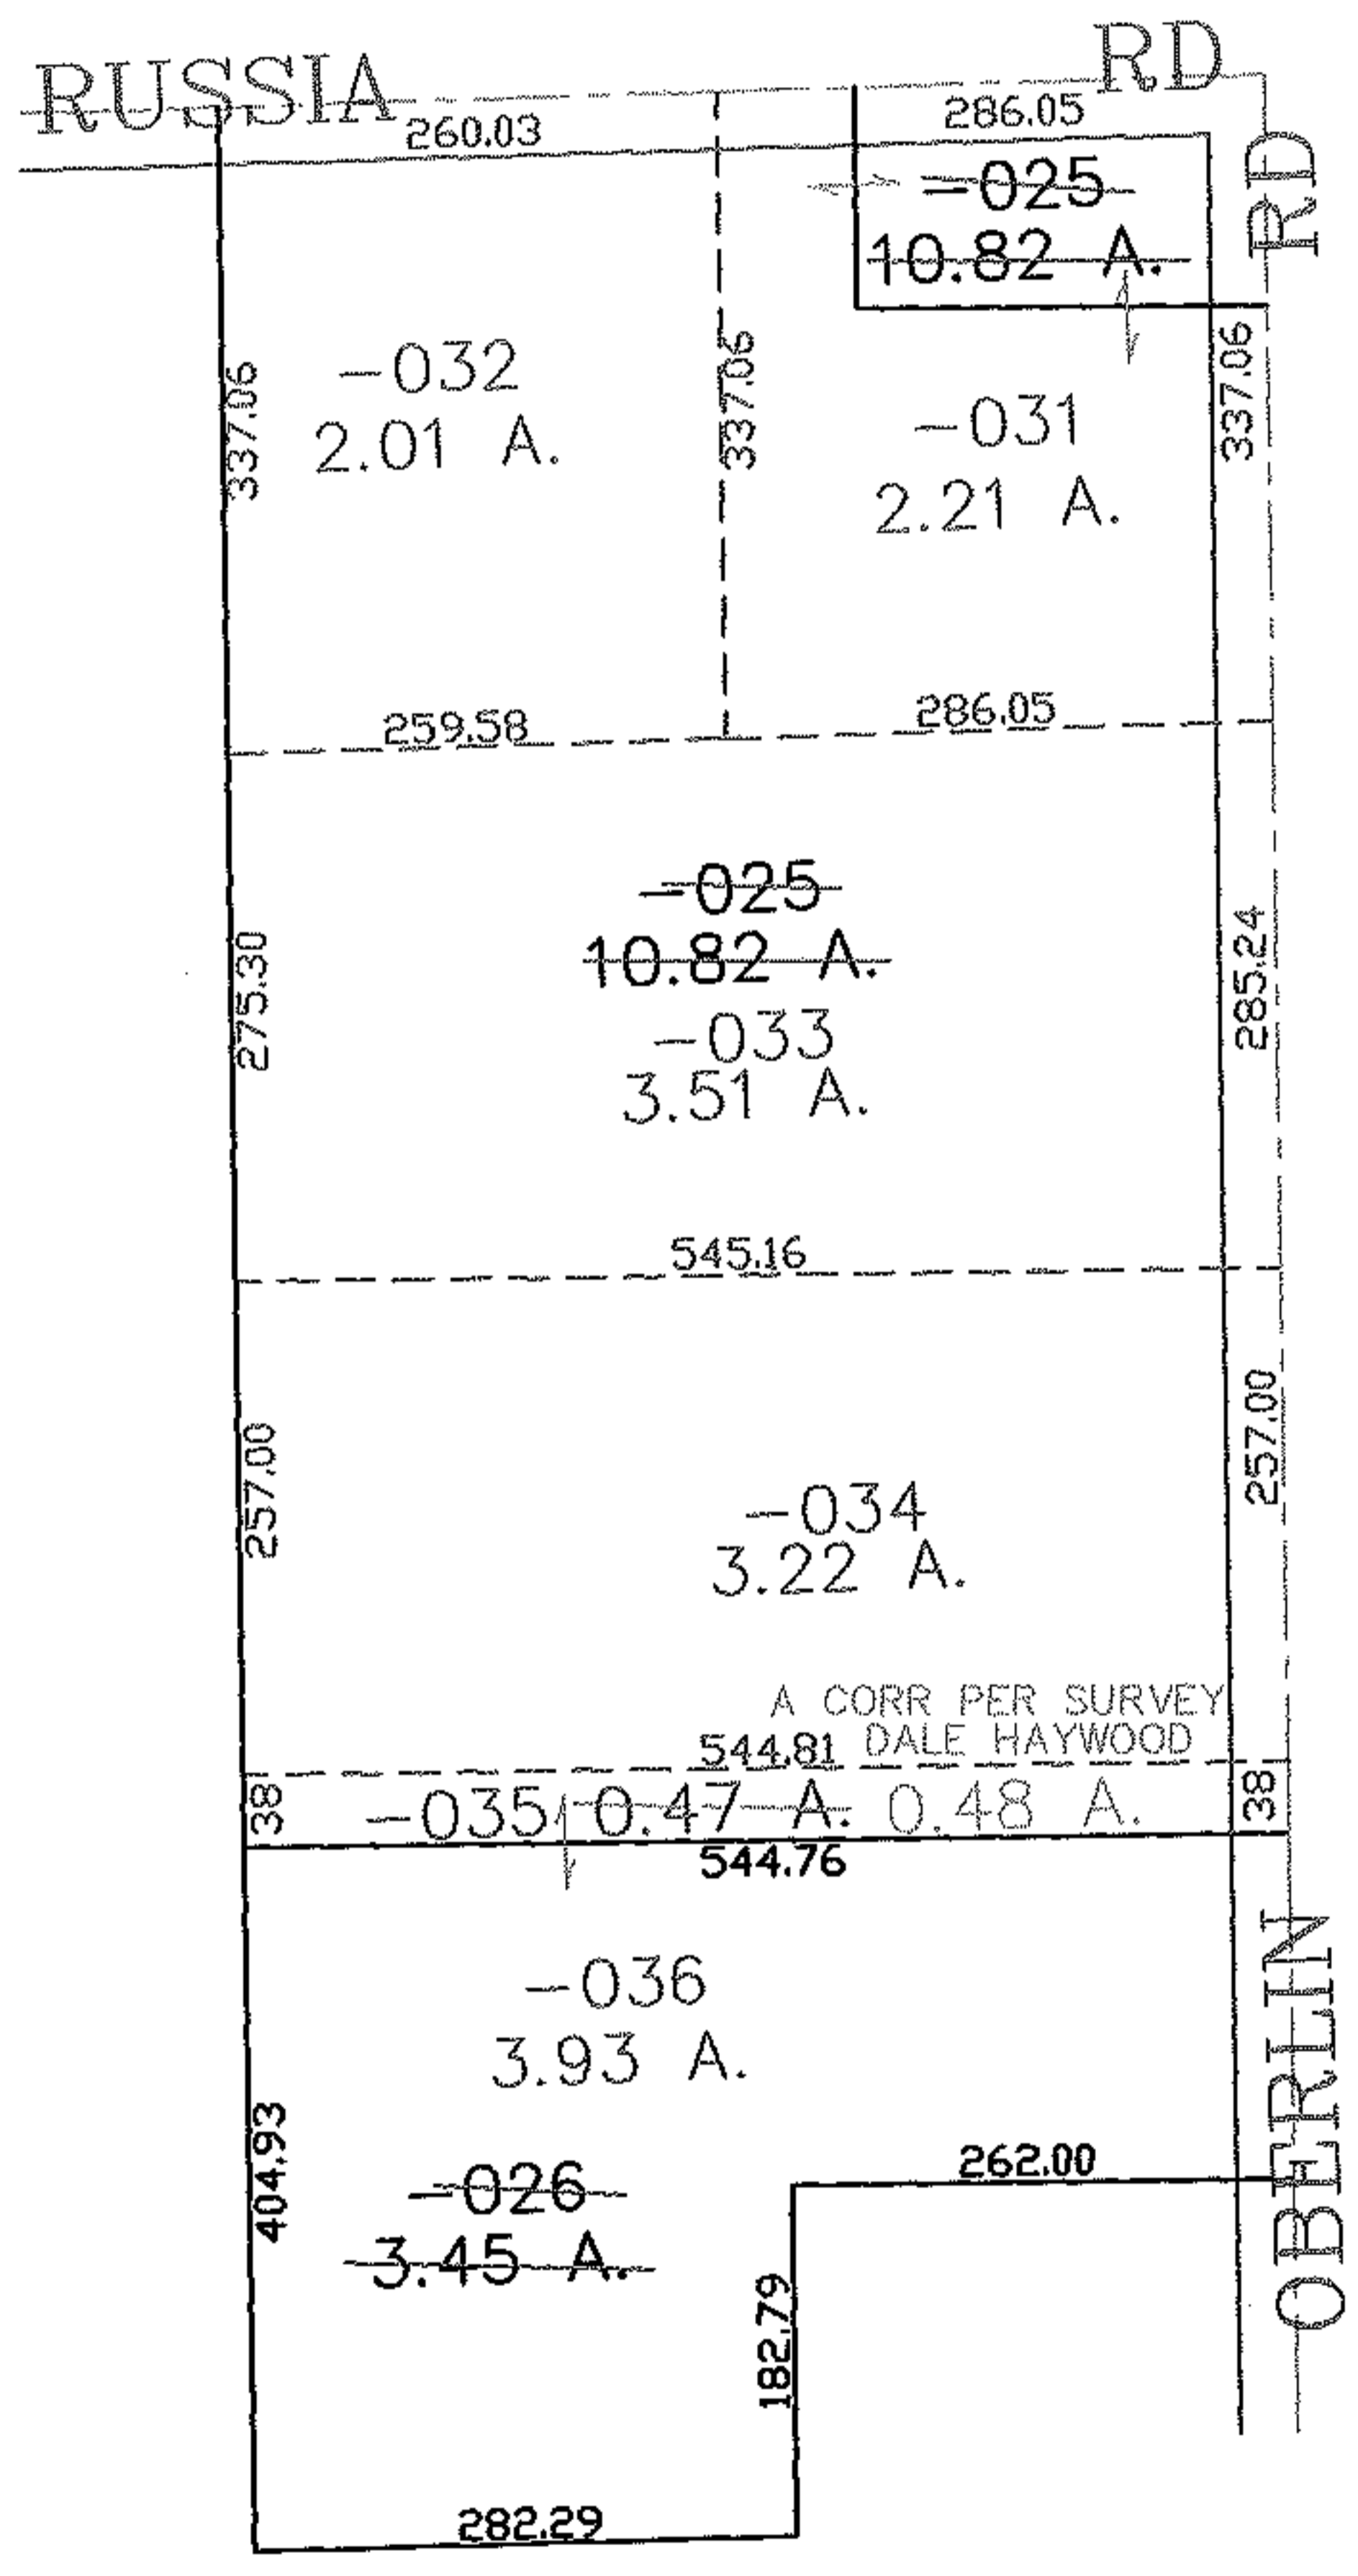


RASTER

PARENT PARCEL: 09-00-027-000-010, -025
CHILD PARCEL: 09-00-027-000-031 THRU -036
STARTING POINT: CENTERLINE OF RUSSIA RD & OBERLIN RD

06-02244

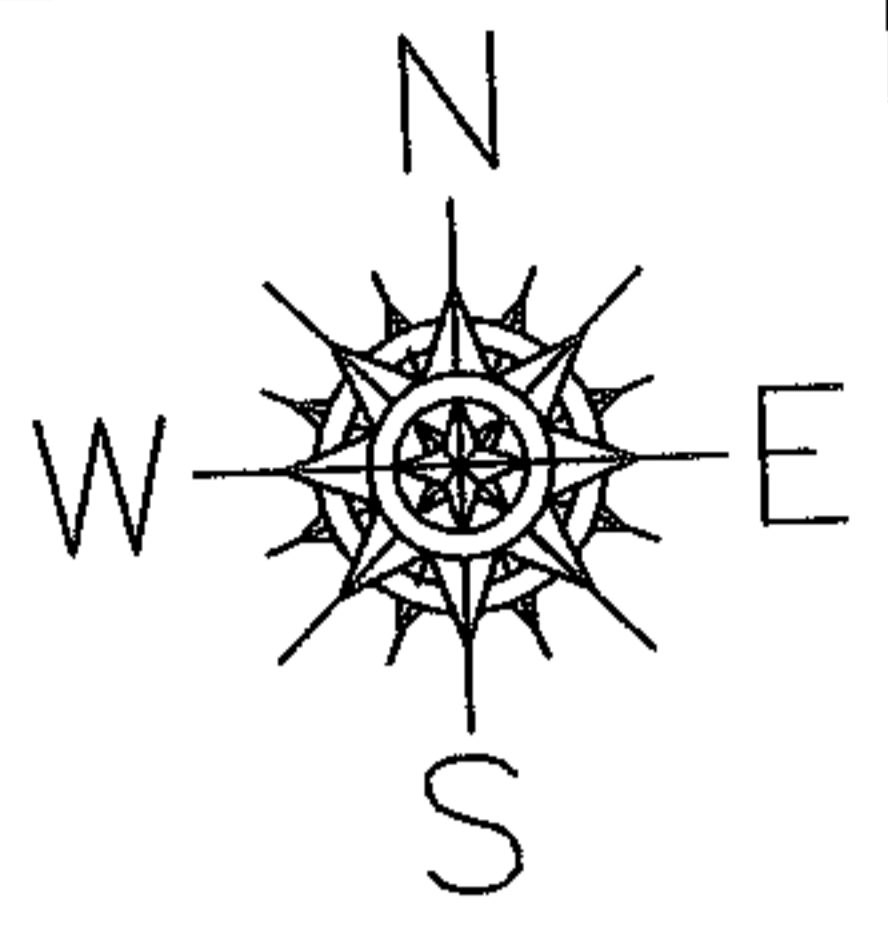

SPLITS/DEEDS PROCESSED
LORAIN COUNTY TAX MAP DEPARTMENT
226 MIDDLE AVE. ELYRIA, OHIO

SURVEYED BY: DALE HAYWOOD
CLOSURE: 0.00 : 10.000
MAP PAGE(S): 9-C
APPROVED BY: JAH DATE: 10-19-06
SCALE: 1" = 200' PRIOR INSTRUMENT: DV 1402/920