

PARENT PARCEL: 01-00-064-000-057

CHILD PARCEL: SAME

STARTING POINT: CENTERLINE OF NORTH RIDGE RD & O.L. 64

11-02245-A

NORTH RIDGE RD

437.43

O.L. 64

150.00

~~1.50~~ A.

1.51 A.


A CORR SURVEY

477.17

JOHN BURKIN

477.17

150.00

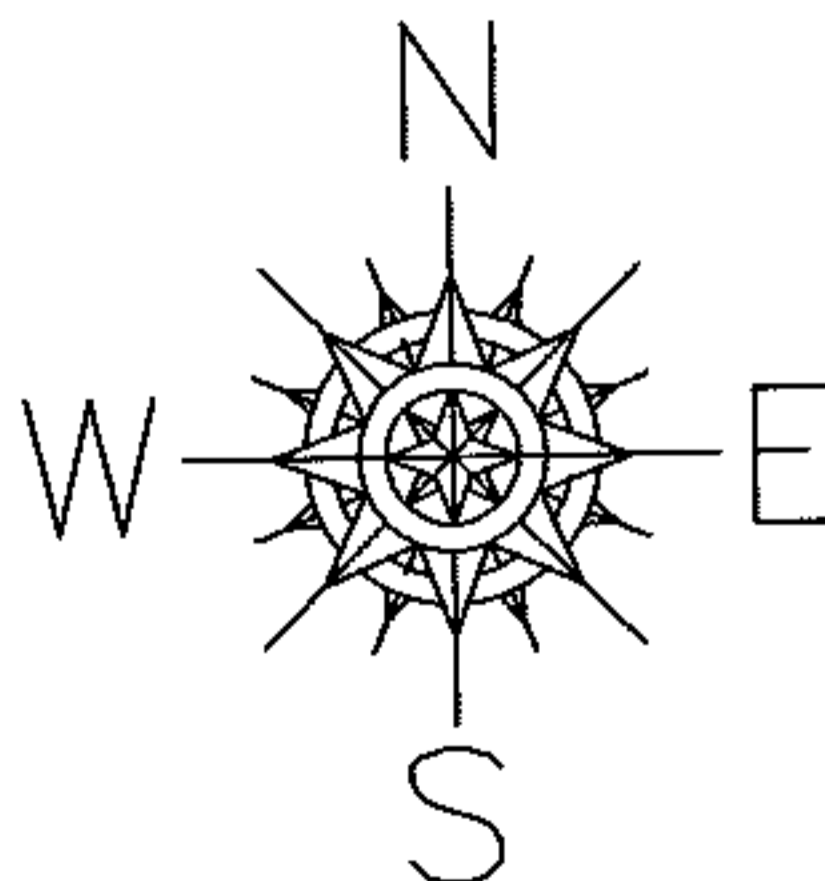

SPLITS/DEEDS PROCESSED

LORAIN COUNTY TAX MAP DEPARTMENT
226 MIDDLE AVE. ELYRIA, OHIO

SURVEYED BY: JOHN BURKIN

CLOSURE: 0.00 : 10,000

MAP PAGE(S): 1-1

APPROVED BY: JAH DATE: 2/28/2011

SCALE: 1" = 100 PRIOR INSTRUMENT: OR 826/898