
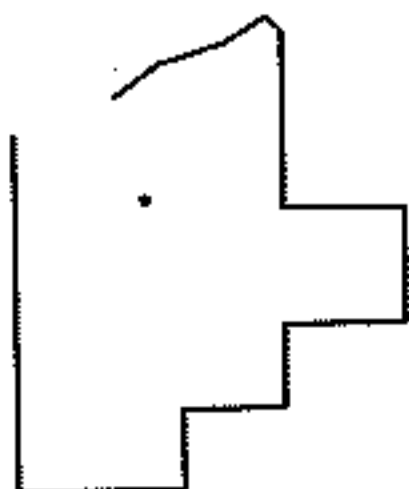
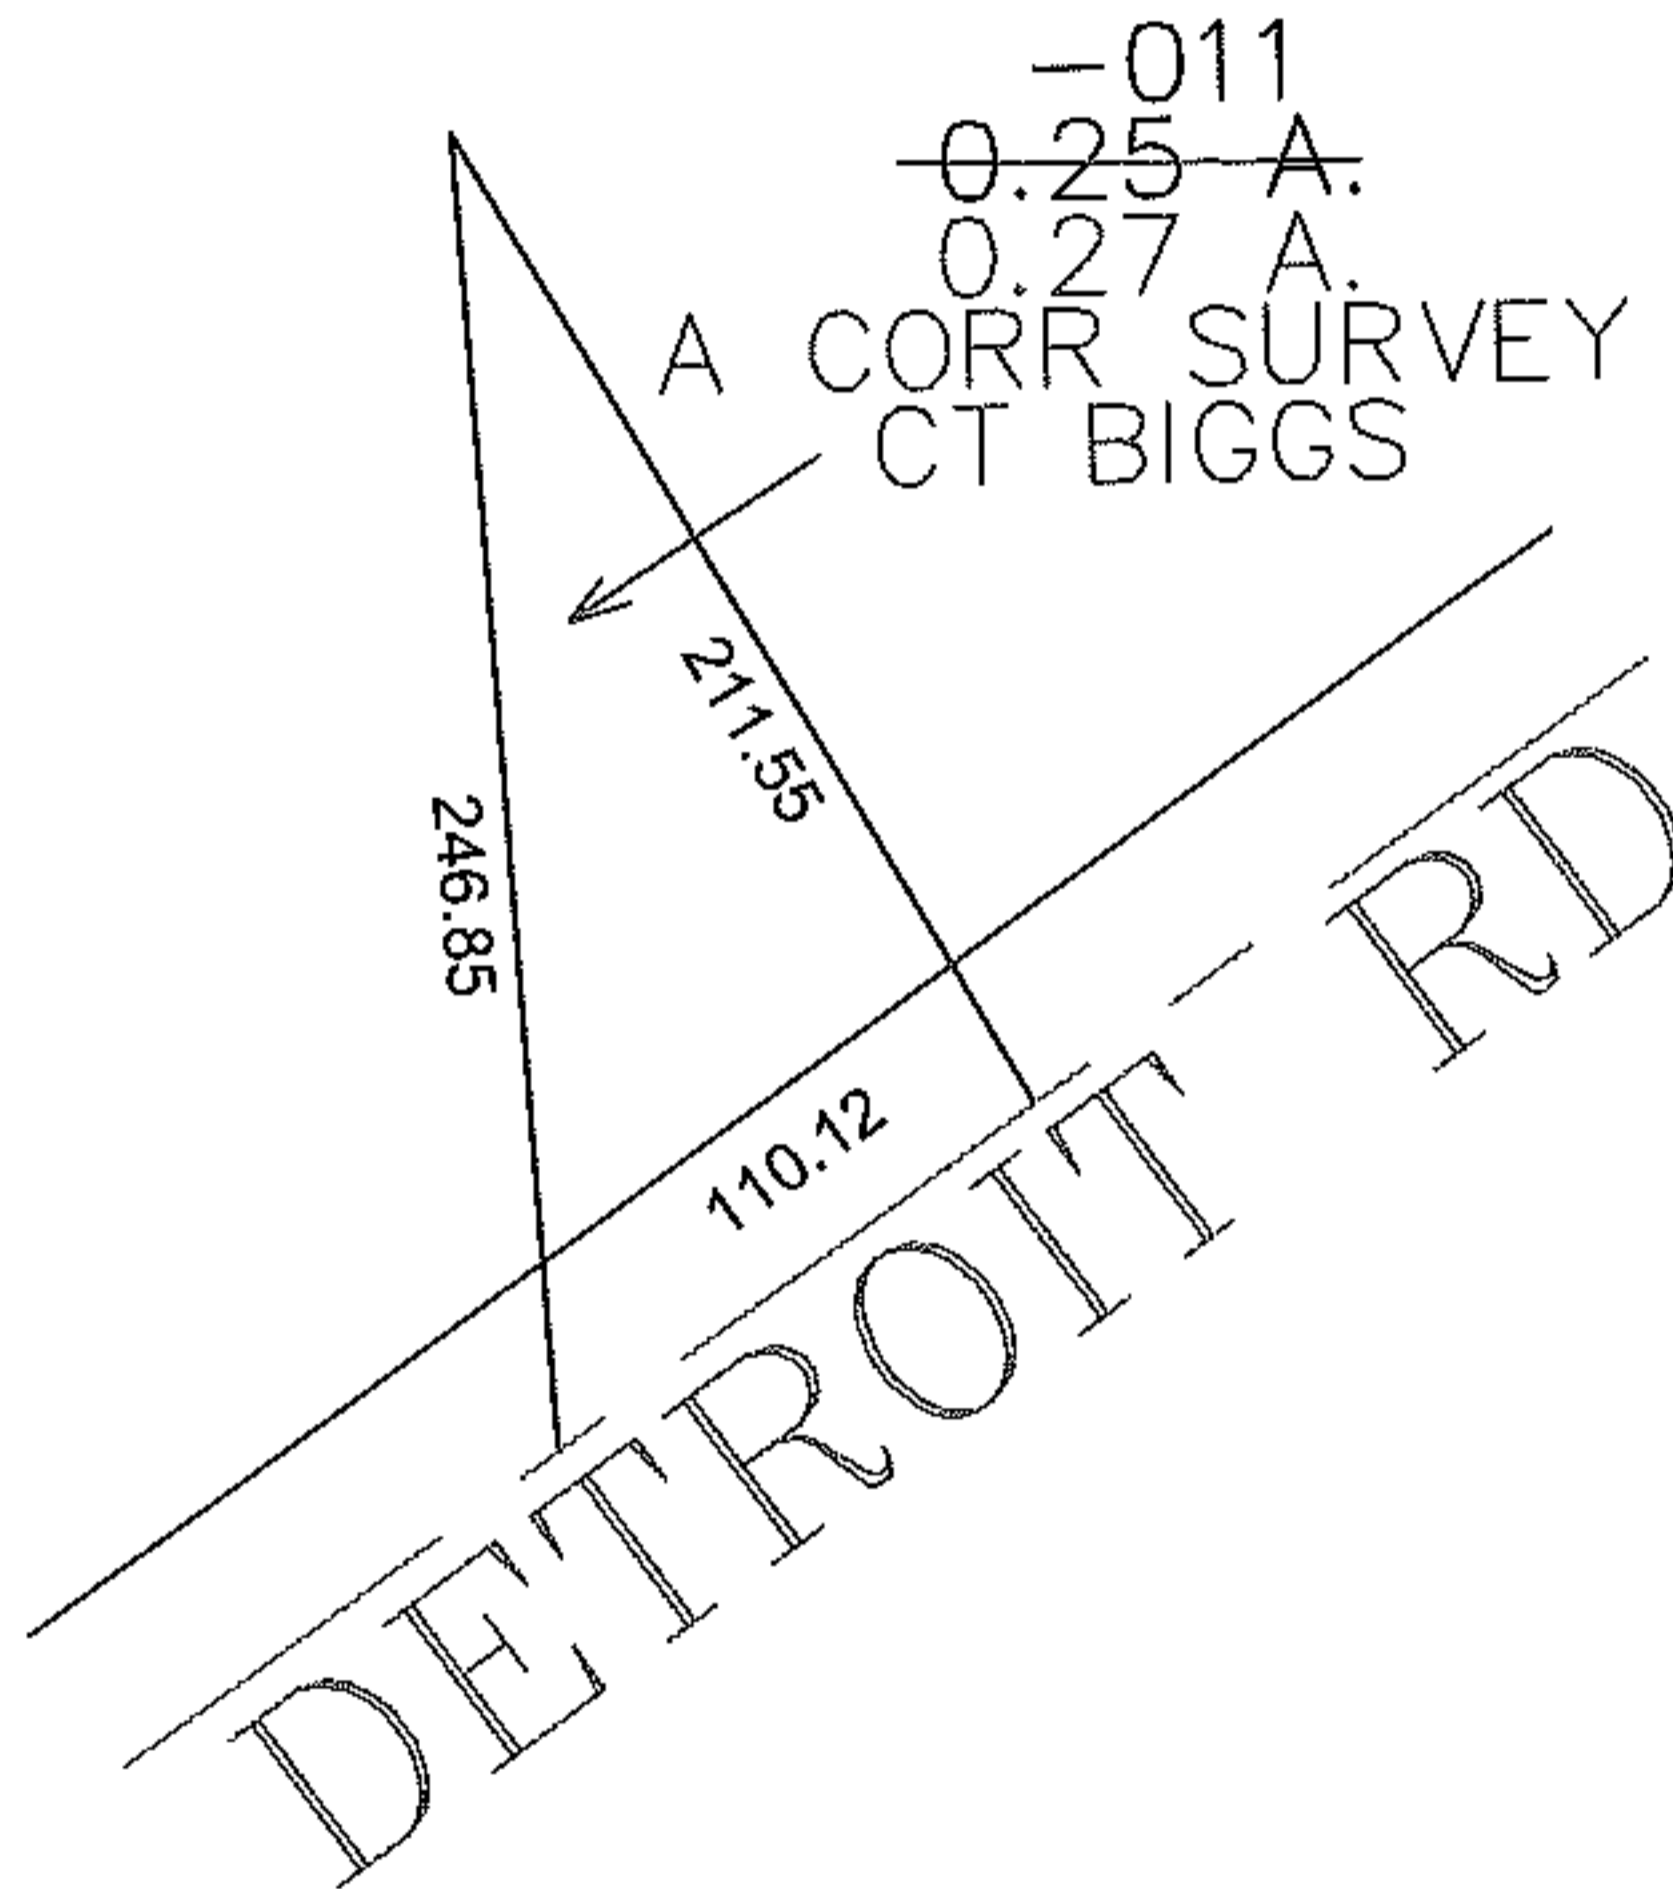


PARENT PARCEL: 04-00-001-101-011

CHILD PARCEL: SAME

STARTING POINT: DETROIT RD

11-02246-A

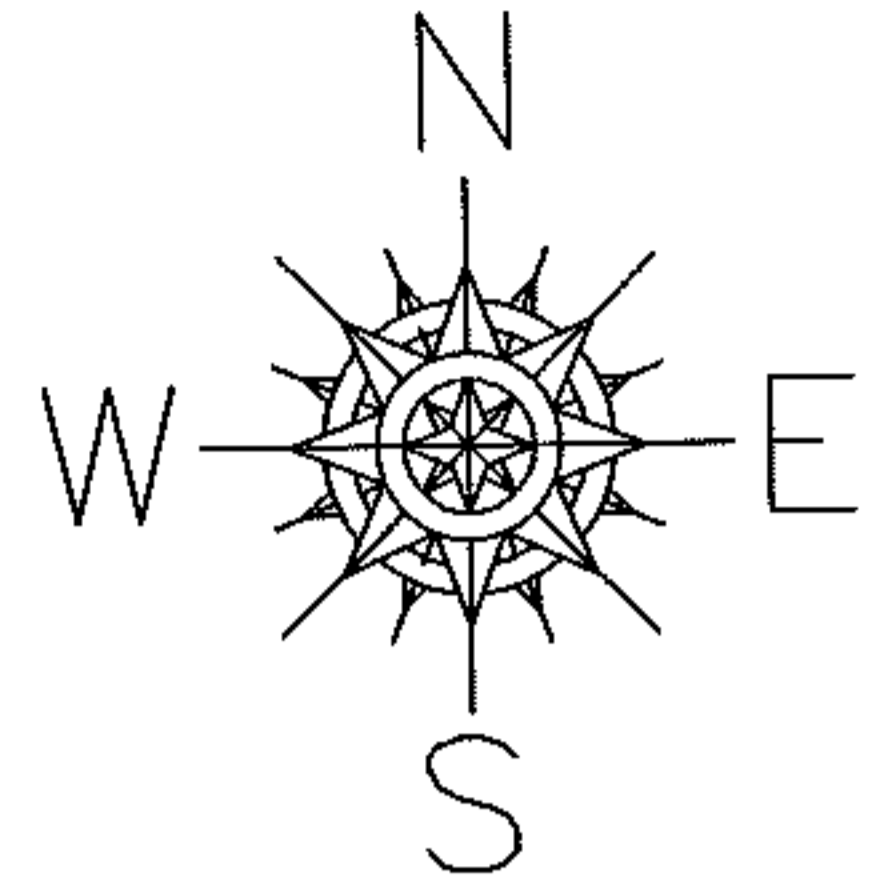

SPLITS/DEEDS PROCESSED

LORAIN COUNTY TAX MAP DEPARTMENT
226 MIDDLE AVE. ELYRIA, OHIO

SURVEYED BY: CT BIGGS

CLOSURE: 0.01 : 10.000

MAP PAGE(S): 04-00-001-B

APPROVED BY: JAH DATE: 2/28/2011

SCALE: 1" = 100 PRIOR INSTRUMENT: DV 371/457