
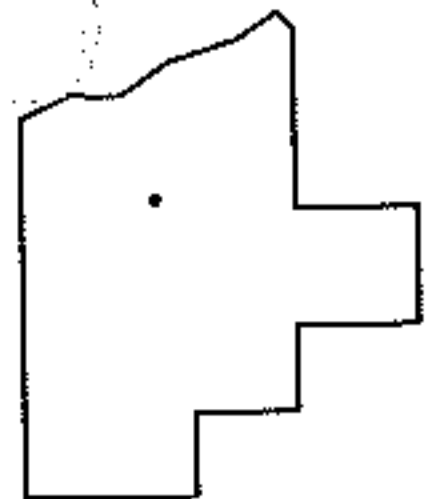
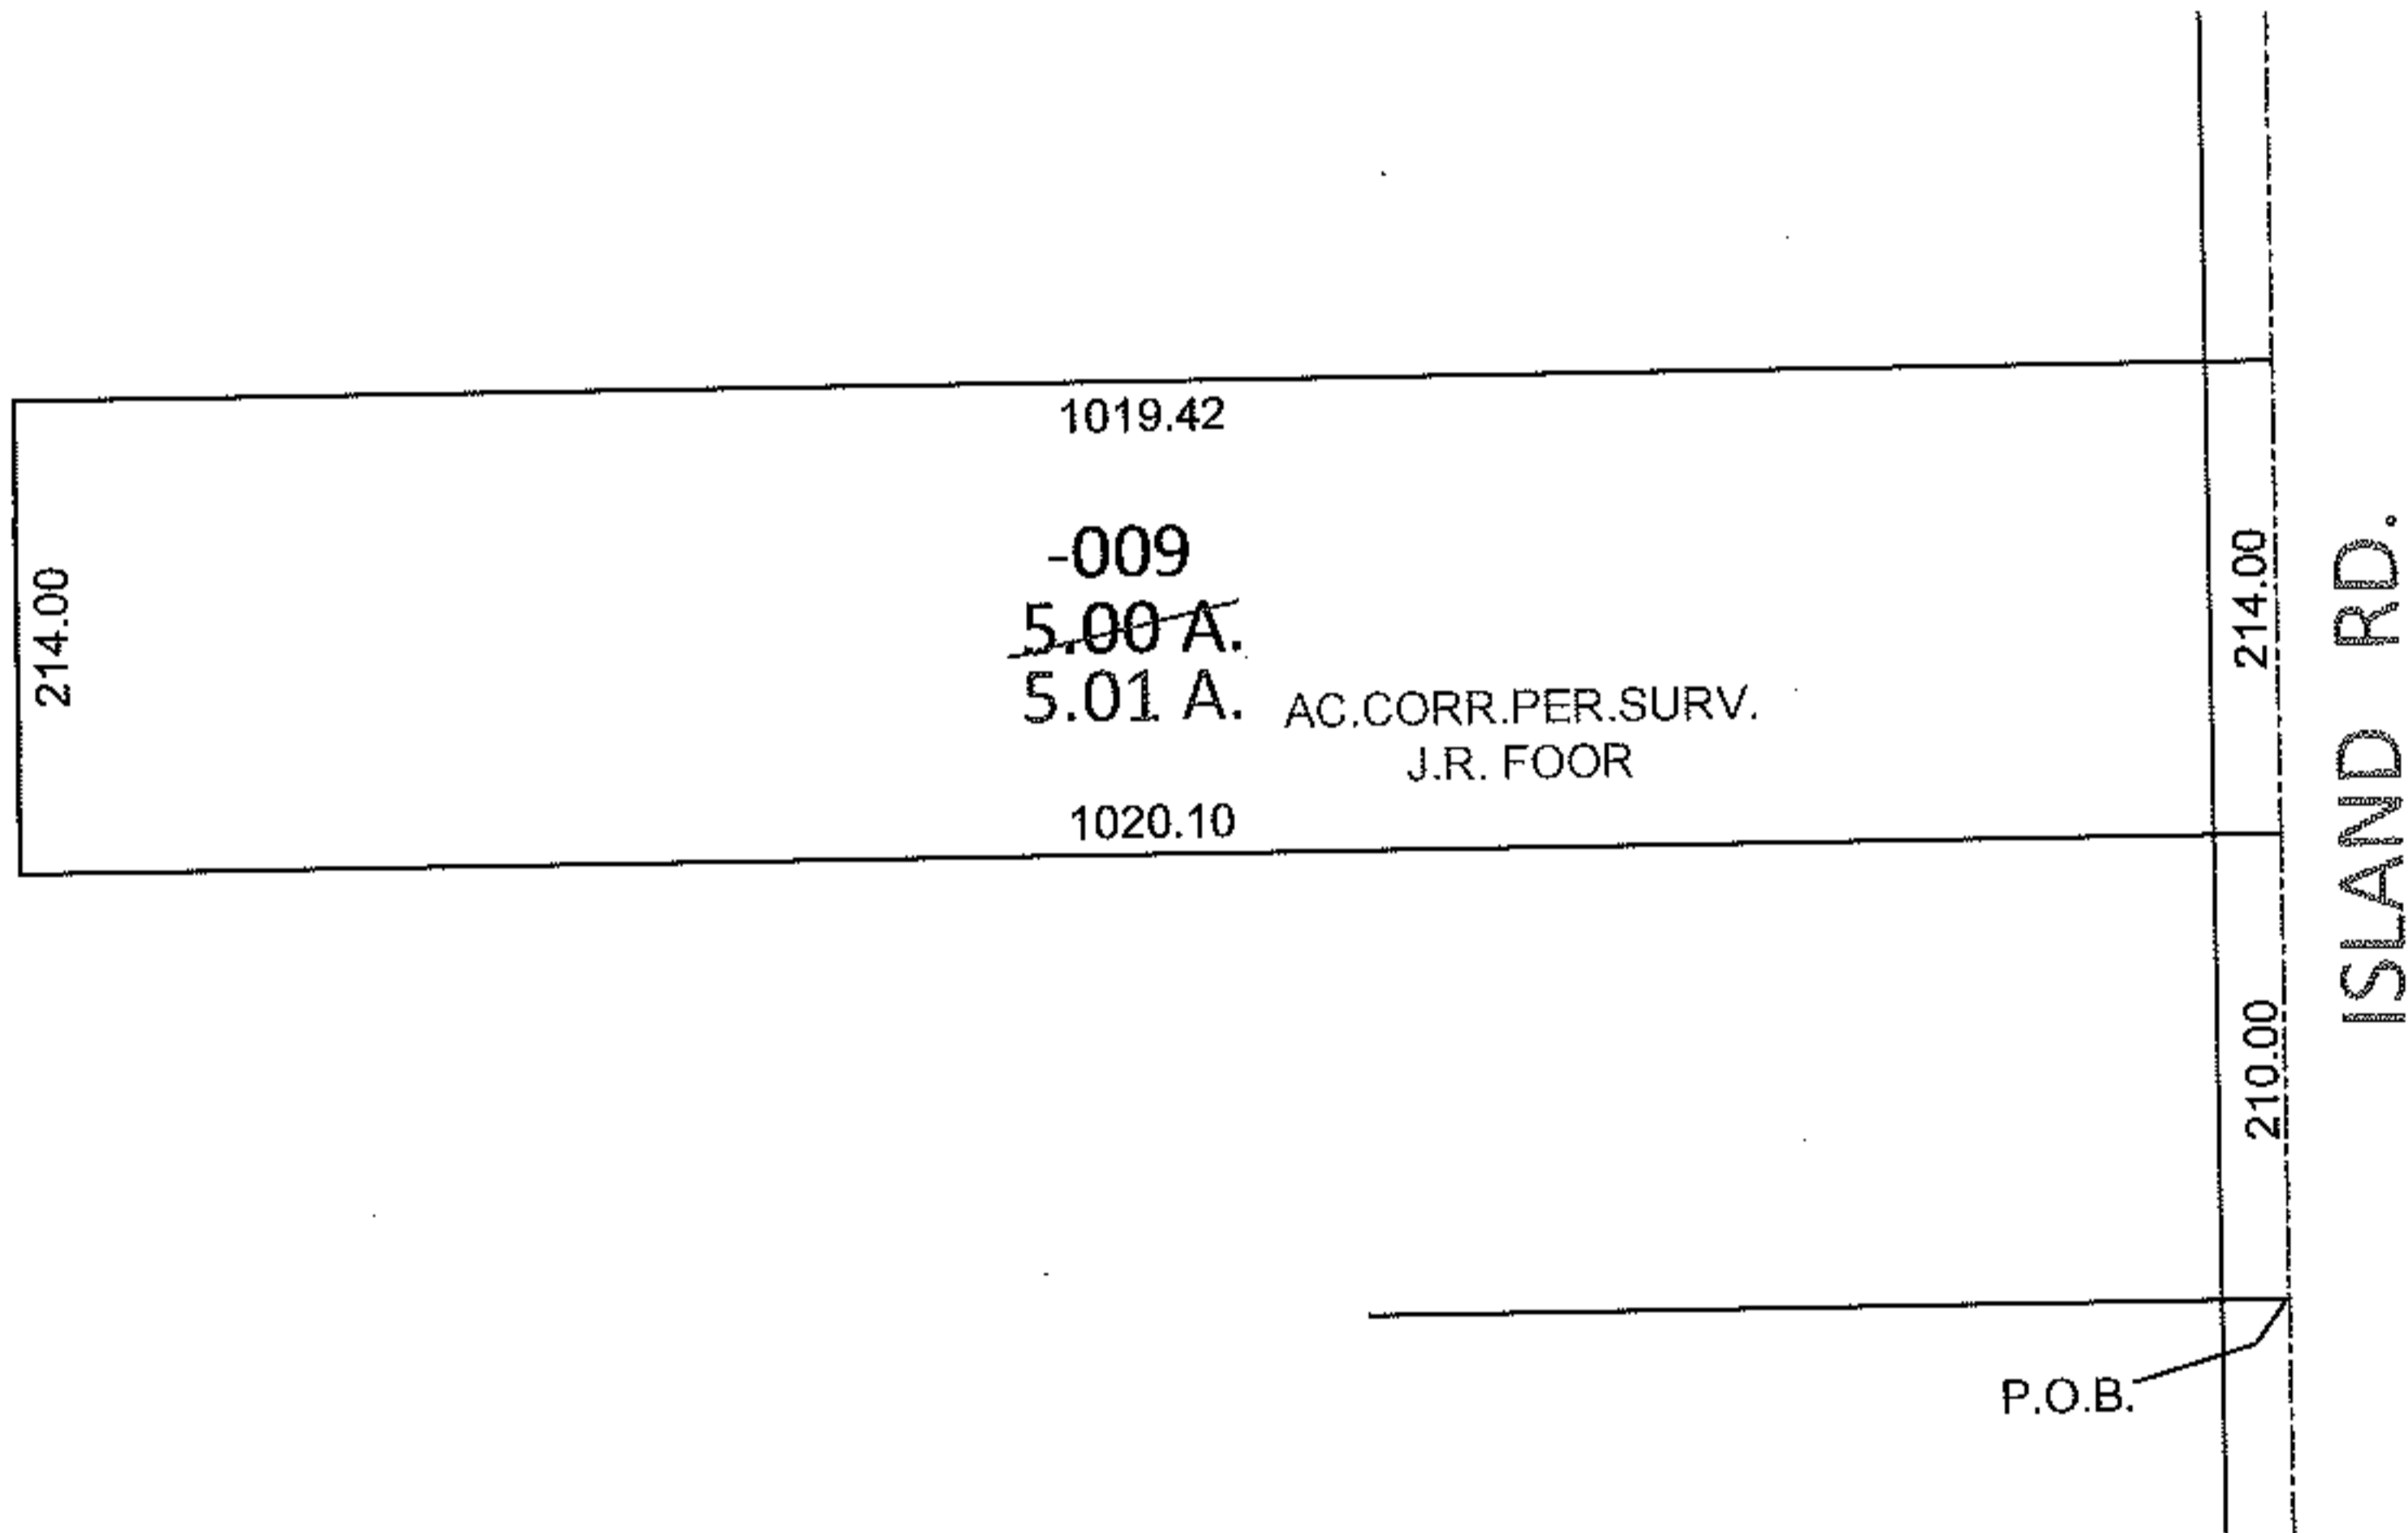


PARENT PARCEL: 16-00-034-000-009

11-02248-A

CHILD PARCEL: _____

STARTING POINT: NORTHEAST CORNER OF LAND CONVEYED TO PAUL N. & MARY T. DIOSY(DV 588/611)

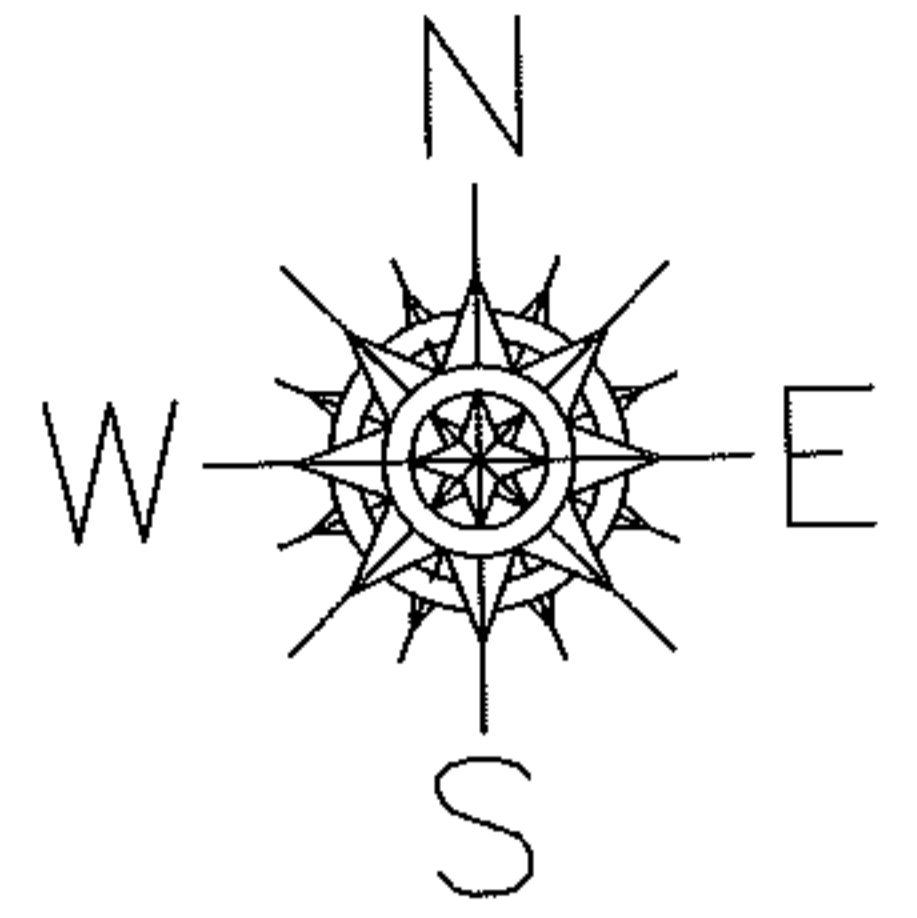

SPLITS/DEEDS PROCESSED

LORAIN COUNTY TAX MAP DEPARTMENT
226 MIDDLE AVE. ELYRIA, OHIO

SURVEYED BY:	J.R. FOOR
CLOSURE:	.01:10,000
MAP PAGE(S):	16-C
APPROVED BY:	RRM DATE: 4-1-11
SCALE:	1" = 200 PRIOR INST.: 20060119855