
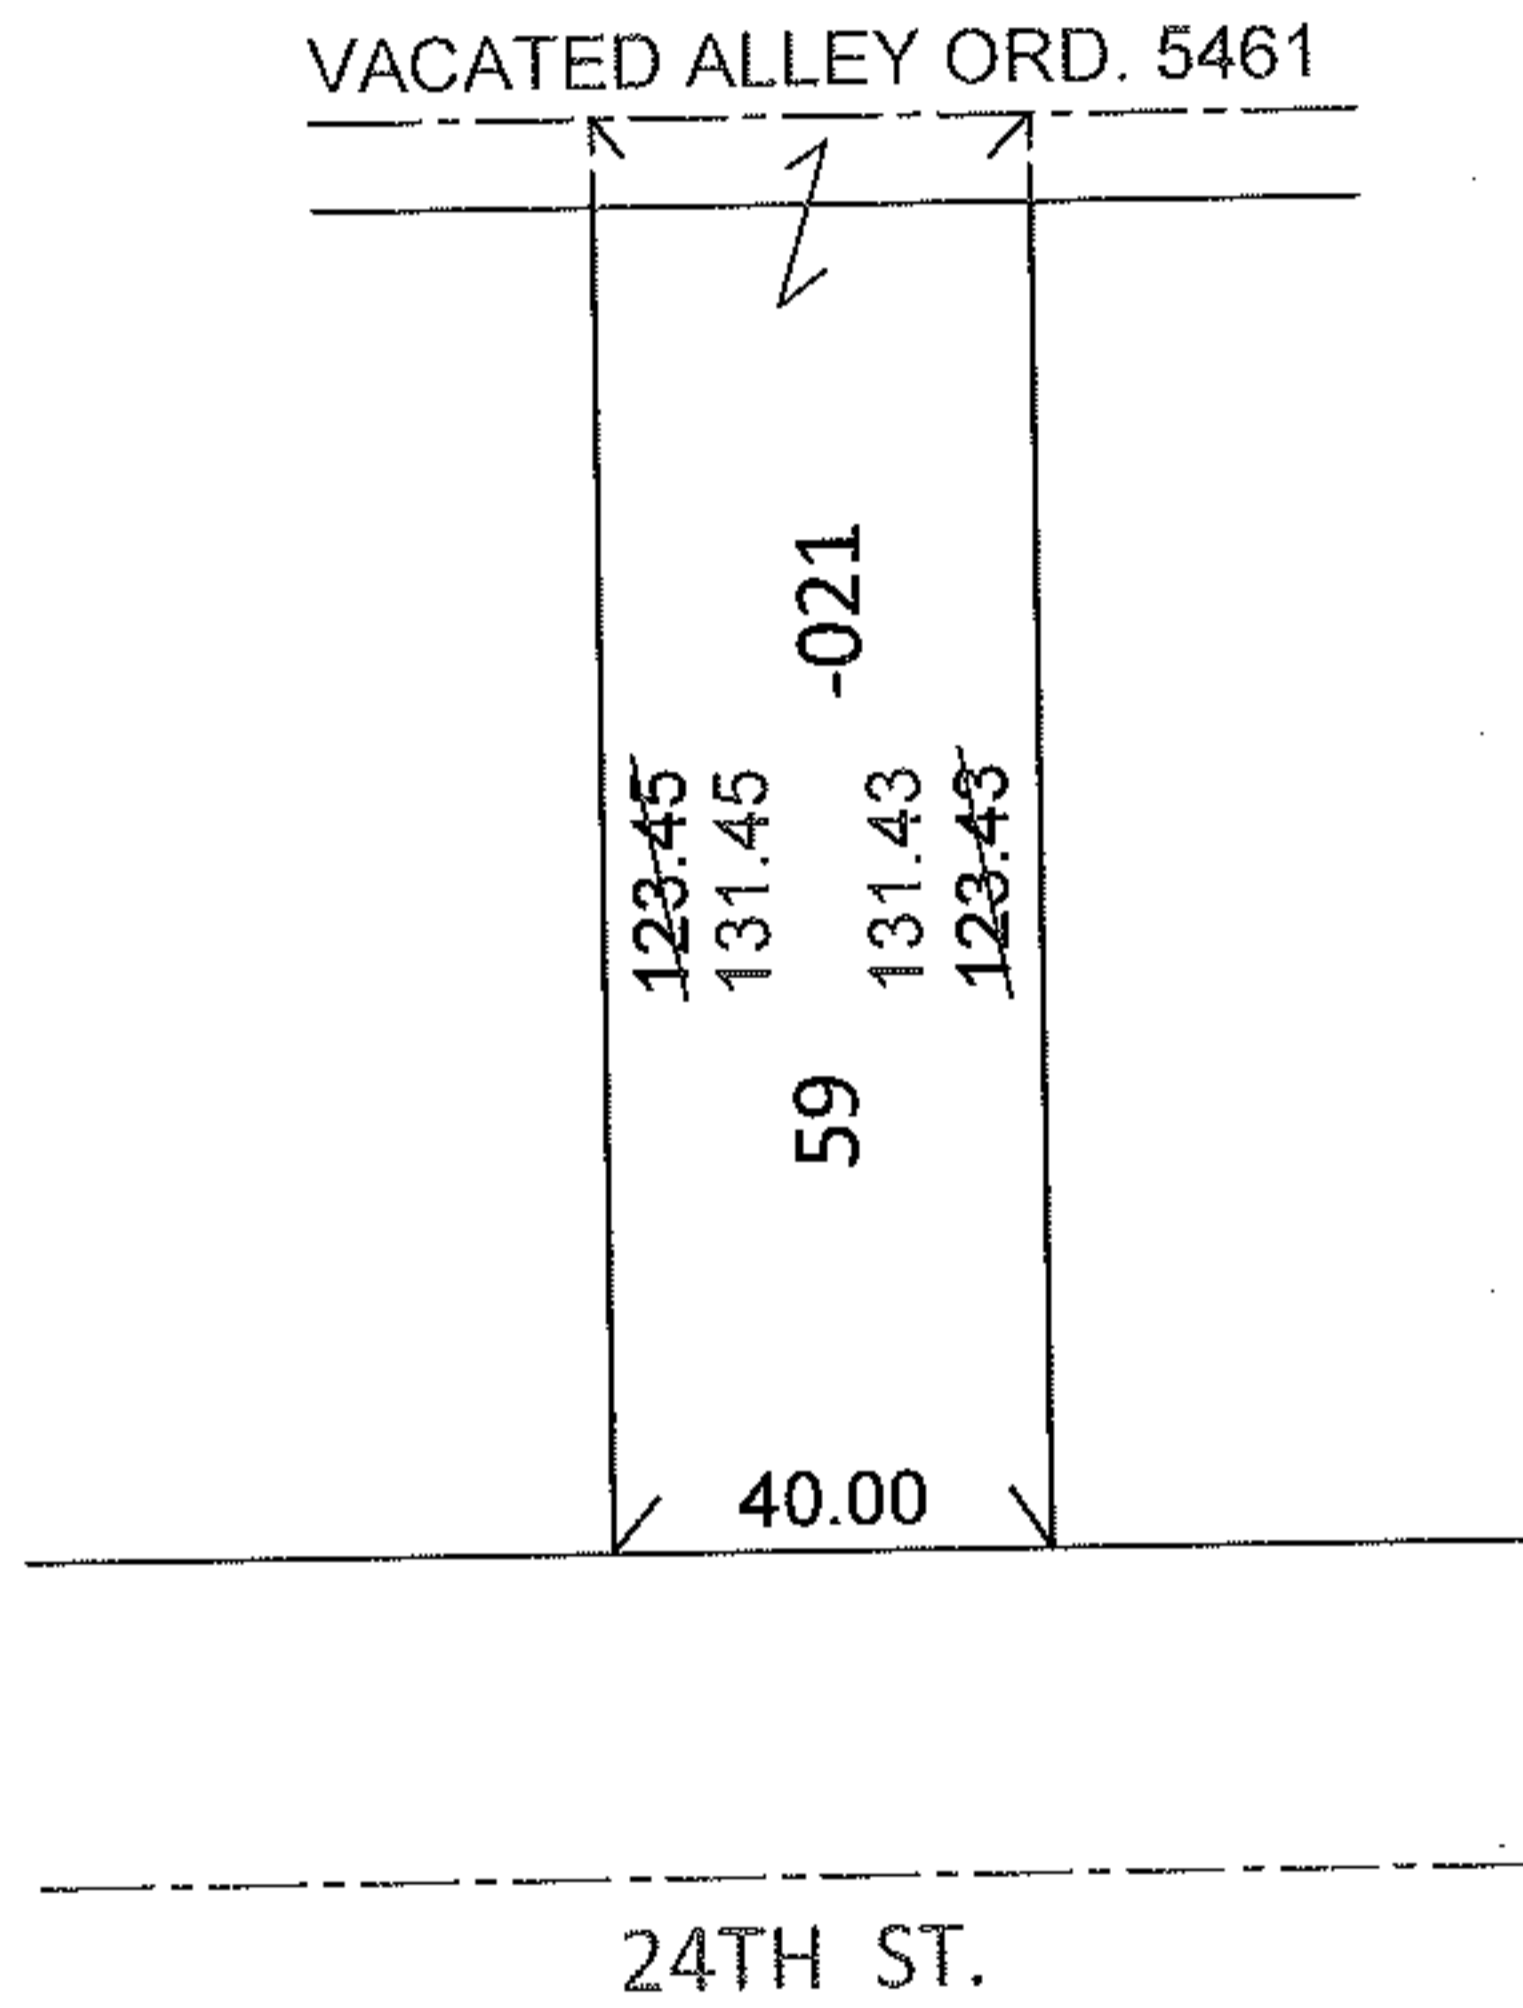


PARENT PARCEL: 02-02-016-106-021

CHILD PARCEL: _____

STARTING POINT: S/L 59 IN OBERLIN AVE REALTY CO.'S SUB. (VOL.8 PG.32)

11-02249-C

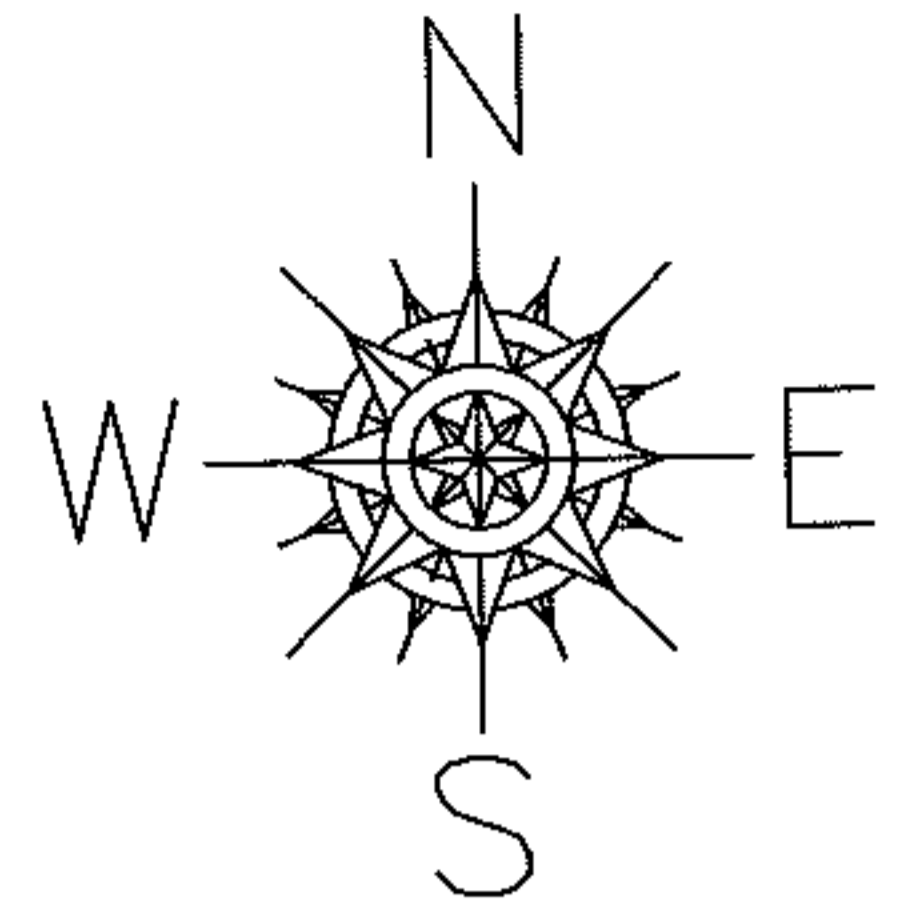


DEPTH CORRECTION

02-02-016-106-021

131.45

40 X ~~123~~

PER DEED AND VAC. ORD. 5461

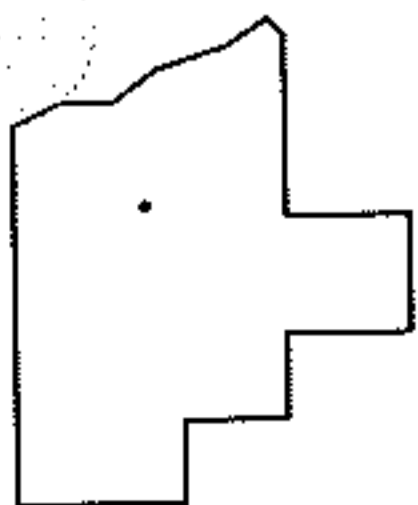

SPLITS/DEEDS PROCESSED

LORAIN COUNTY TAX MAP DEPARTMENT
226 MIDDLE AVE. ELYRIA, OHIO

SURVEYED BY: N/A

CLOSURE: N/A

MAP PAGE(S): 2-02-016-B

APPROVED BY: RRM DATE: 4-5-11

SCALE: 1"= 50' PRIOR INST.: 19990659174