

PARENT PARCEL: 18-00-022-103-013

CHILD PARCEL: XX-XX-XXX-XXX-XXX

STARTING POINT: BOUNDS DESCRIPTION

11-02251-C



FRONTAGE CORRECTION

18-00-022-103-013

~~101 X 165~~

99 X 165

CORR. PER DEED

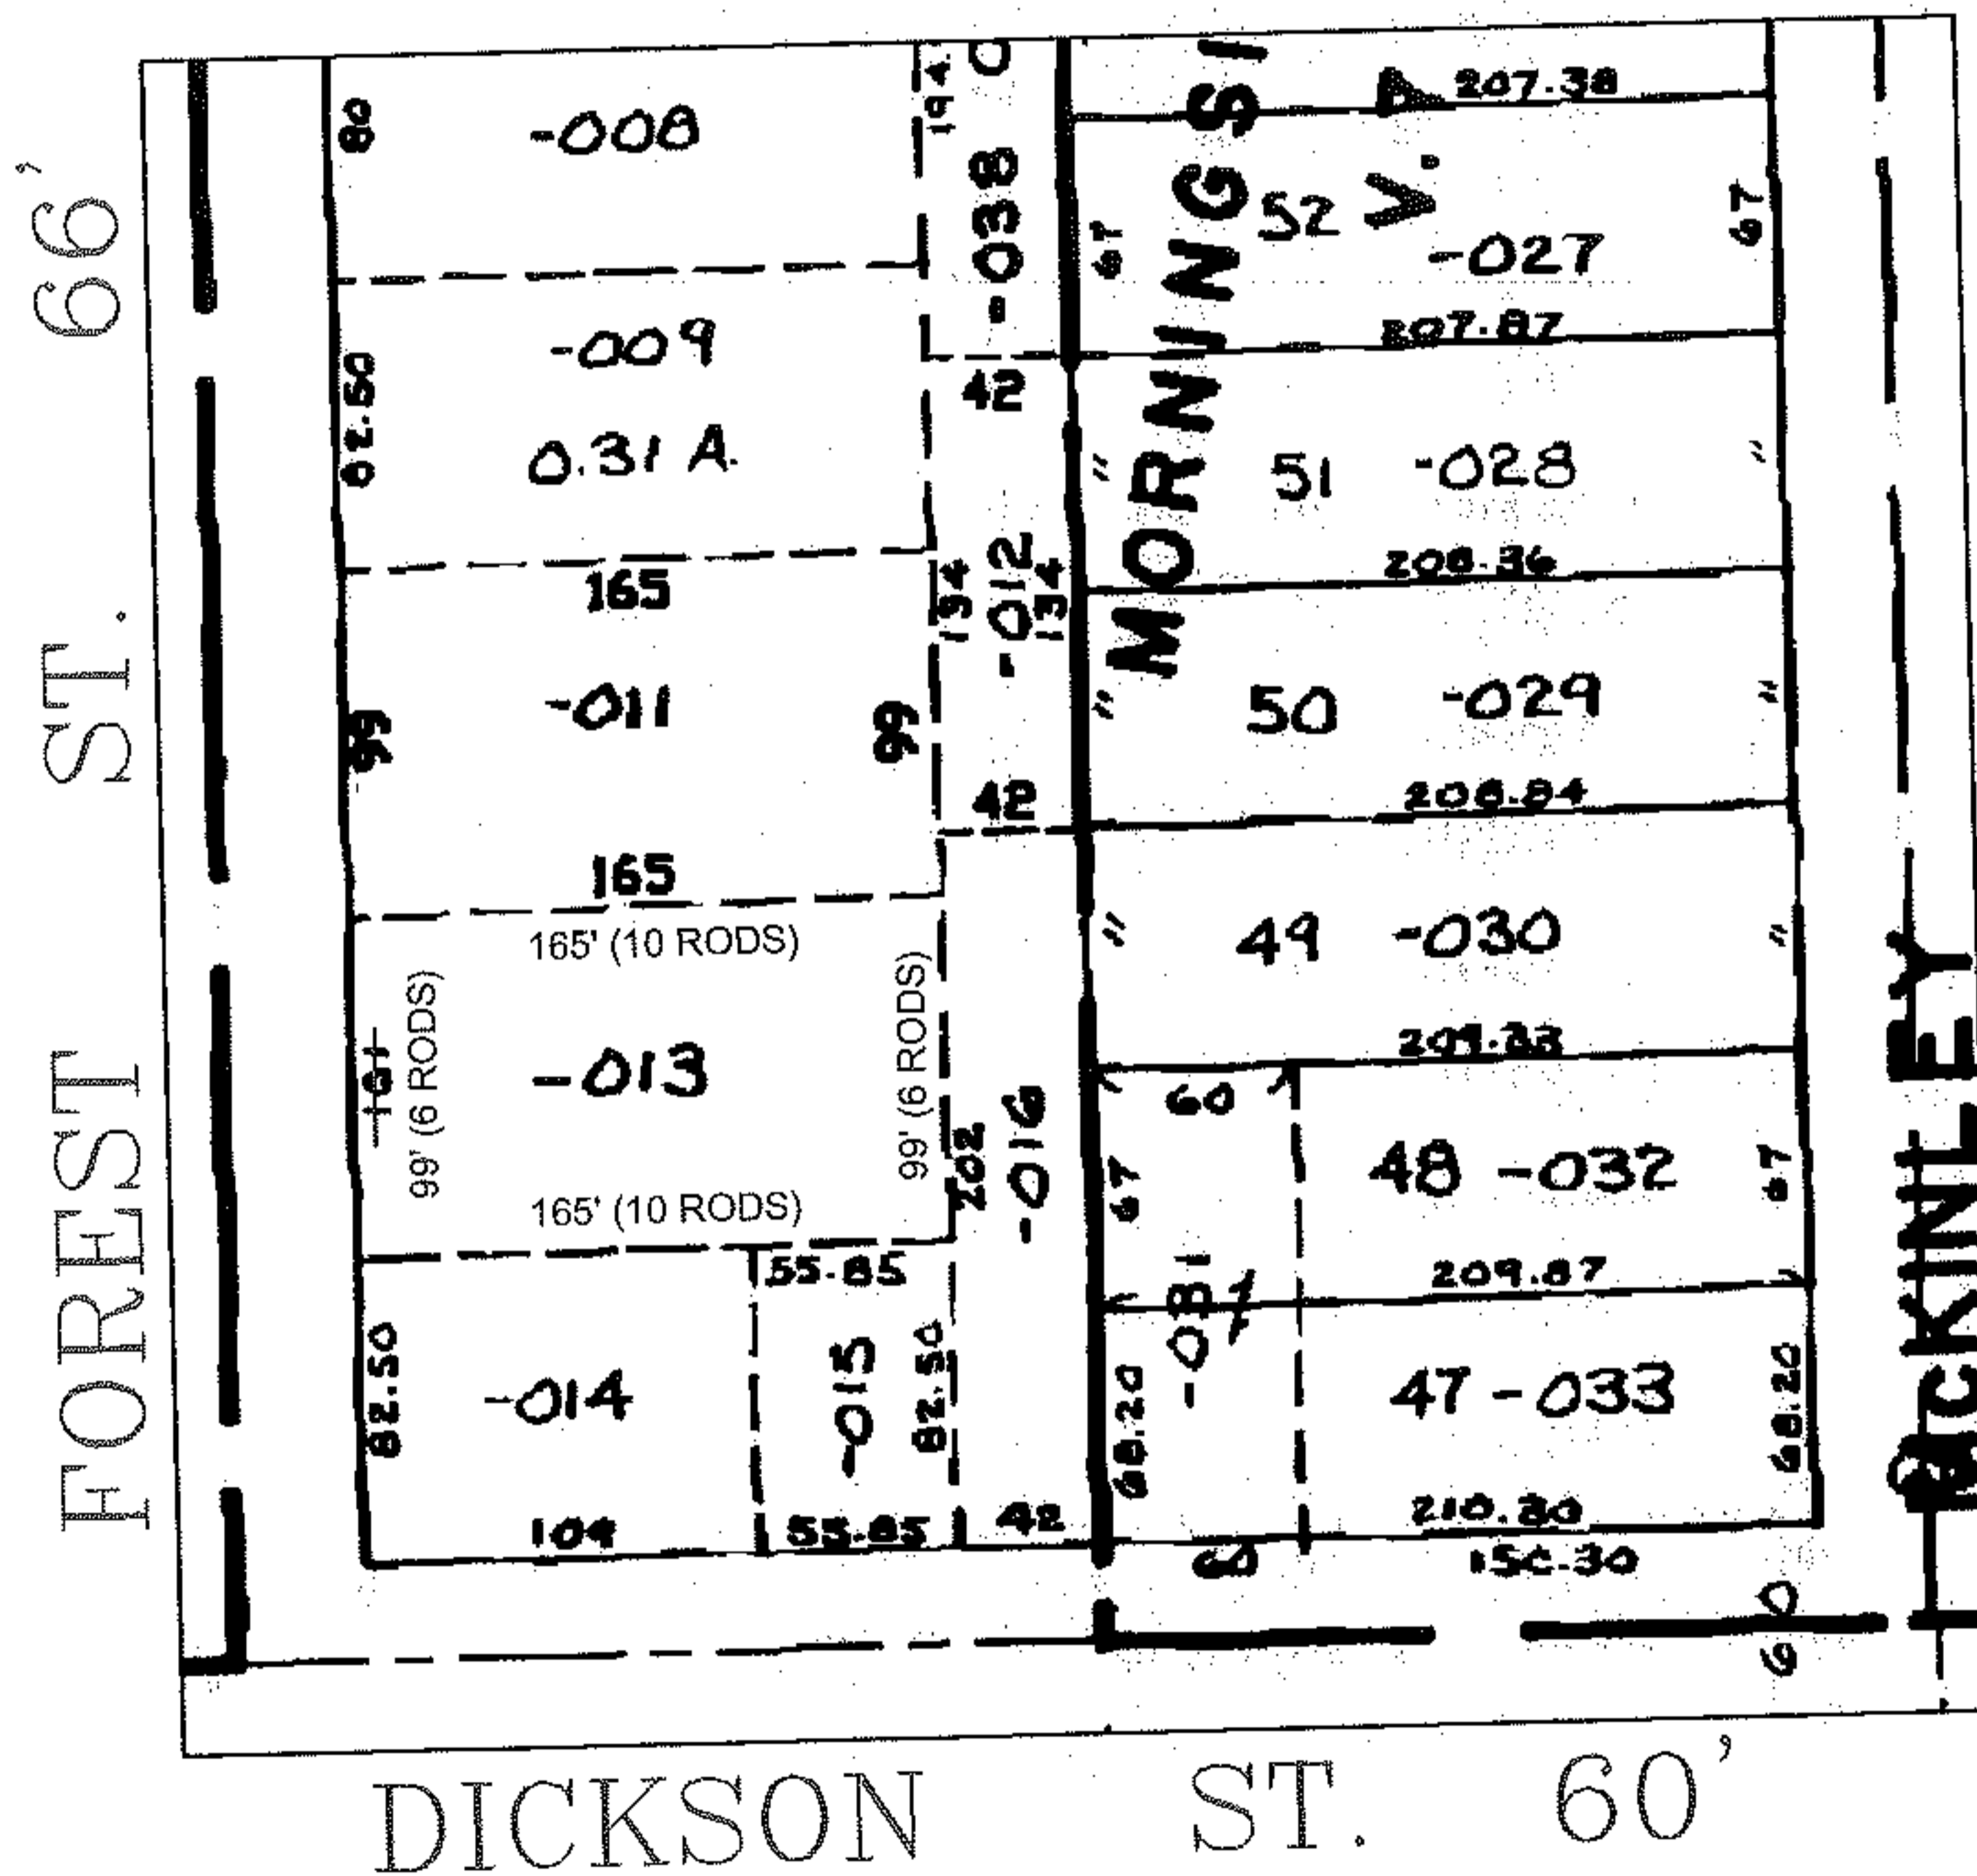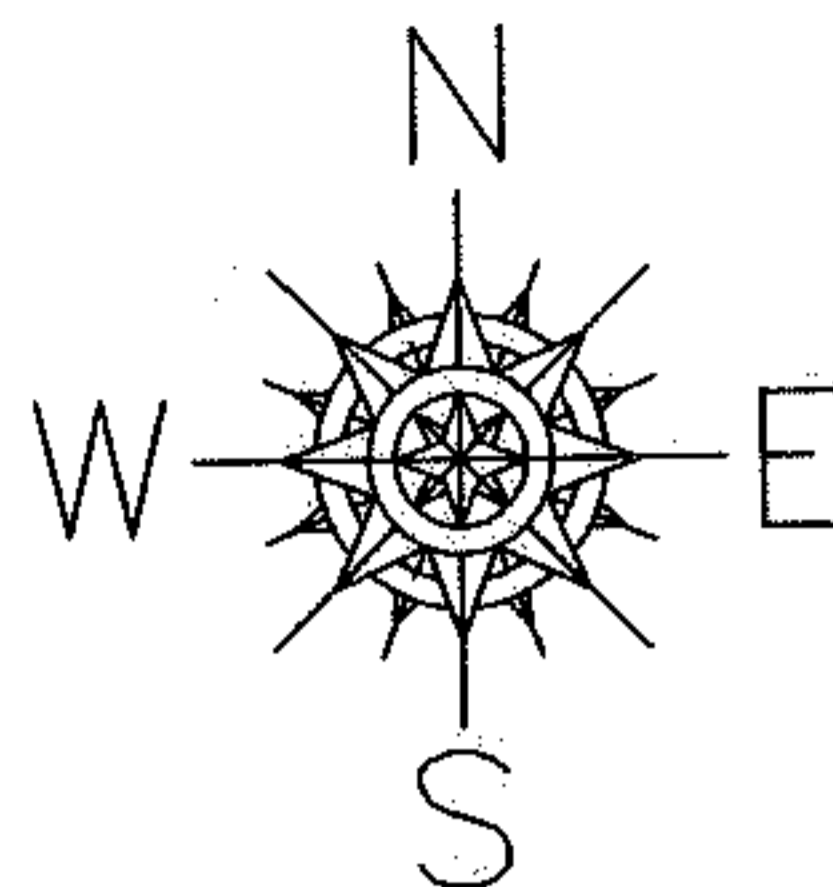

SPLITS/DEEDS PROCESSED

LORAIN COUNTY TAX MAP DEPARTMENT
226 MIDDLE AVE. ELYRIA, OHIO

SURVEYED BY: NONE

CLOSURE: NONE

MAP PAGE(S): 18-00-022-A

APPROVED BY: TJS DATE: 3/3/11

SCALE: 1"=100 PRIOR INST.: DV 1396/347