



RASTER

06-02253

PARENT PARCEL: 09-00-098-000-040

CHILD PARCEL: 09-00-098-000-056, -057

STARTING POINT: CENTERLINE OF PARSONS RD & O.L. 98

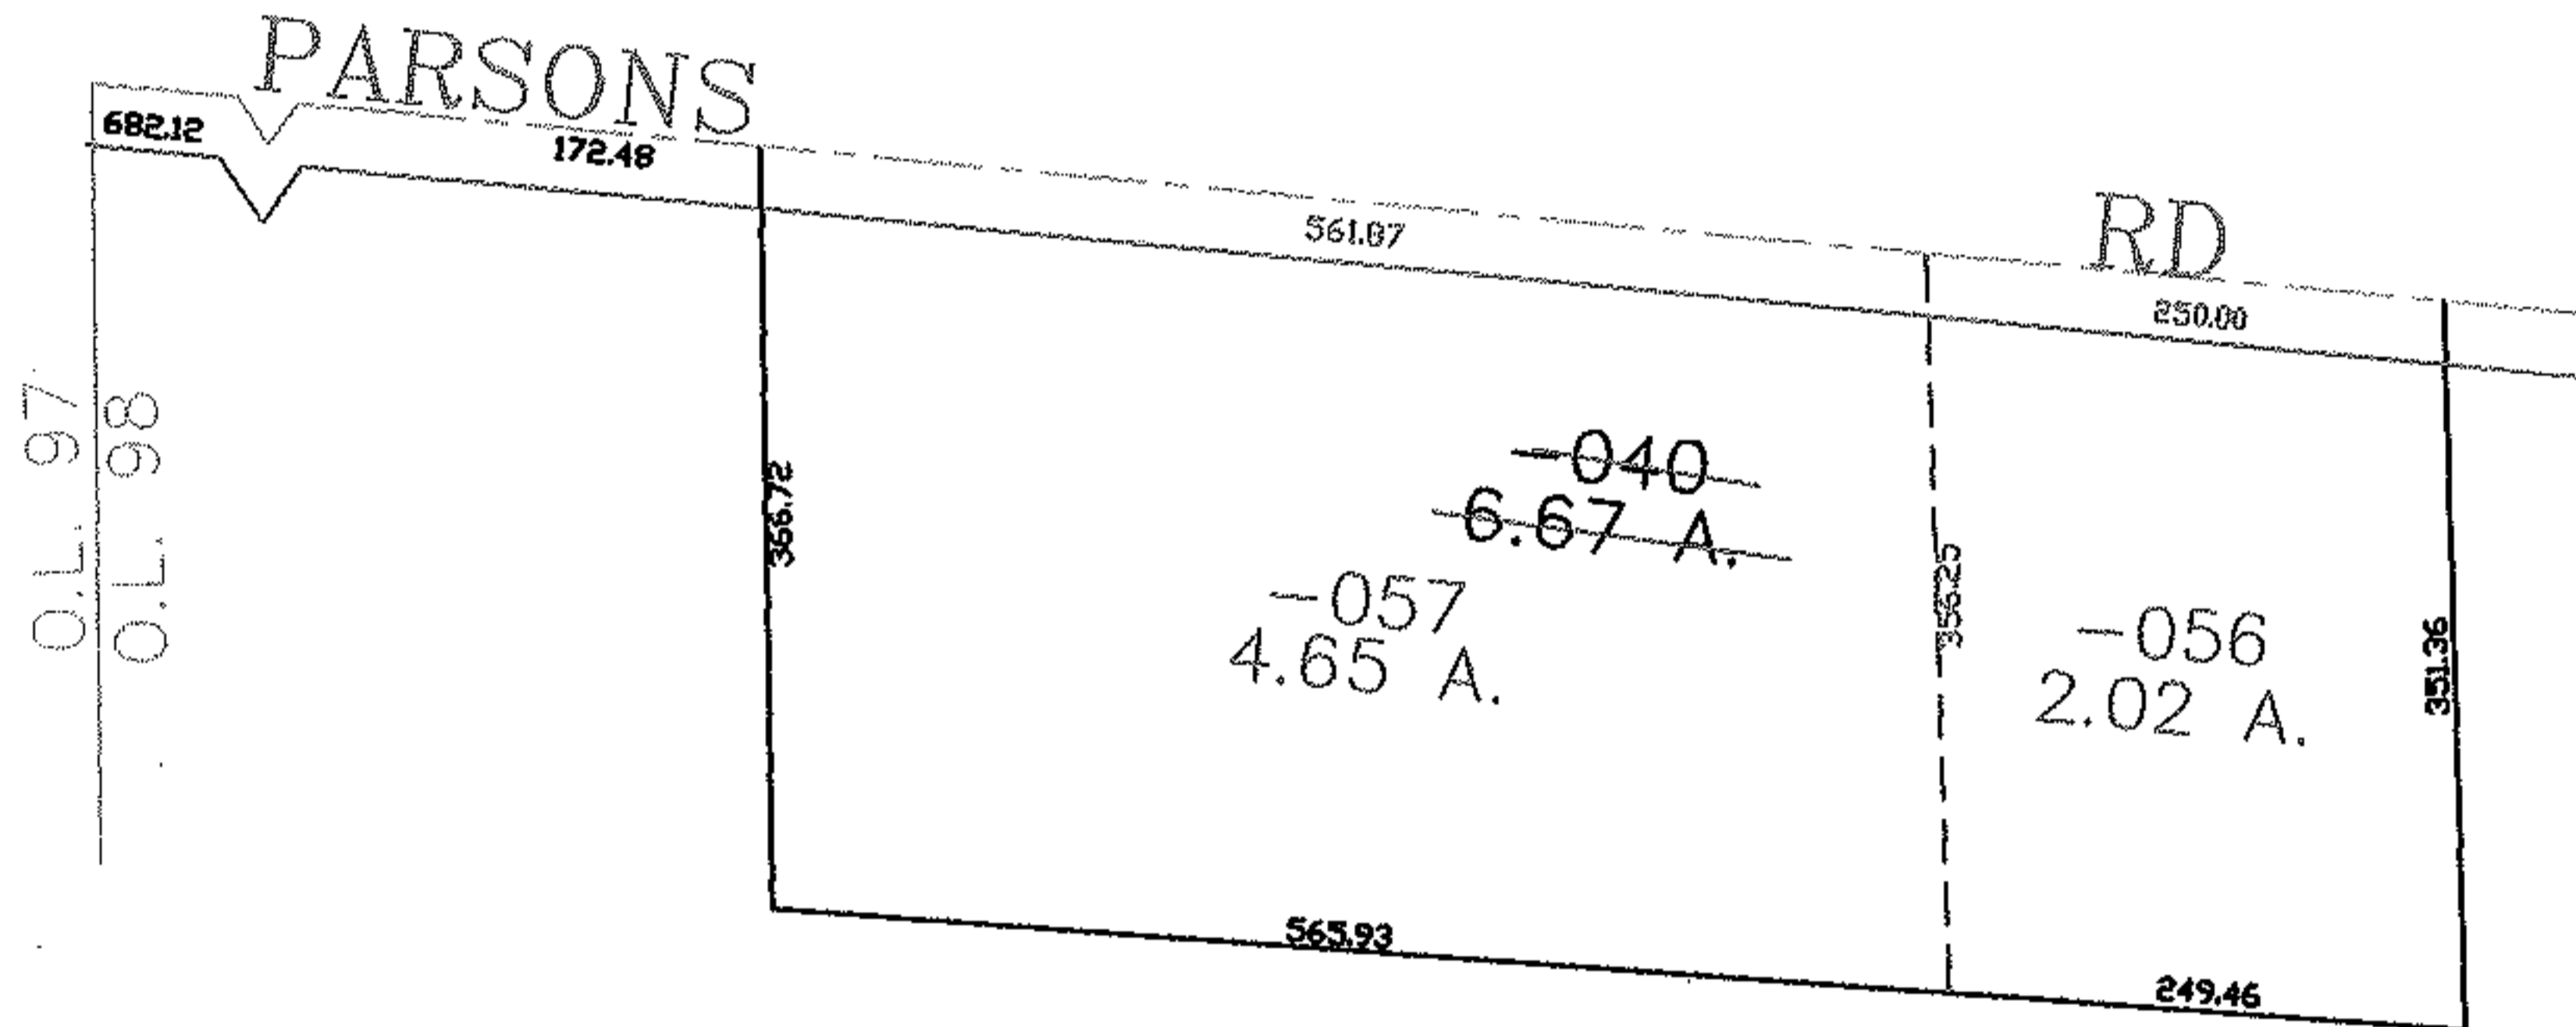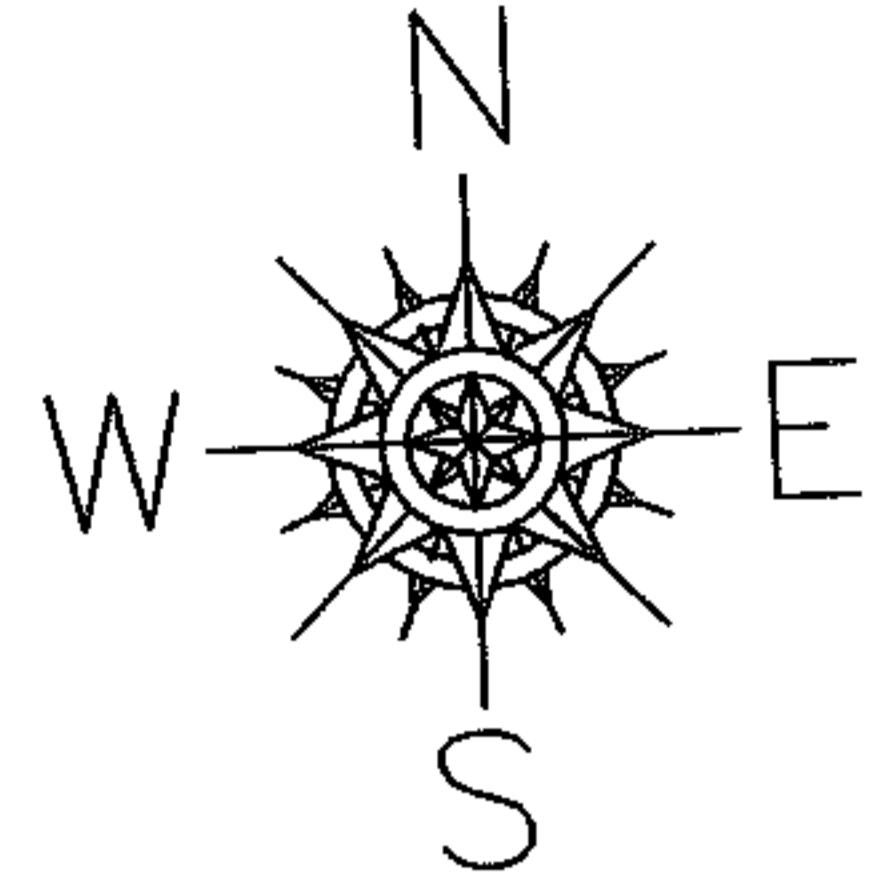

**SPLITS/DEEDS PROCESSED**

LORAIN COUNTY TAX MAP DEPARTMENT  
226 MIDDLE AVE. ELYRIA, OHIO

SURVEYED BY: THOMAS SIMON

CLOSURE: 0.00 : 10.000

MAP PAGE(S): 09-00-098-A

APPROVED BY: JAH DATE: 11-2-06

SCALE: 1" = 200 PRIOR INSTRUMENT: OR 46/260