
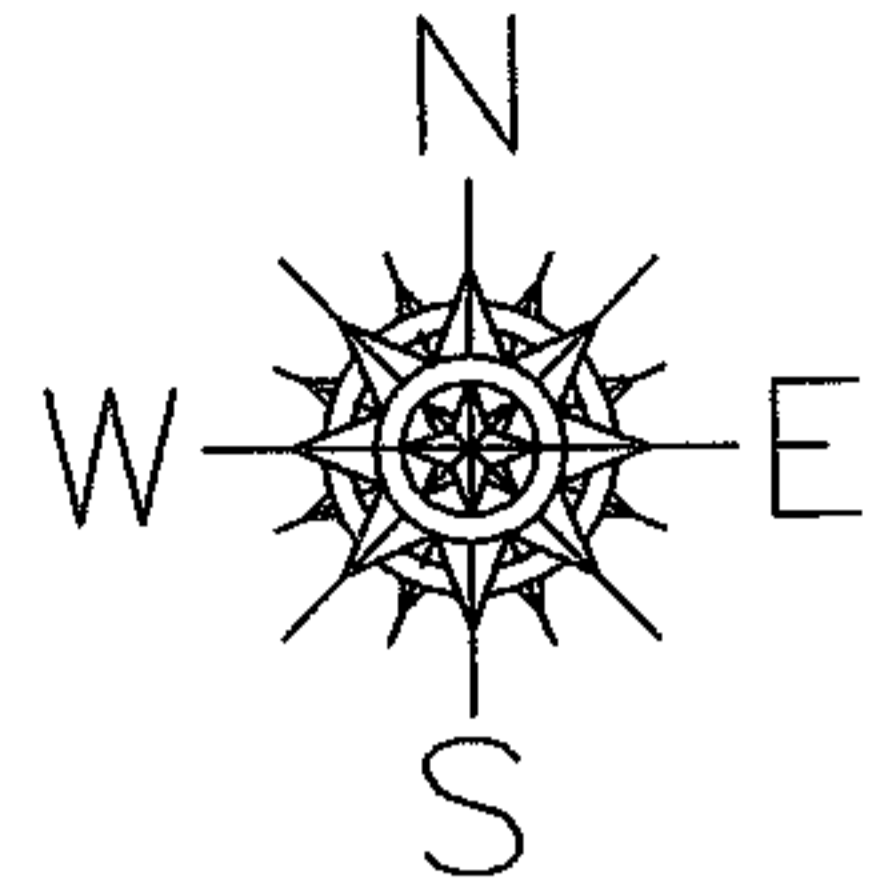


PARENT PARCEL: 18-00-015-000-060

CHILD PARCEL: 18-00-015-000-062, -063

06-02255

STARTING POINT: CENTERLINE OF HAWLEY RD & MEDINA-NORWALK RD

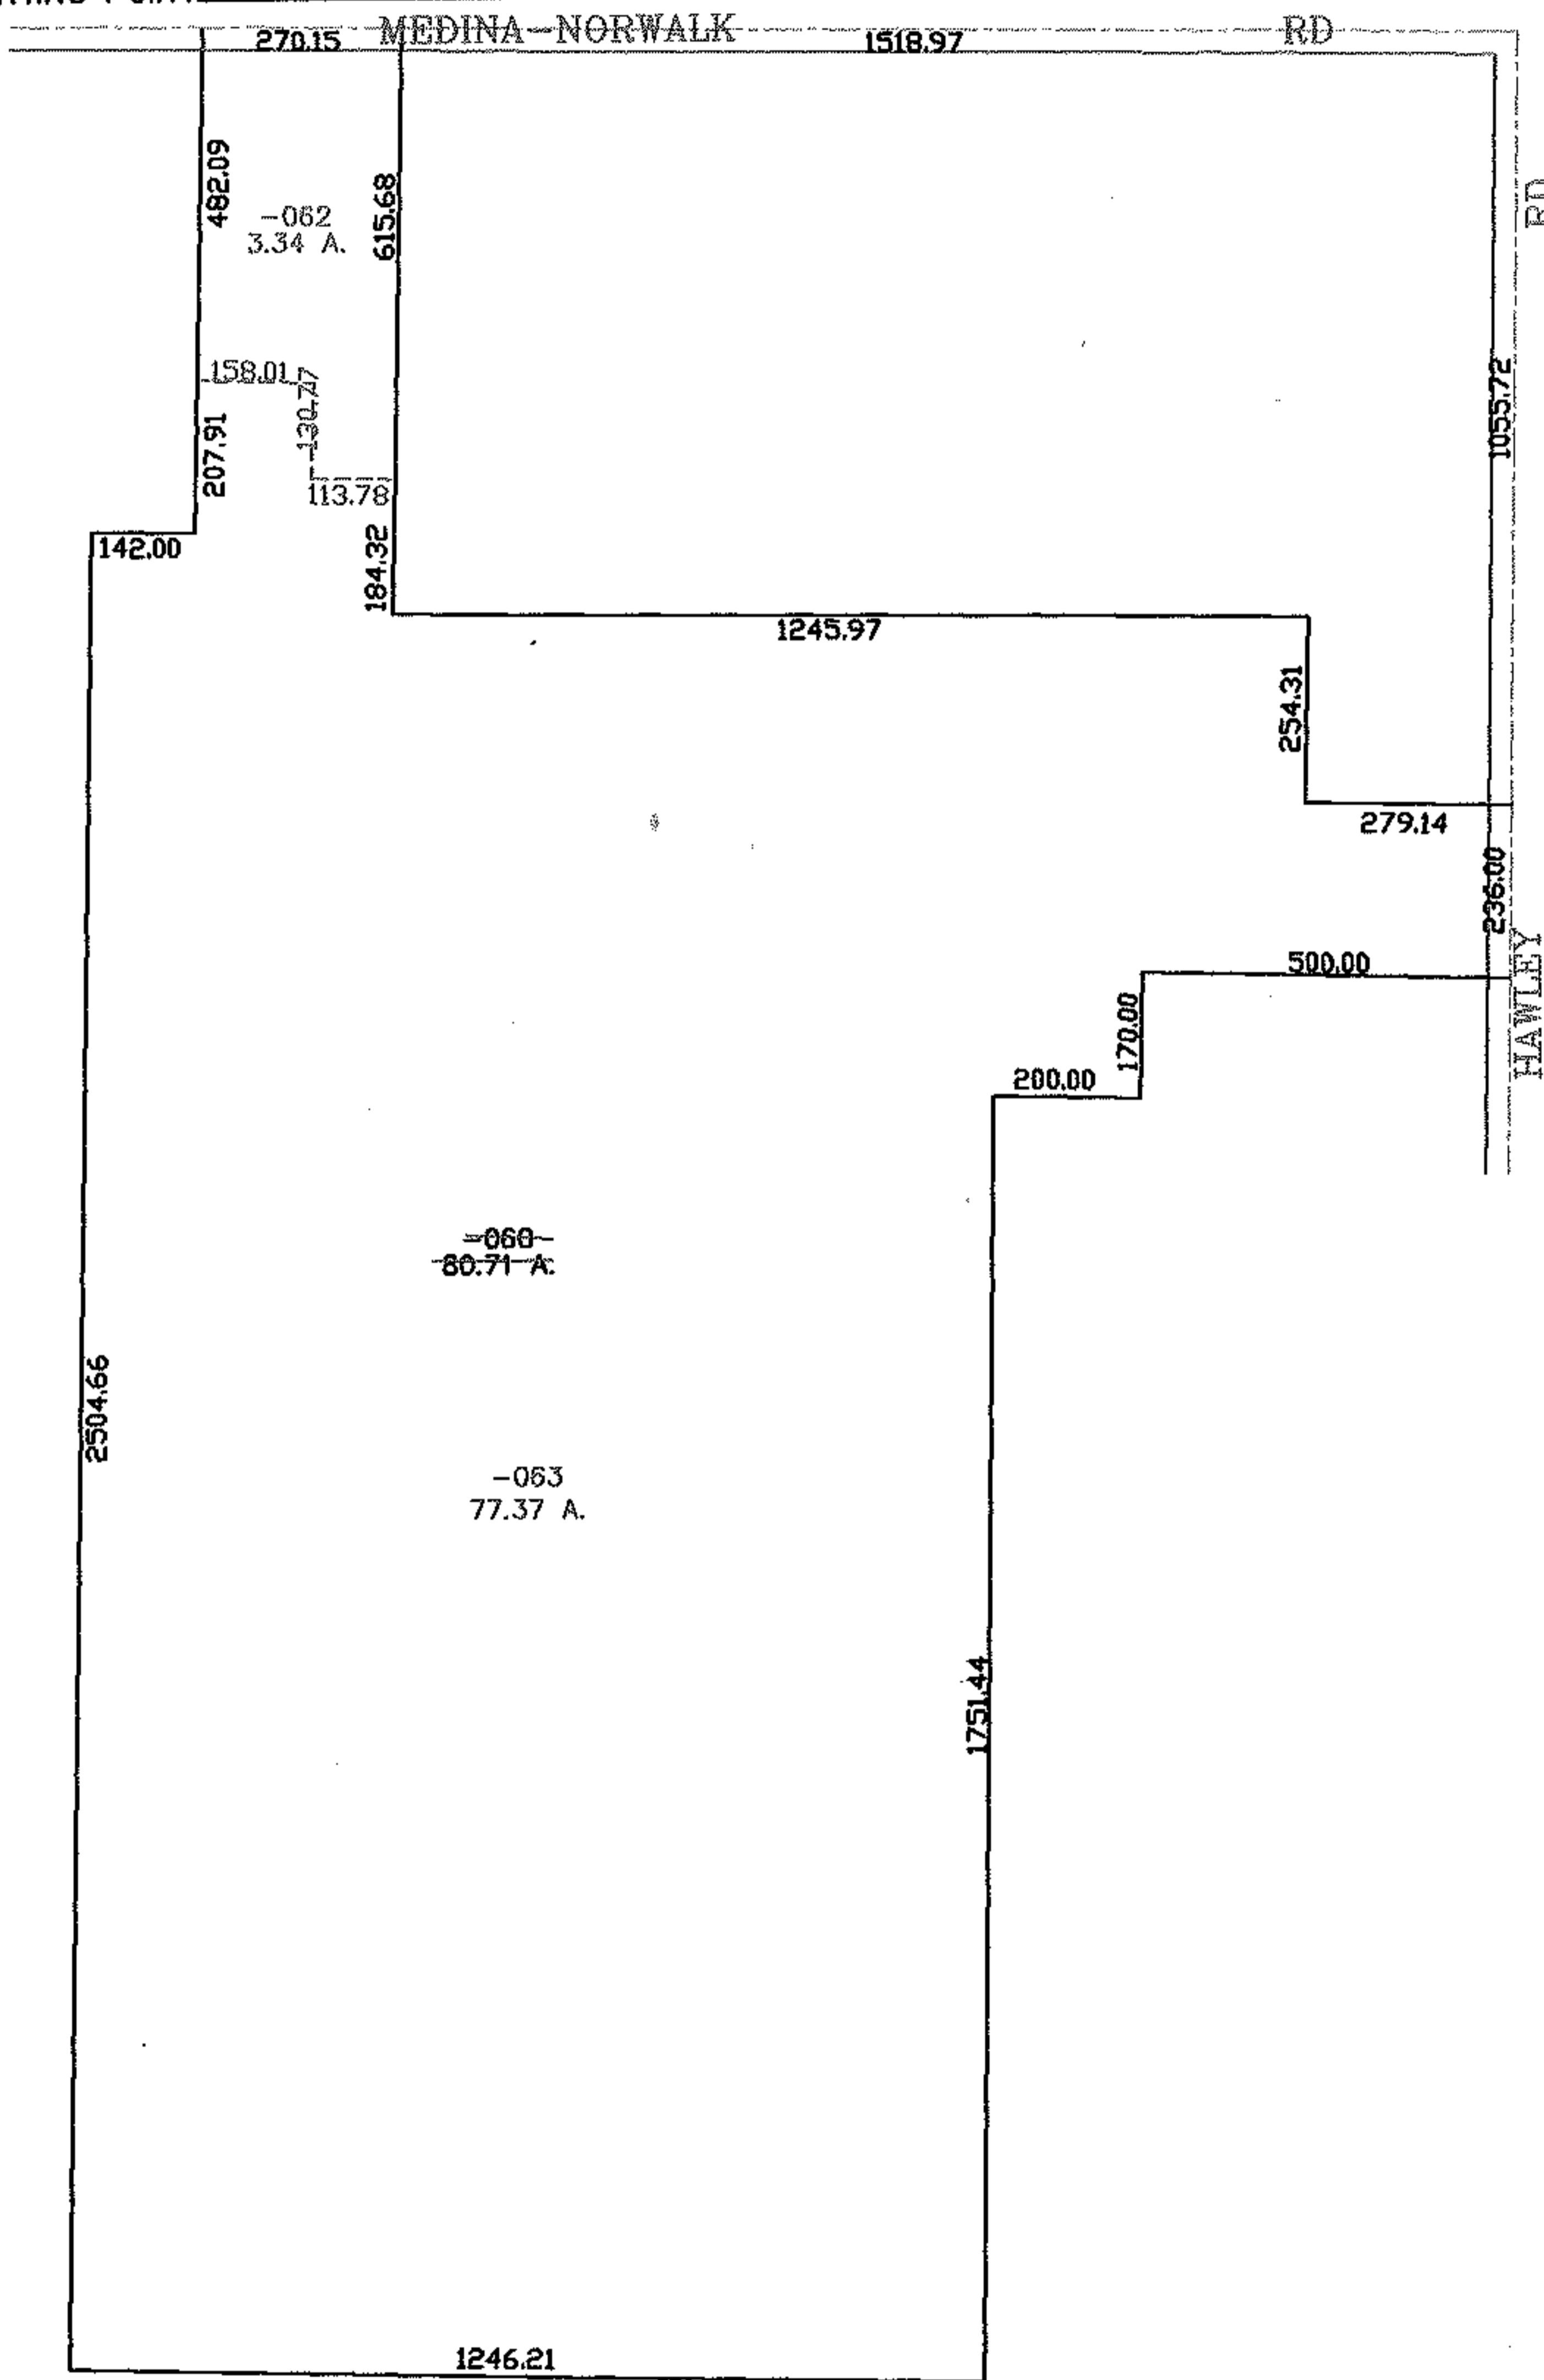

SPLITS/DEEDS PROCESSED

LORAIN COUNTY TAX MAP DEPARTMENT
226 MIDDLE AVE. ELYRIA, OHIO

SURVEYED BY: THOMAS SNEZEK

CLOSURE: 0.00 : 10.000

MAP PAGE(S): 18-00-015-B

APPROVED BY: JAH DATE: 11-2-06

SCALE: 1" = 400 PRIOR INSTRUMENT: 20060147598