


RASTER

PARENT PARCEL: 02-01-006-155-003


CHILD PARCEL: _____

STARTING POINT: S/L 43 IN STANG'S 2ND SUB. (VOL.4 PG.18)

11-02257-C

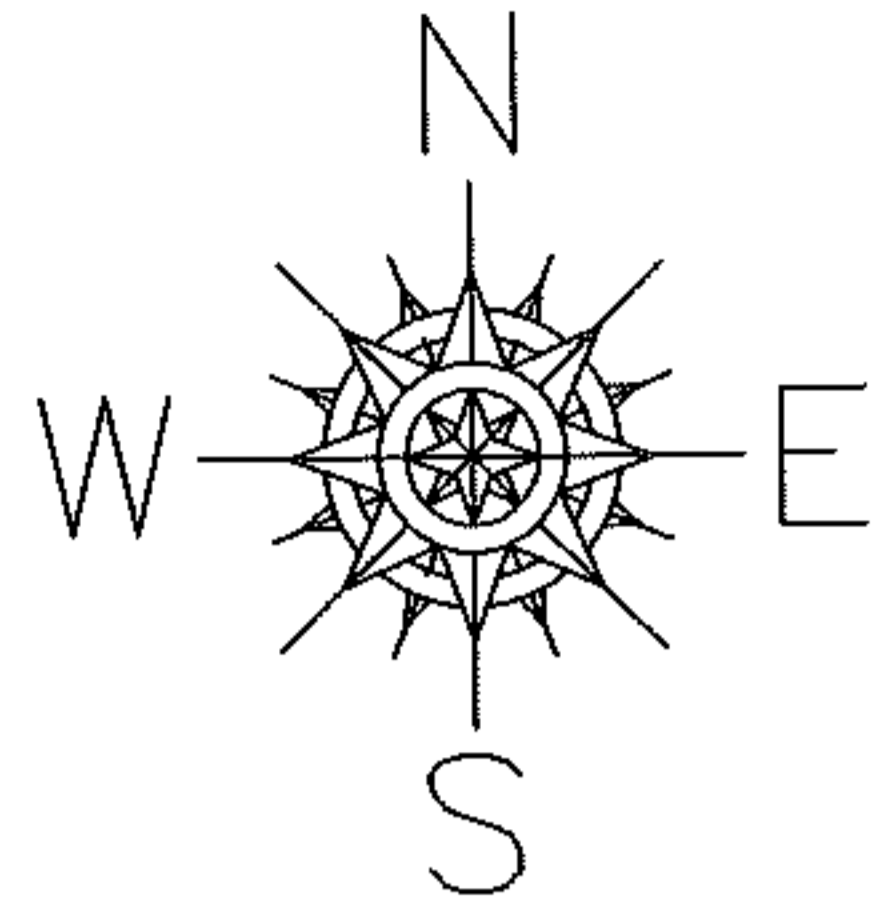

22ND ST.

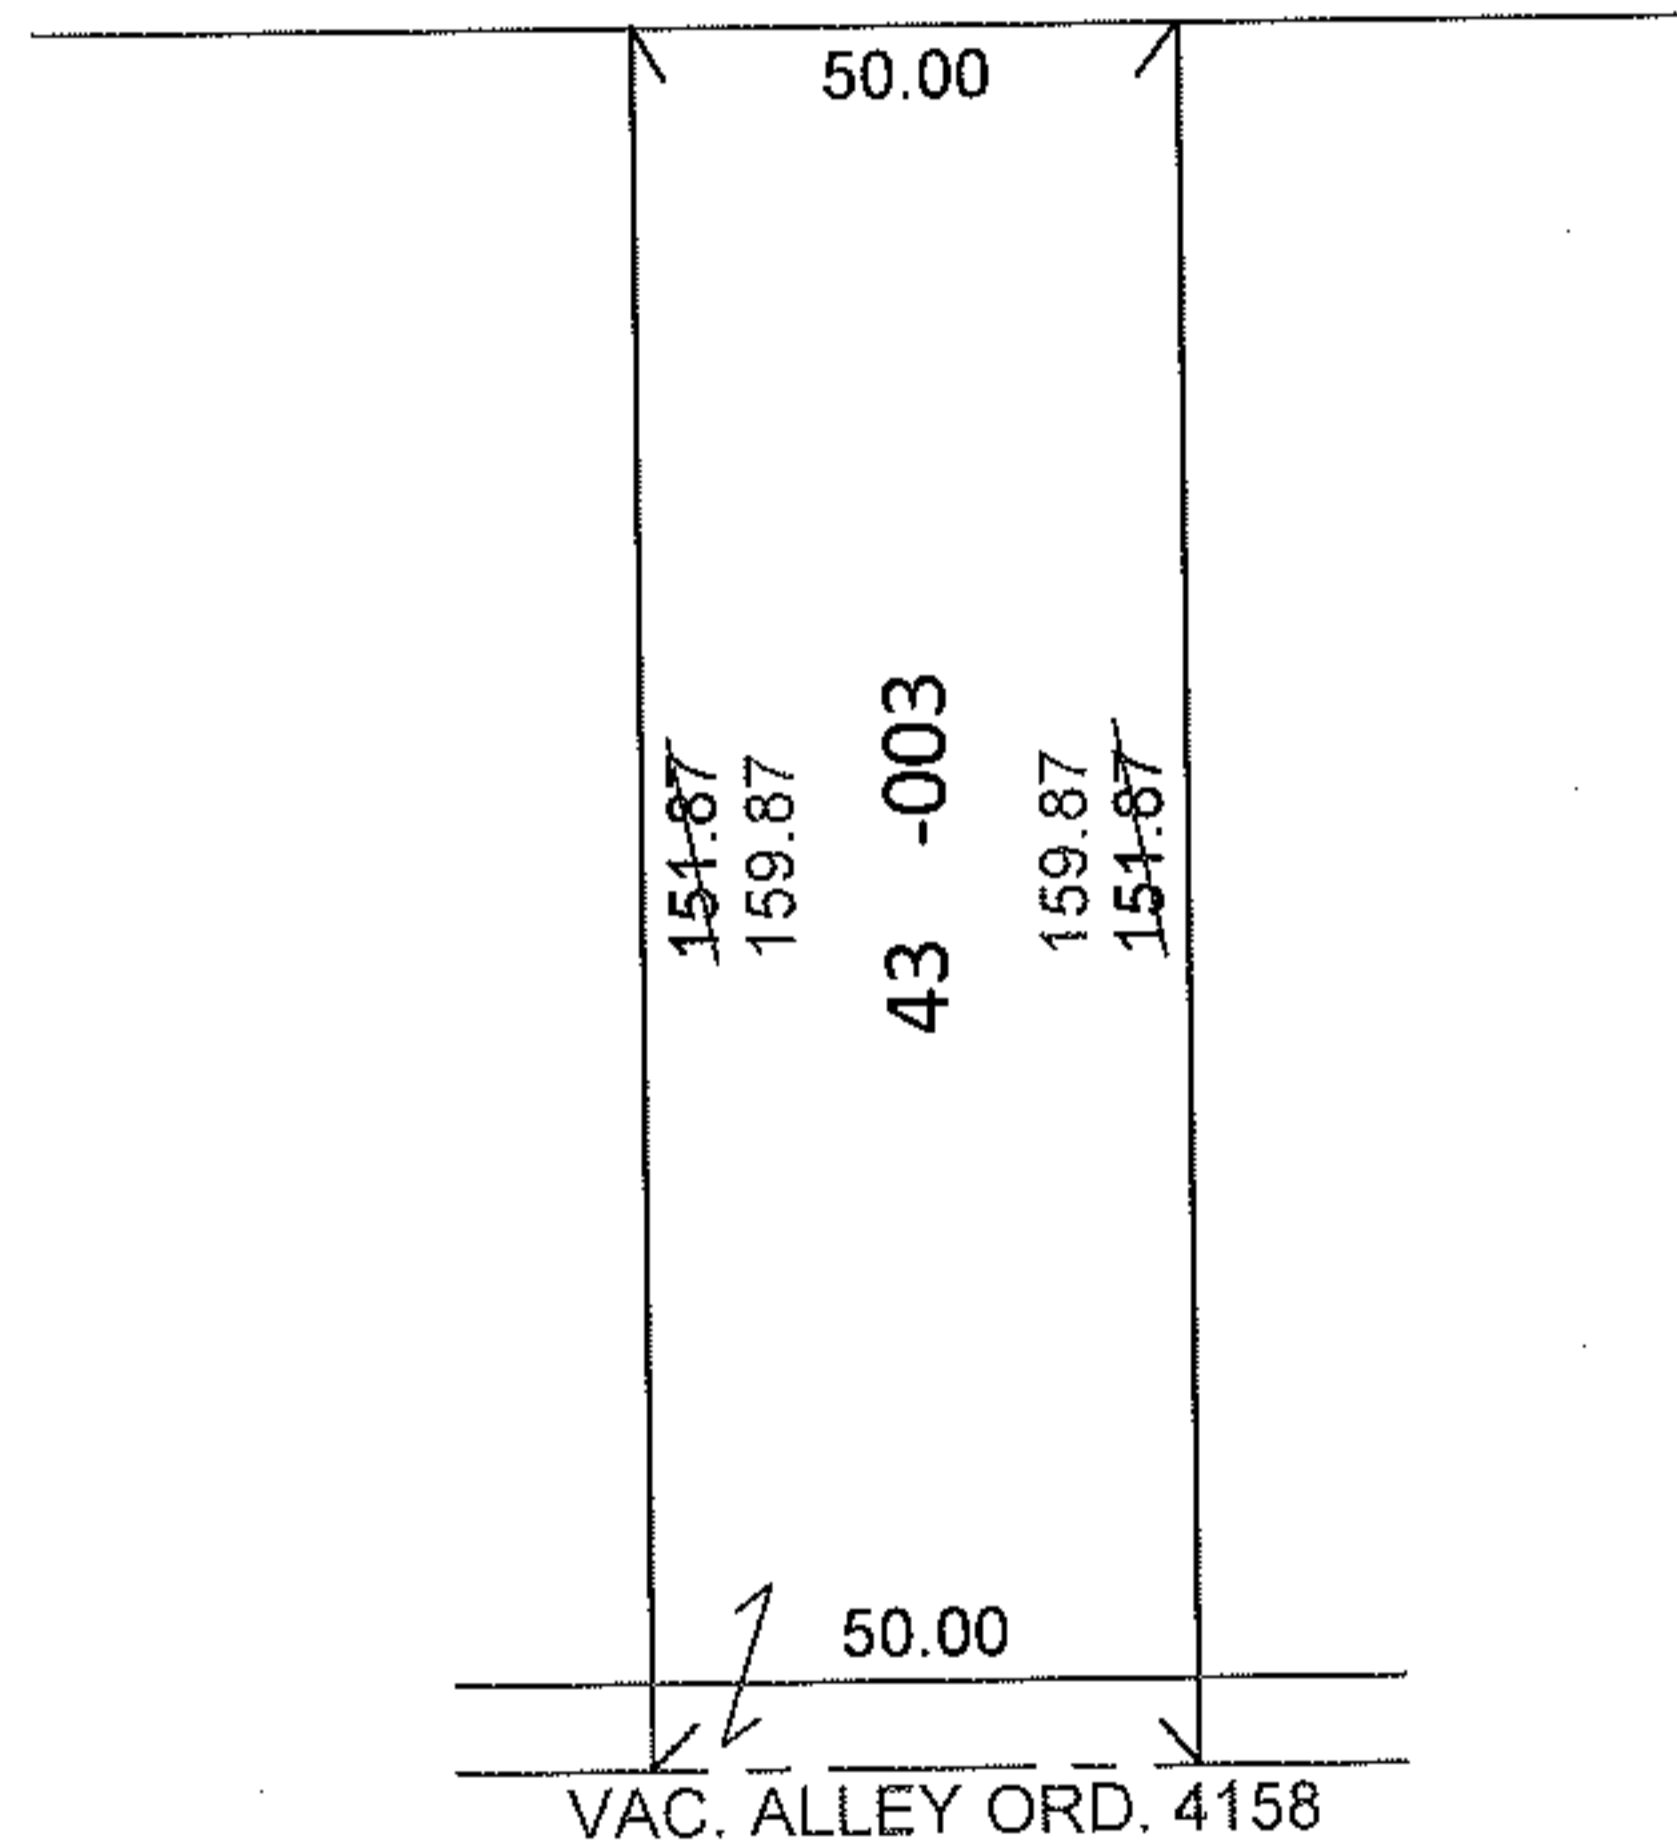


DEPTH CORRECTION

02-01-006-155-003

159.87

50 X ~~152~~

PER DEEDS AND VAC. ORD. 4158

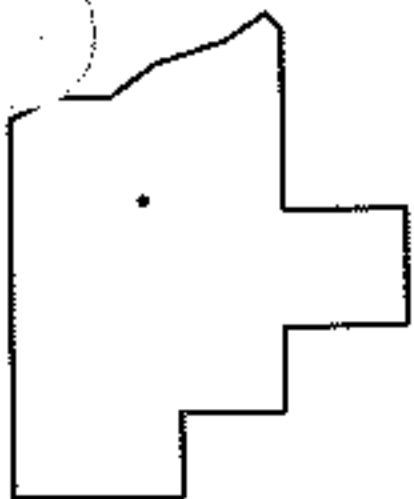

SPLITS/DEEDS PROCESSED

LORAIN COUNTY TAX MAP DEPARTMENT
226 MIDDLE AVE. ELYRIA, OHIO

SURVEYED BY: N/A

CLOSURE: N/A

MAP PAGE(S): 2-01-006-F

APPROVED BY: RRM DATE: 5-24-11

SCALE: 1"= 50' PRIOR INST.: 20040984252