
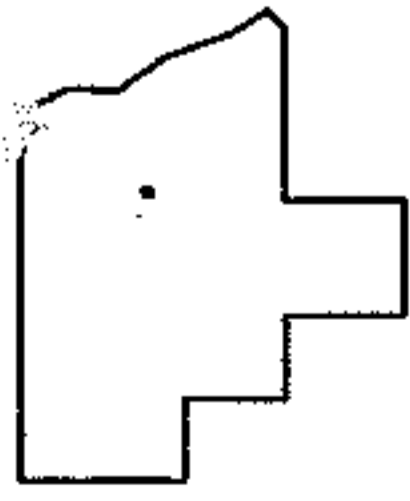
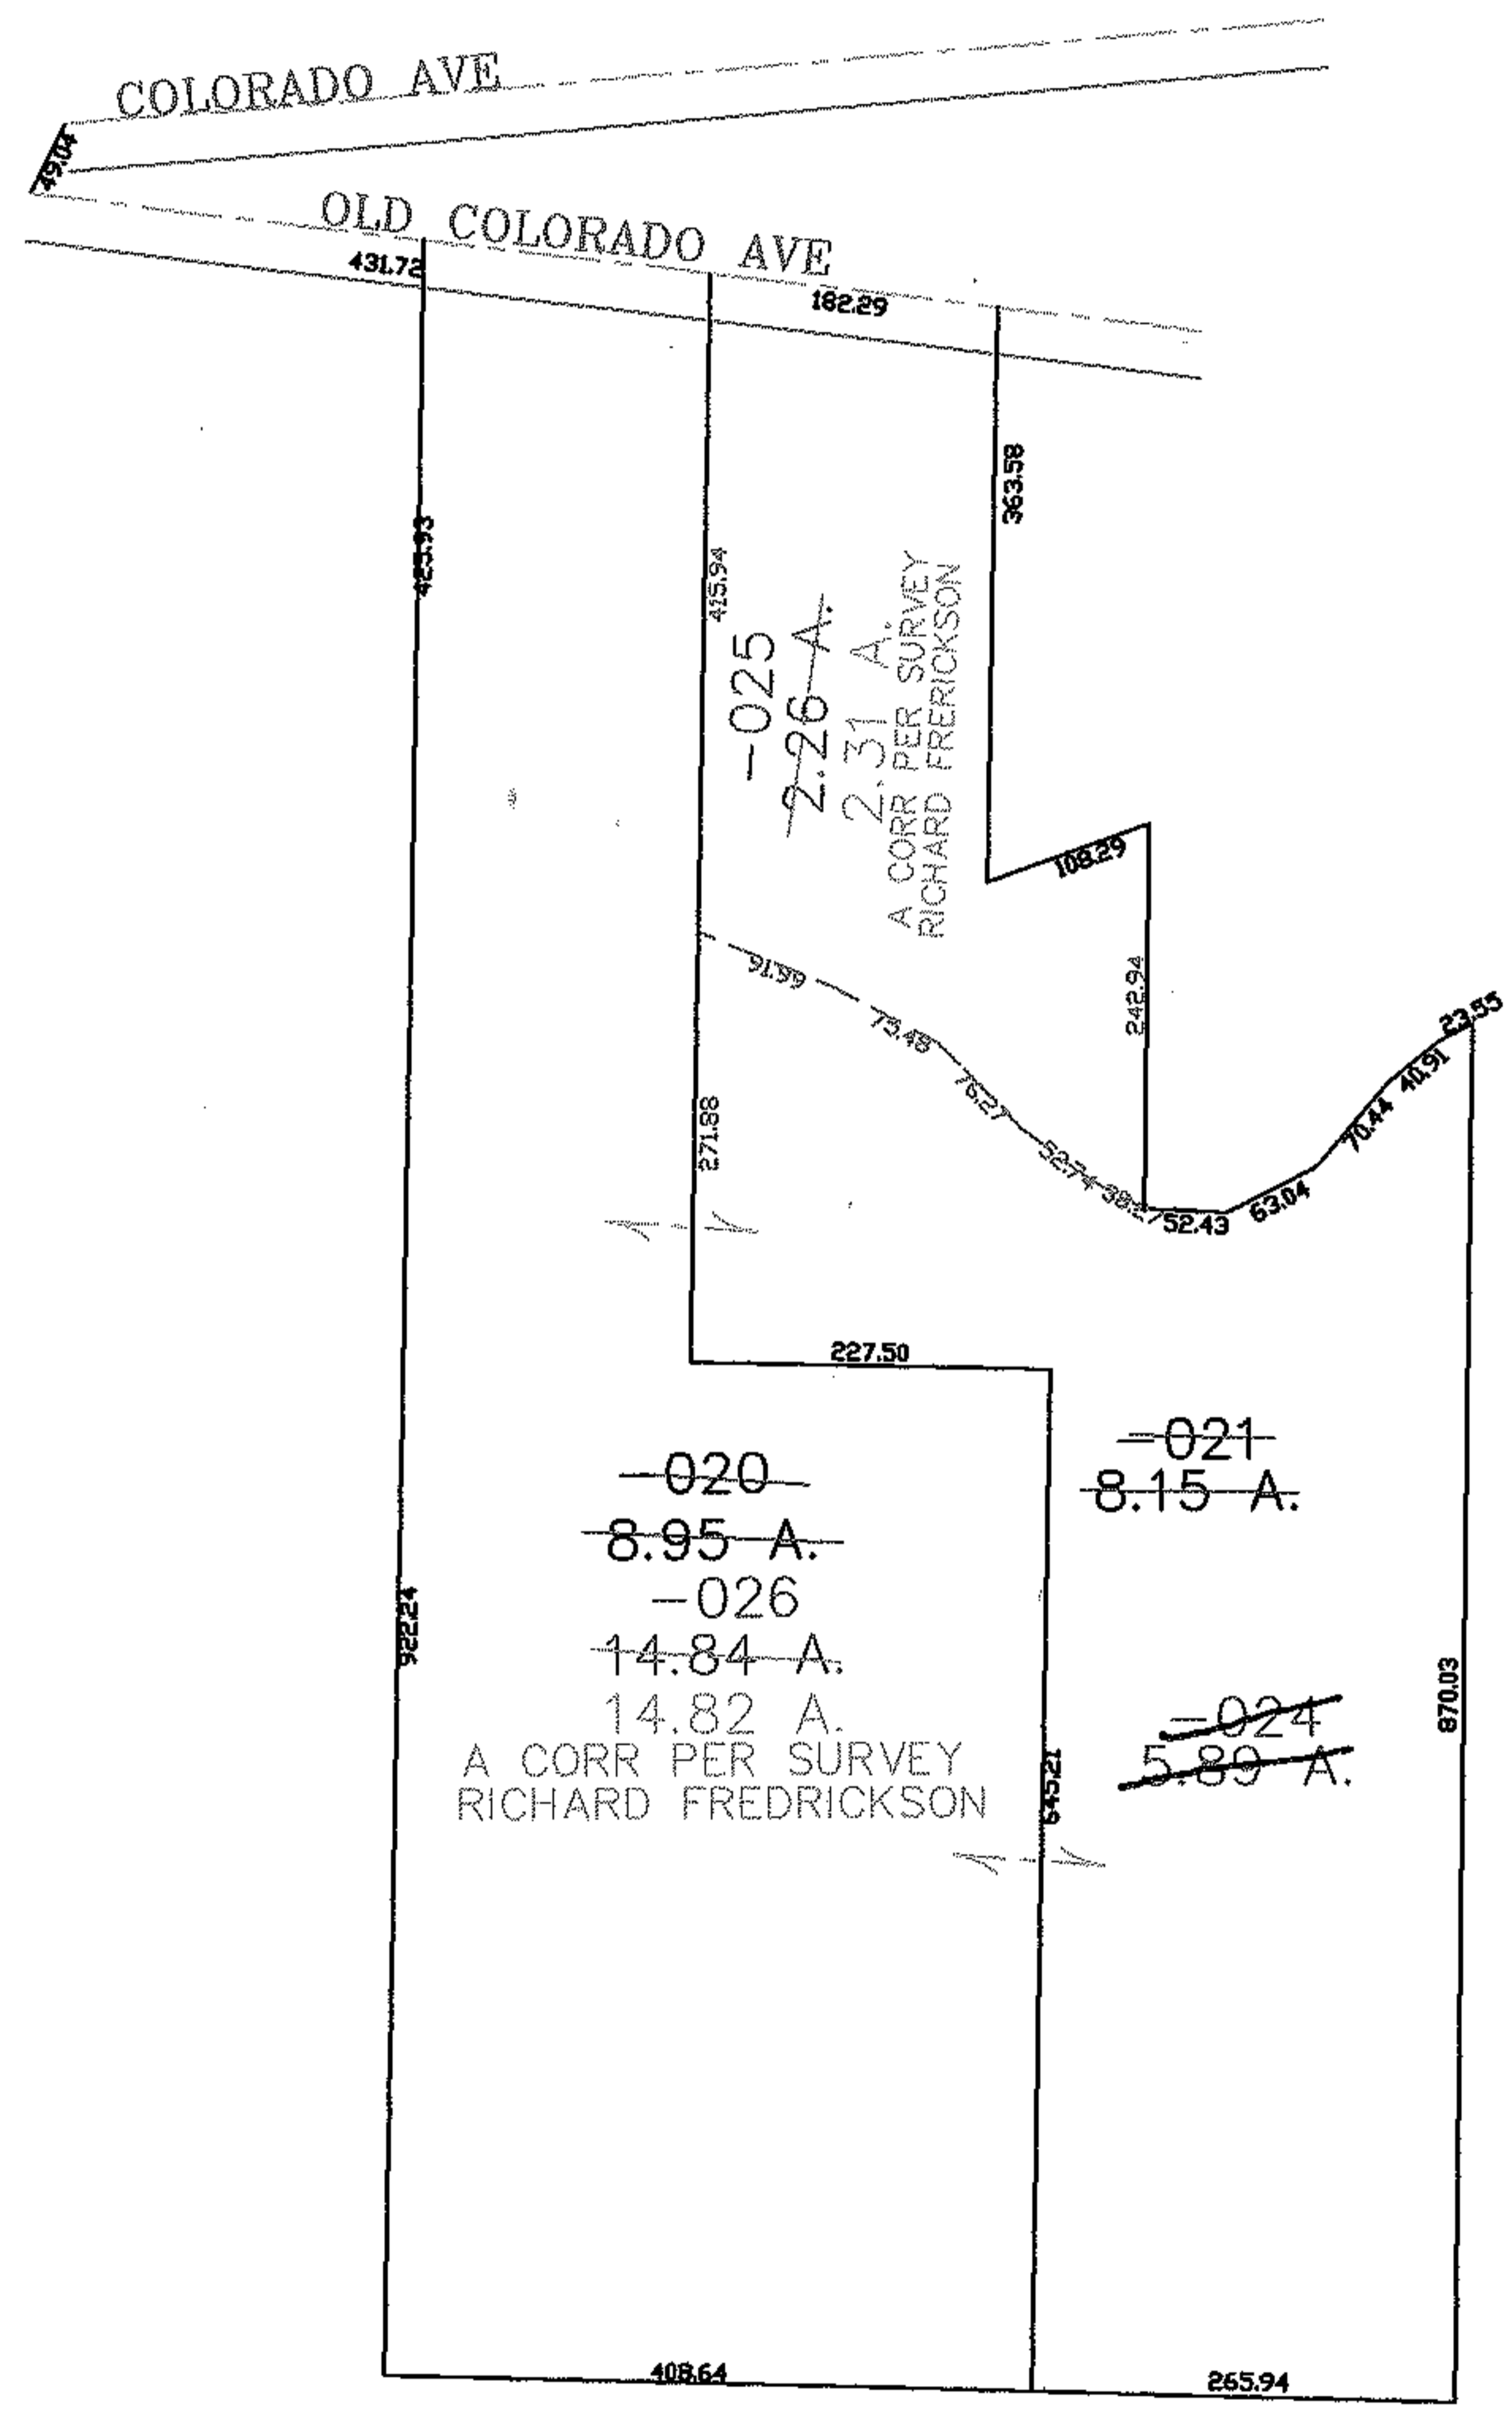


PARENT PARCEL: 03-00-022-102-021, -020  
CHILD PARCEL: 03-00-022-102-024 THRU -026  
STARTING POINT: CENTERLINE OF COLORADO AVE & OLD COLORADO AVE

06-02257

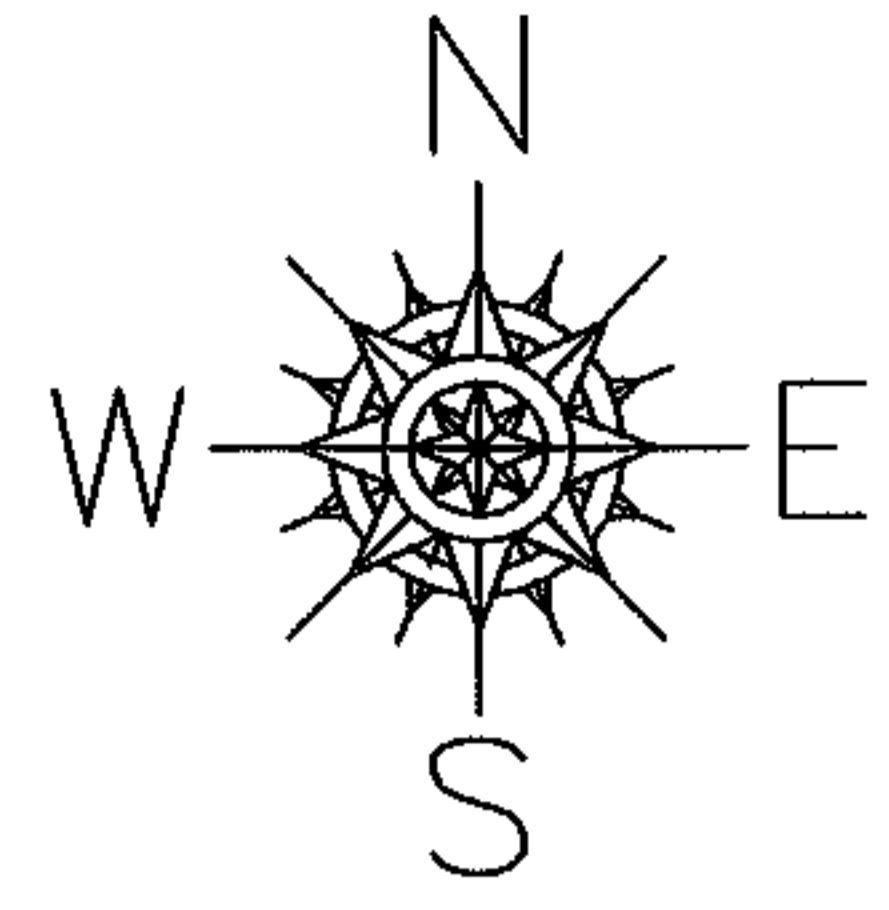

**SPLITS/DEEDS PROCESSED**  
LORAIN COUNTY TAX MAP DEPARTMENT  
226 MIDDLE AVE. ELYRIA, OHIO

SURVEYED BY: RICHARD FREDRICKSON  
CLOSURE: 0.00 : 10.000  
MAP PAGE(S): 03-00-022-B  
APPROVED BY: JAH DATE: 11-2-06  
SCALE: 1" = 200 PRIOR INSTRUMENT: 20000675381