


PARENT PARCEL: SEE BELOW


06-02258

CHILD PARCEL: 05-00-001-000-201 TRHU -205

STARTING POINT: CENTERLINE OF OAK POINT ROAD AND COOPER FOSTER PARK RD

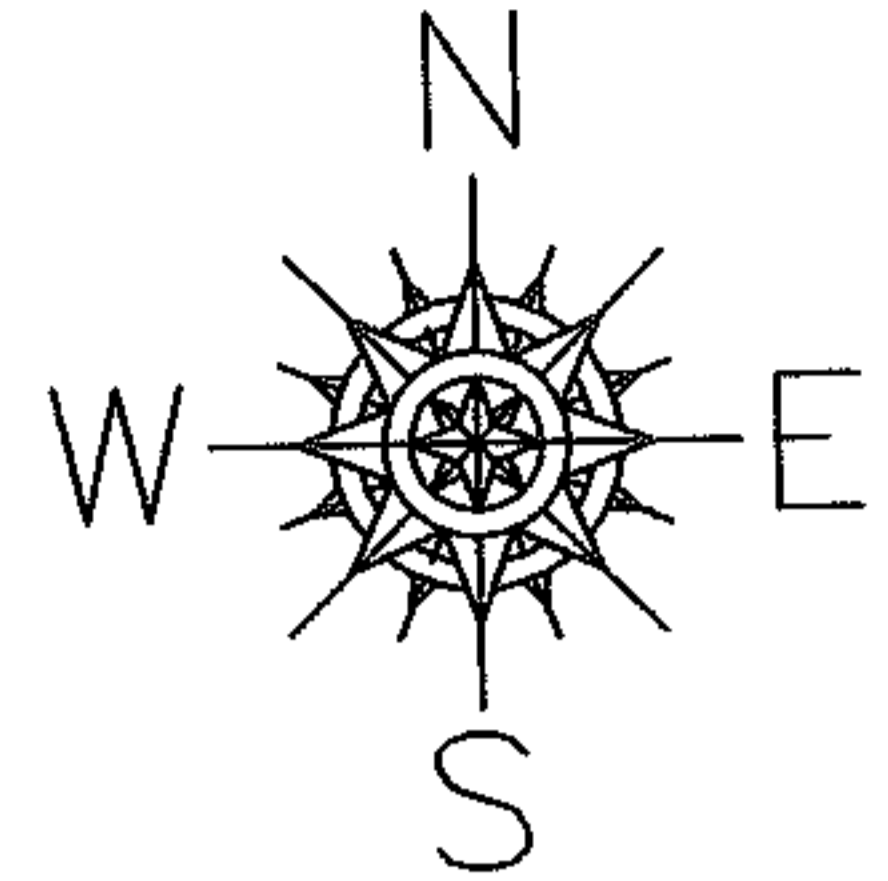

- 05-00-001-000-048
- 05-00-001-000-012
- 05-00-001-000-049
- 05-00-001-000-025
- 05-00-001-000-026
- 05-00-001-000-028
- 05-00-001-000-024
- 05-00-001-000-027
- 05-00-001-000-200
- 05-00-001-000-041
- 05-00-001-000-150
- 05-00-001-000-151

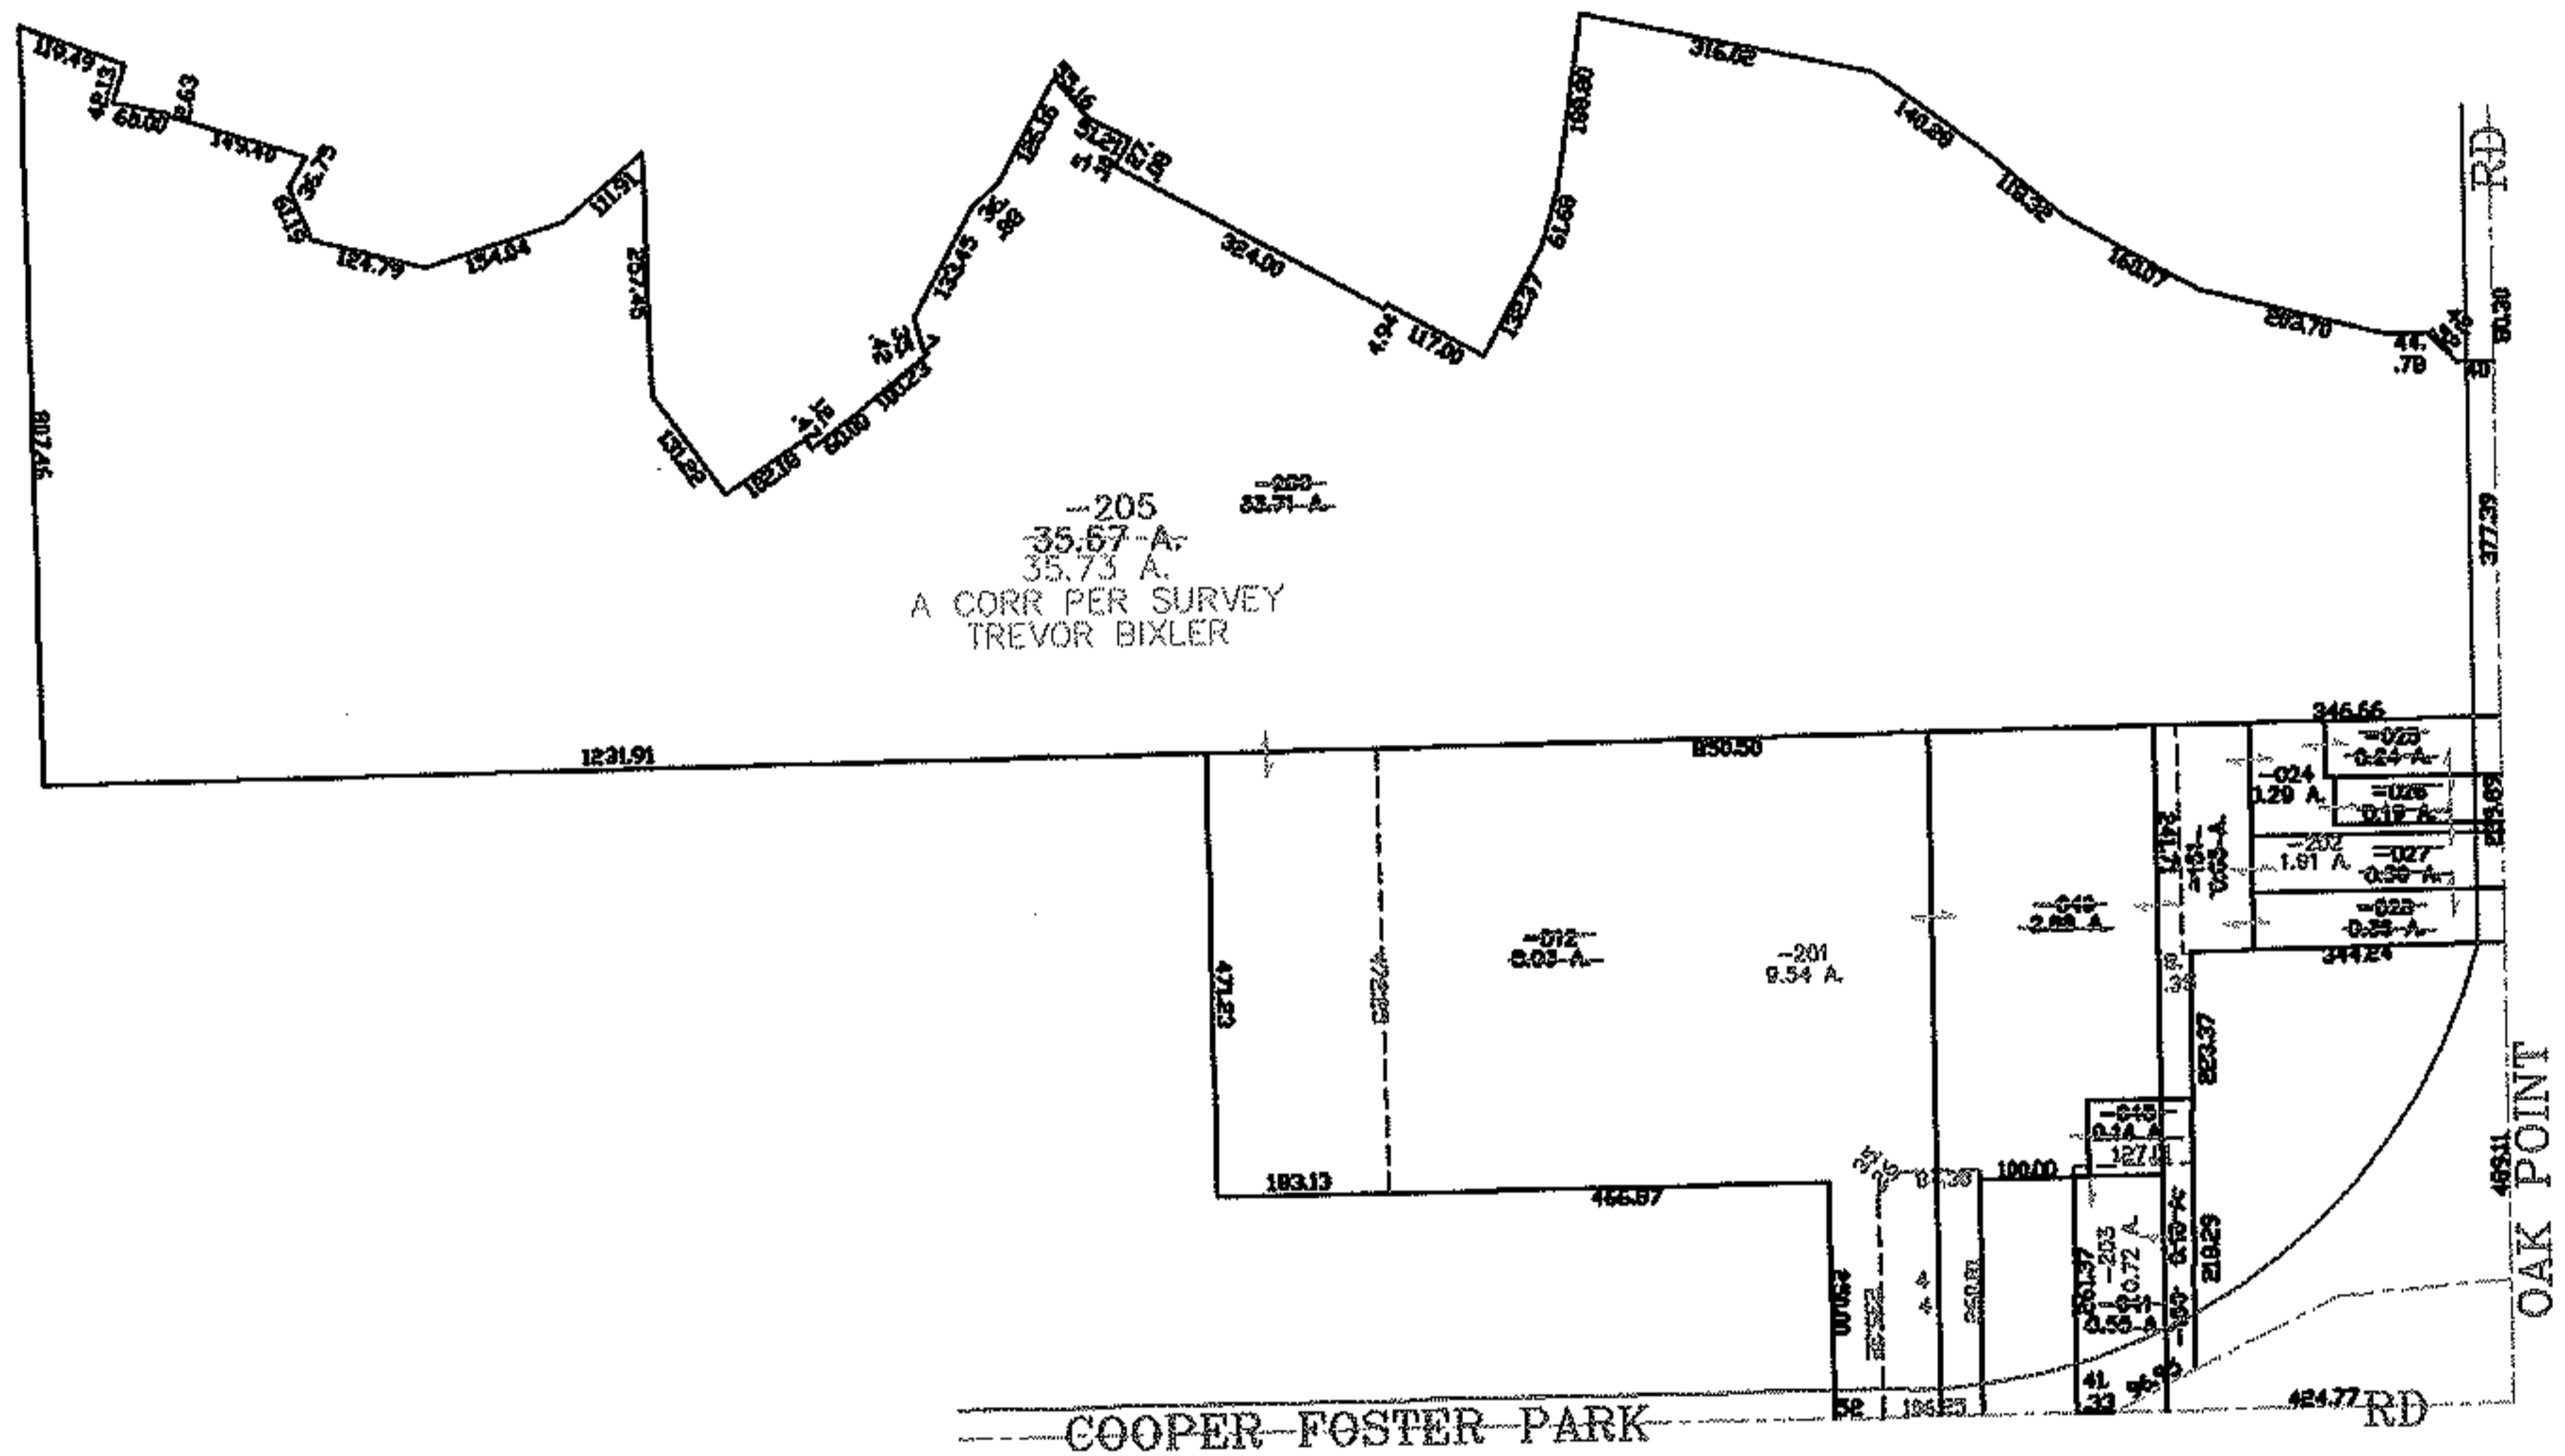

**SPLITS/DEEDS PROCESSED**

LORAIN COUNTY TAX MAP DEPARTMENT  
226 MIDDLE AVE. ELYRIA, OHIO

SURVEYED BY: TREVOR BIXLER

CLOSURE: 0.00 : 10.000

MAP PAGE(S): 05-00-001-B

APPROVED BY: JAH DATE: 11-8-06

SCALE: 1" = 100 PRIOR INSTRUMENT: 2004002323