



RASTER

PARENT PARCEL: 04-00-021-000-107

CHILD PARCEL: 04-00-021-000-236, -237

STARTING POINT: CENTERLINE OF AVON COMMERCE PKWY & JAYCOX RD

06-02261

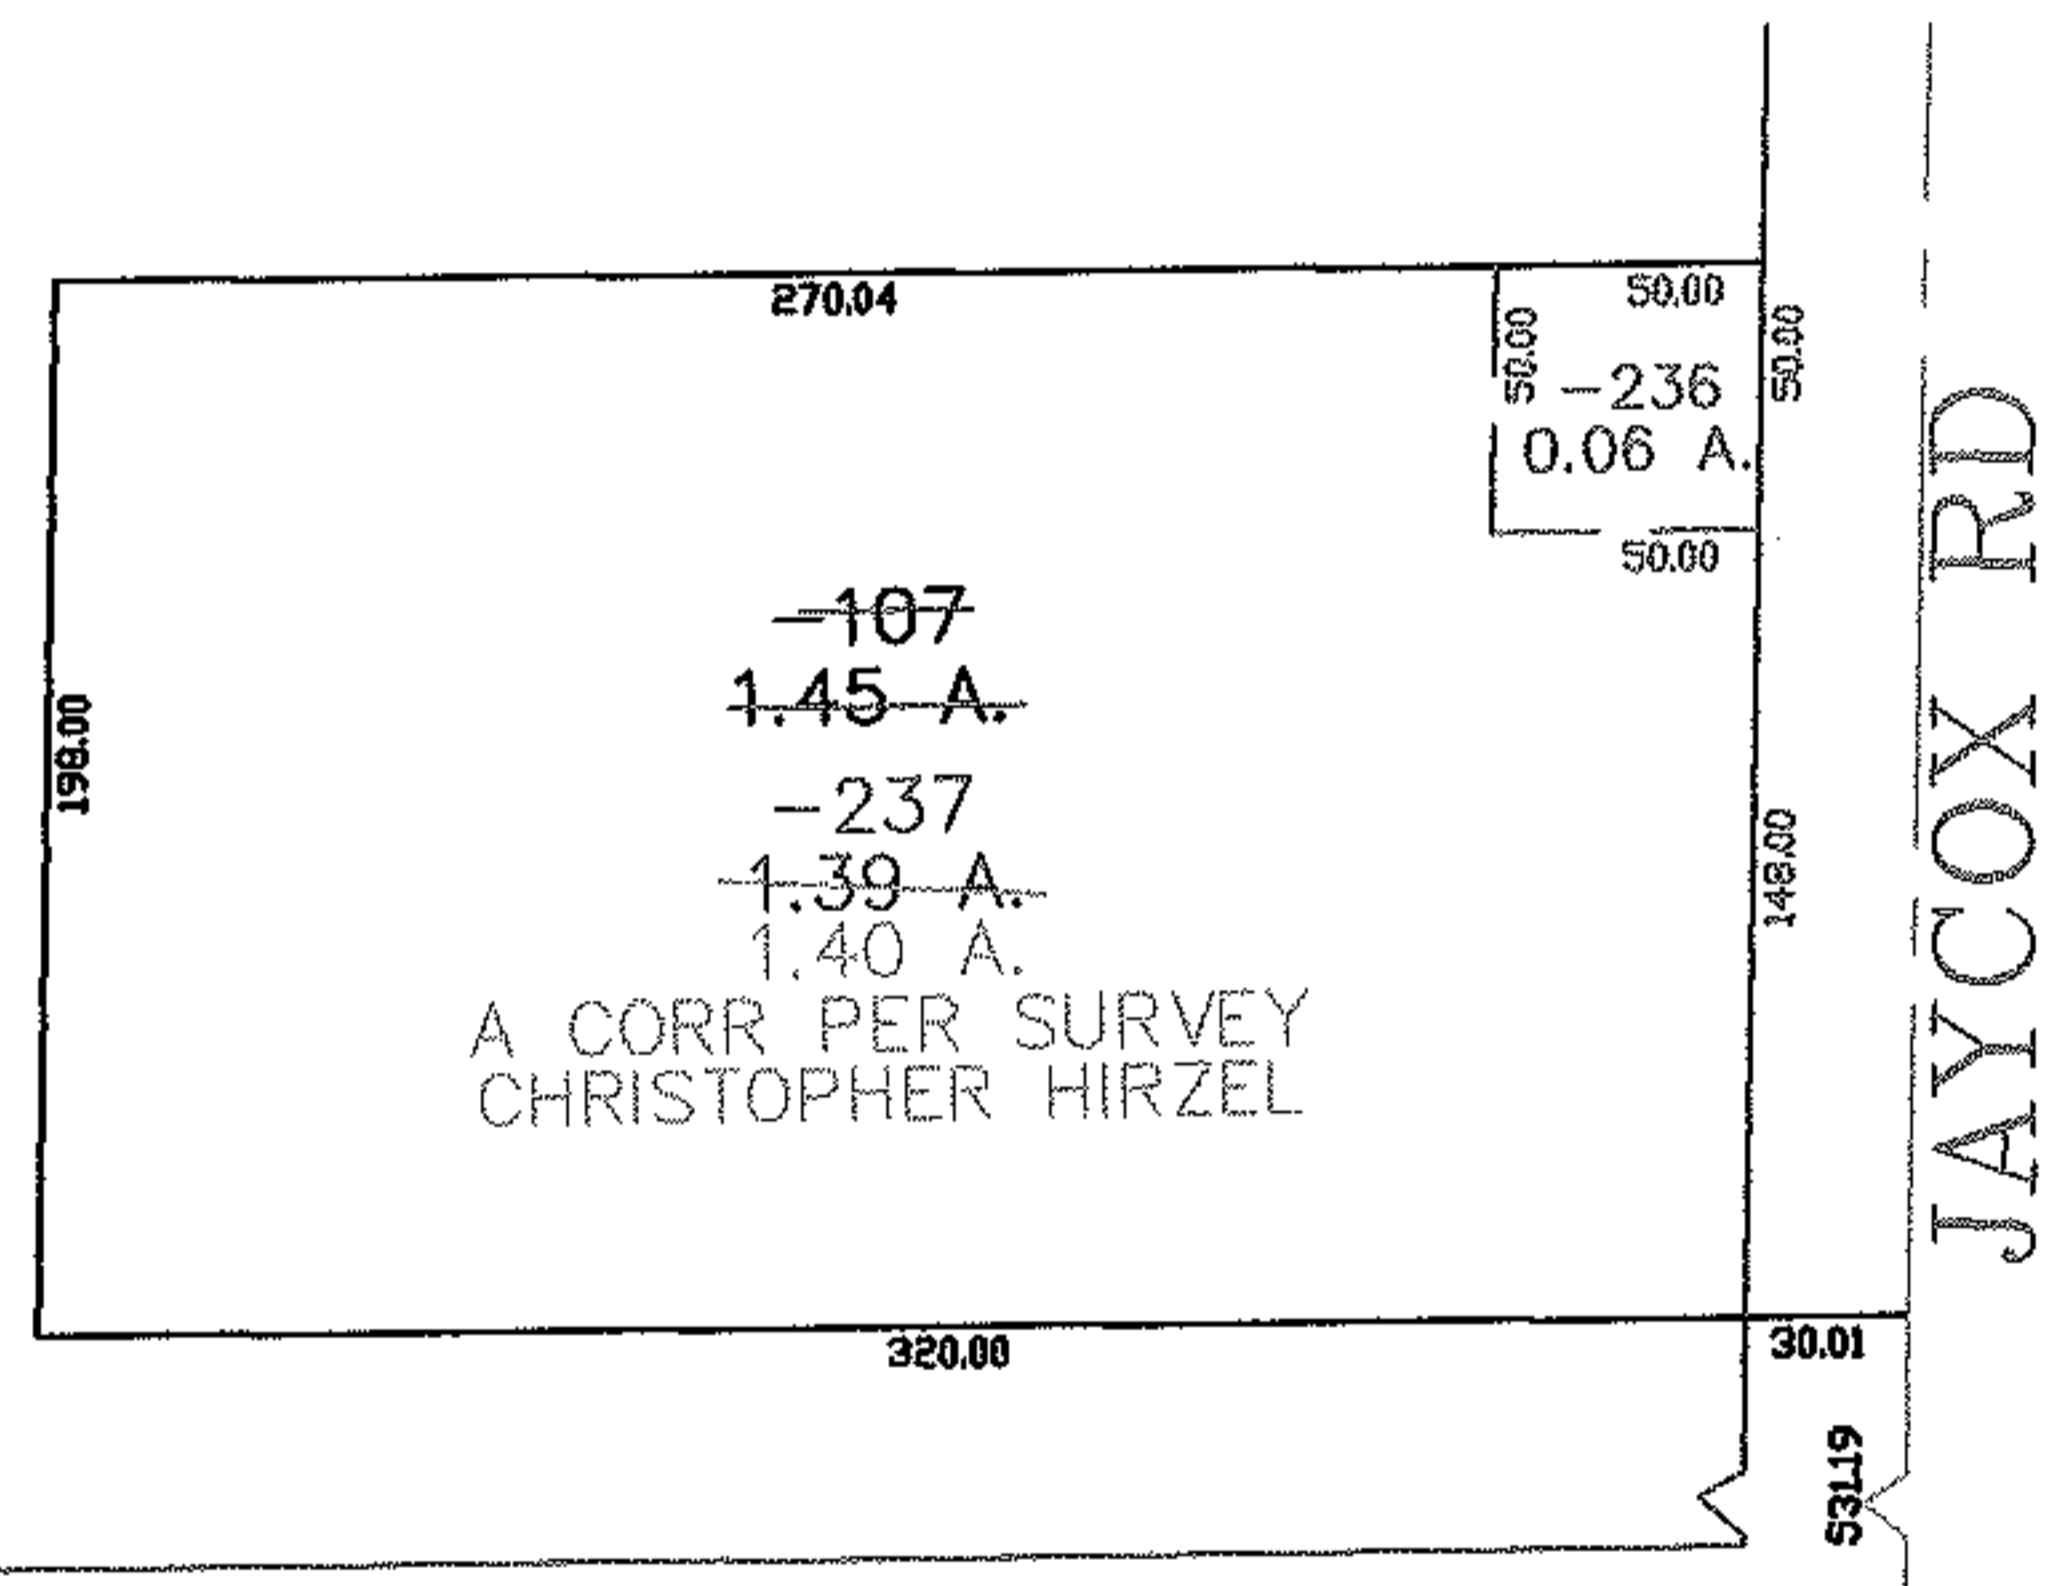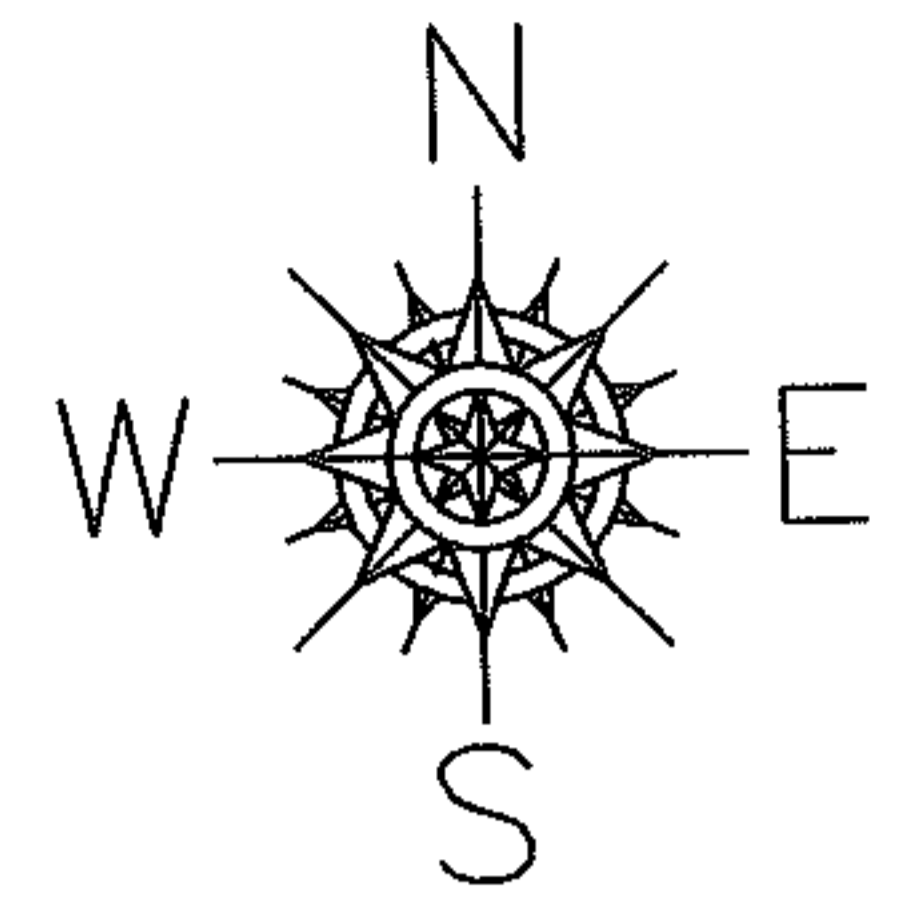

AVON COMMERCE PKWY

SPLITS/DEEDS PROCESSED

LORAIN COUNTY TAX MAP DEPARTMENT
226 MIDDLE AVE. ELYRIA, OHIO

SURVEYED BY: CHRISTOPHER HIRZEL

CLOSURE: 0.00 : 10.000

MAP PAGE(S): 04-00-021-B

APPROVED BY: JAH DATE: 11-9-06

SCALE: 1" = 100 PRIOR INSTRUMENT: DV 1226/165