
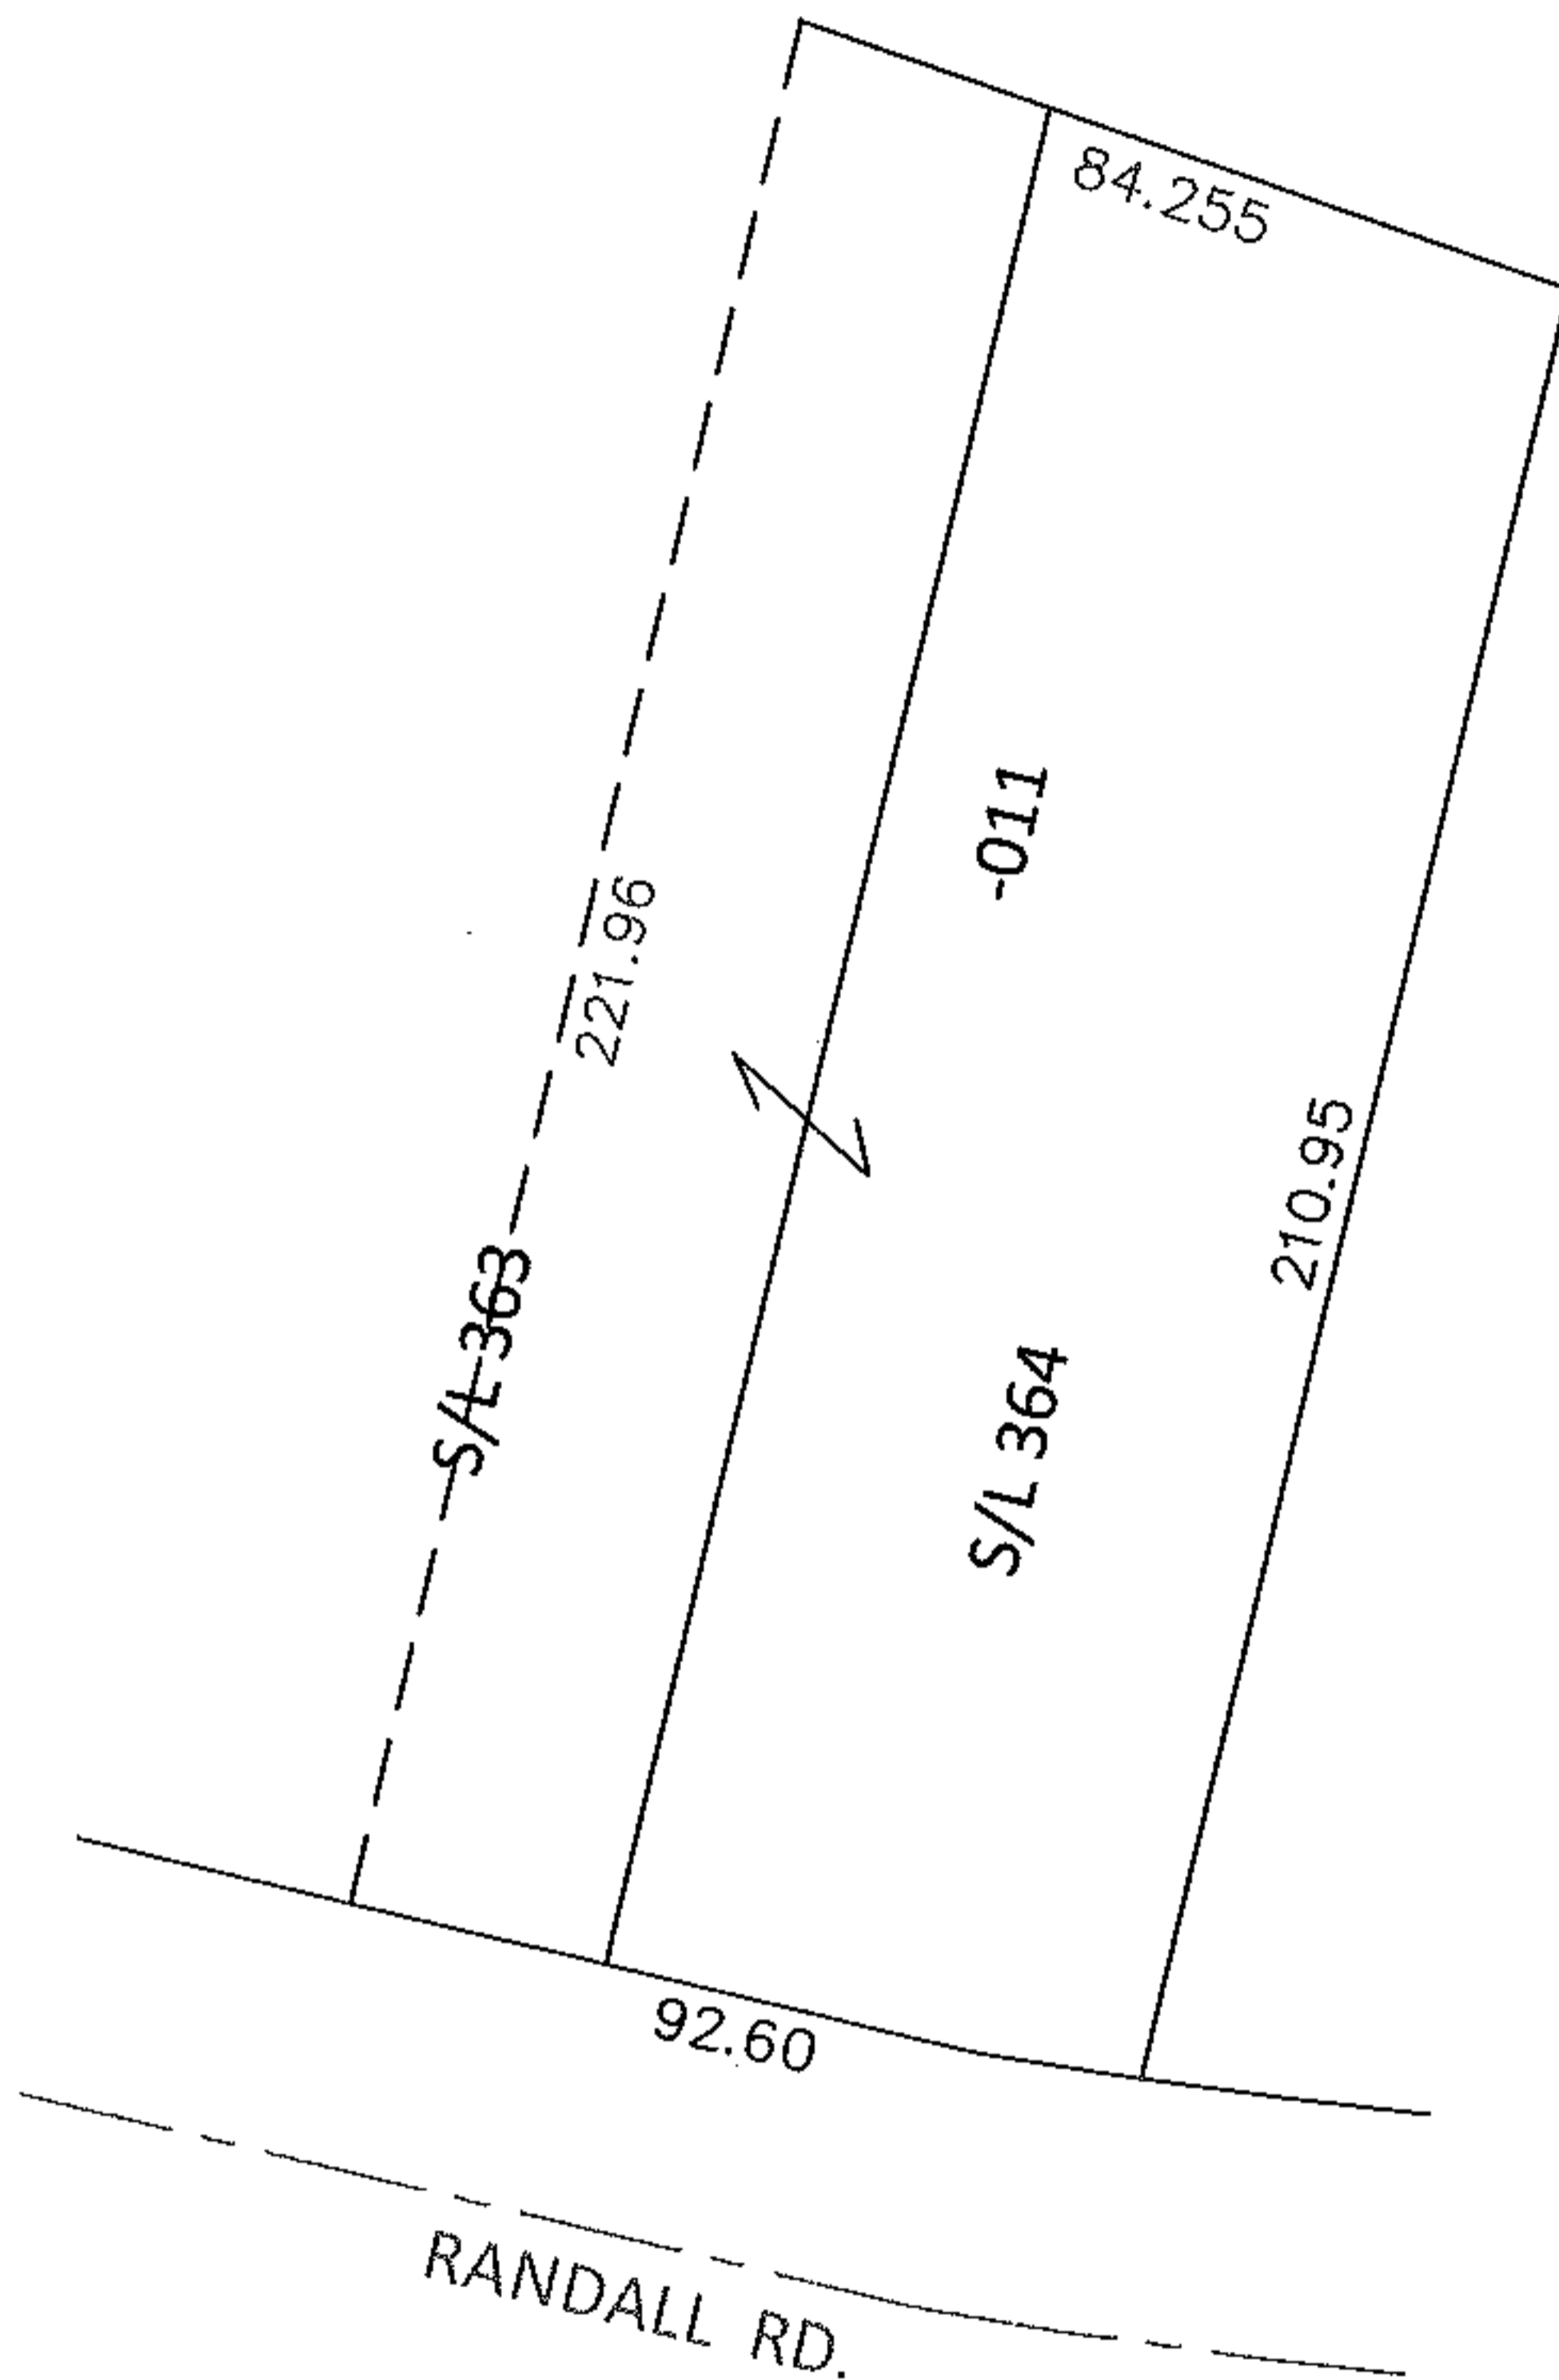


PARENT PARCEL: 06-25-031-105-011

CHILD PARCEL:

STARTING POINT: SOUTHEAST CORNER OF S/L 364 IN SPRING VALLEY SUB. NO.4(VOL.13 PG.7)

11-02264-C

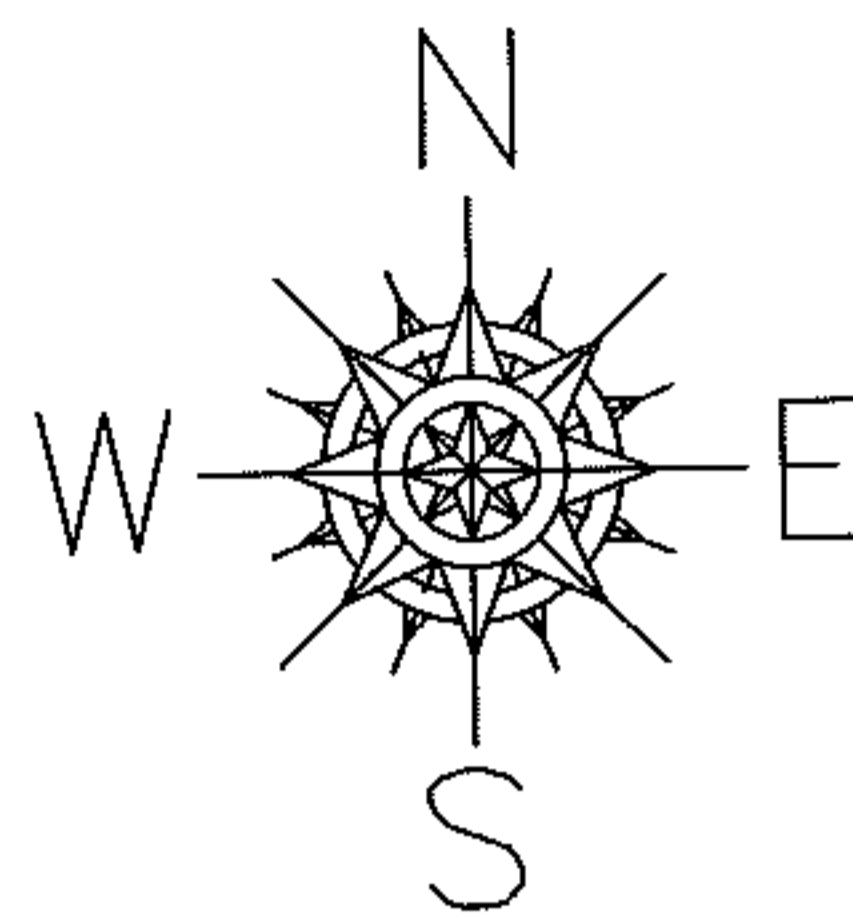


DEPTH CORRECTION

06-25-031-105-011

221.96

96.20 X ~~226~~

CORR. PER PRIOR DEEDS

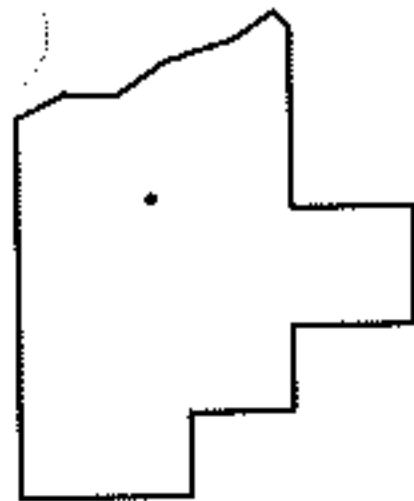

SPLITS/DEEDS PROCESSED

LORAIN COUNTY TAX MAP DEPARTMENT
226 MIDDLE AVE. ELYRIA, OHIO

SURVEYED BY: N/A

CLOSURE: N/A

MAP PAGE(S): 6-69

APPROVED BY: RRM DATE: 3-14-13

SCALE: 1"= 50' PRIOR INST.: 20120408773